


PROJECT DESCRIPTION AND LOCATION

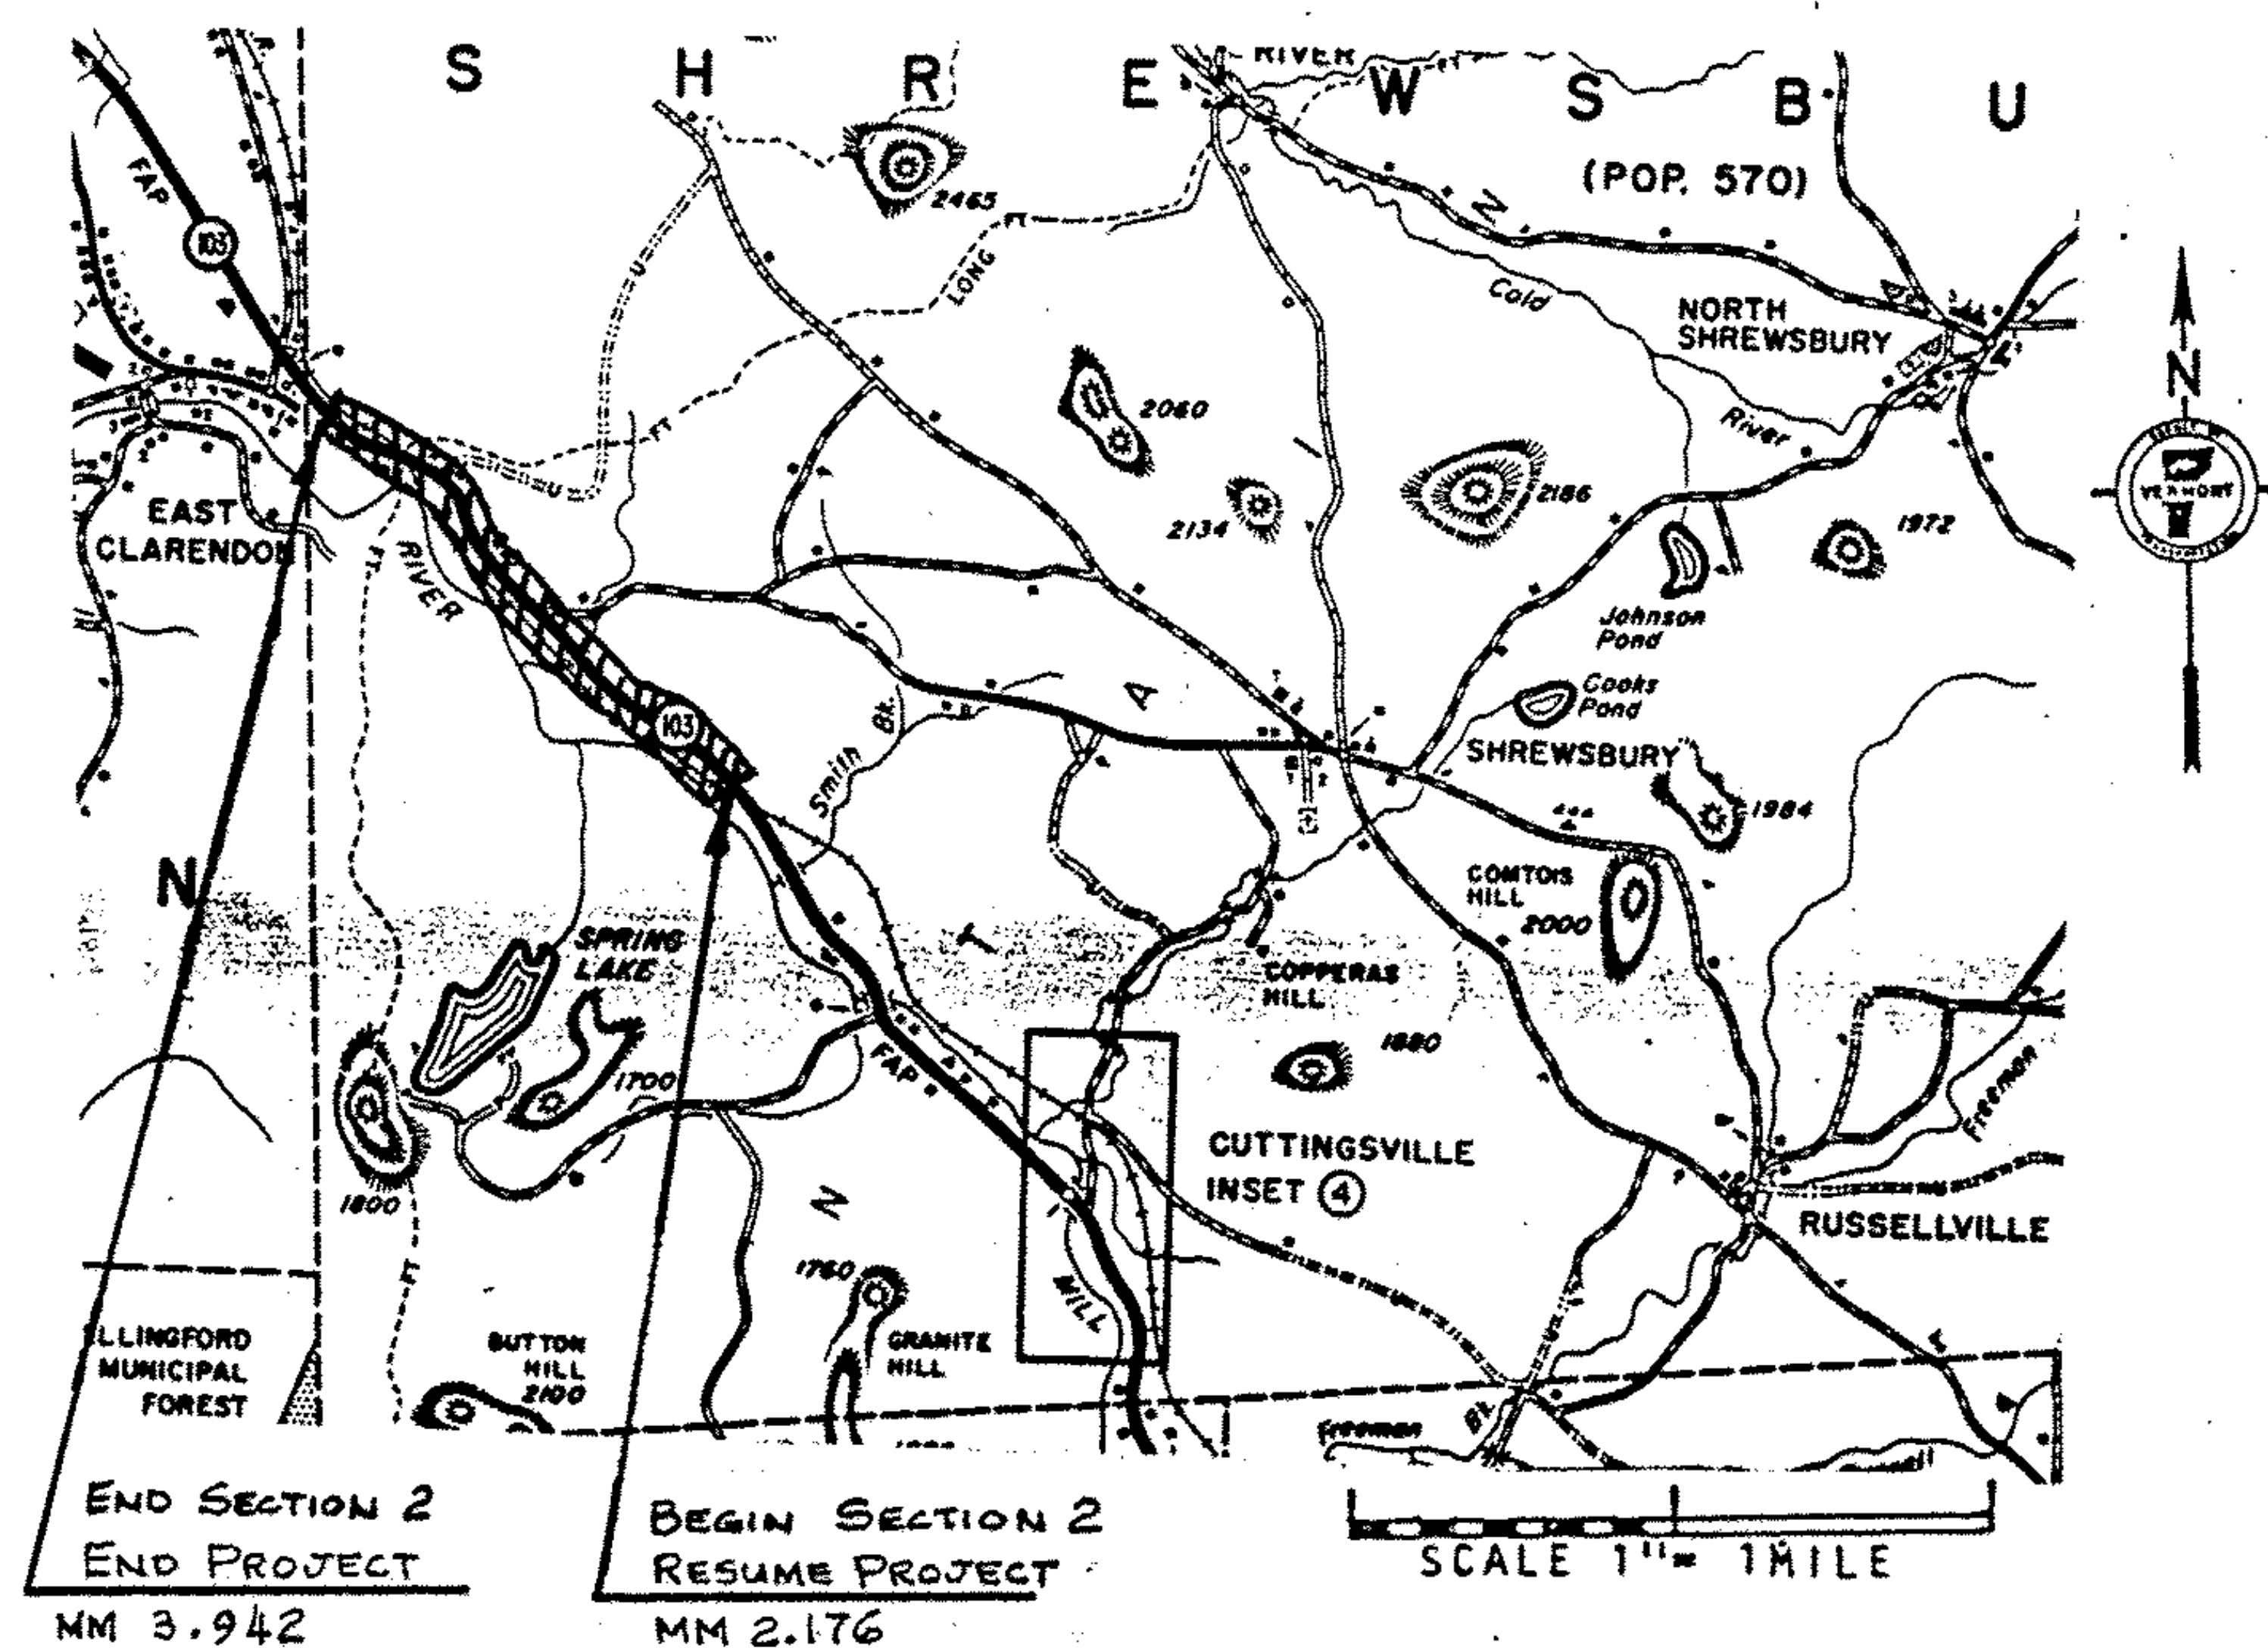

SECTION 2

ON VT 103-BEGINNING IN THE TOWN OF SHREWSBURY AT MM 2.176 AND
EXTENDING 1.766 MTLES TO MM 3.942

LENGTH OF PROJECT	
SECT. 1	3.349 MILES 17683 FEET
SECT. 2	1.766 MILES 9325 FEET
PROJECT TOTAL	5.115 MILES 27008 FEET

LUDLOW - MT. HOLLY -
PROJECT SHREWSBURY

NO. F025-1(26)S
SHEET 2 OF 24 SHEETS