


TYPICAL SECTIONS & DESIGN DATA

ITEM 406.25 BITUMINOUS CONCRETE PAVEMENT
LEVELING COURSE TYPE III OR IV (545 TONS/MILE)
AS DIRECTED BY THE ENGINEER
1" WEARING COURSE TYPE III

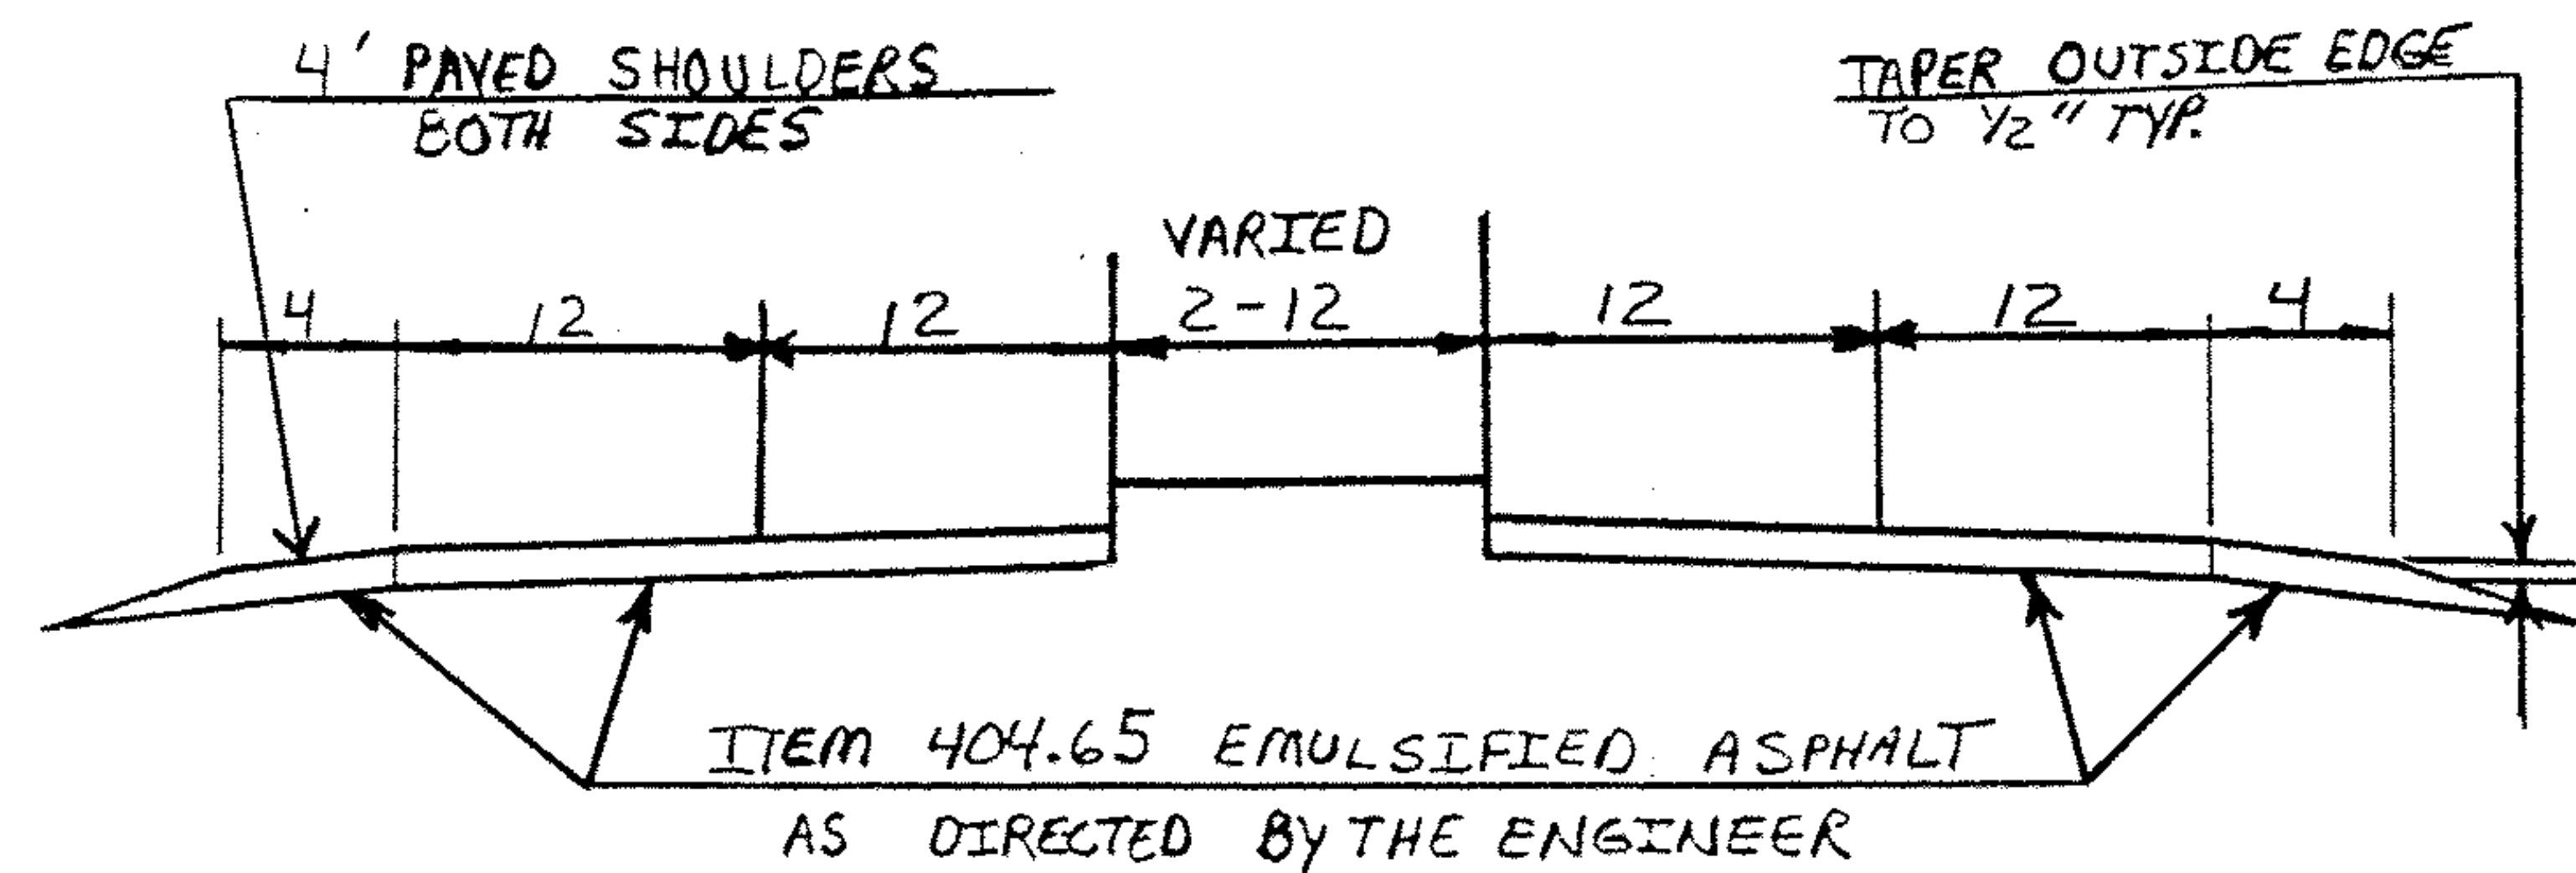

LUDLOW Vt. 103 MM 4.059 ~ MM 4.250

1982 ADT 3130

V = 50