


PROJECT DESCRIPTION AND LOCATION

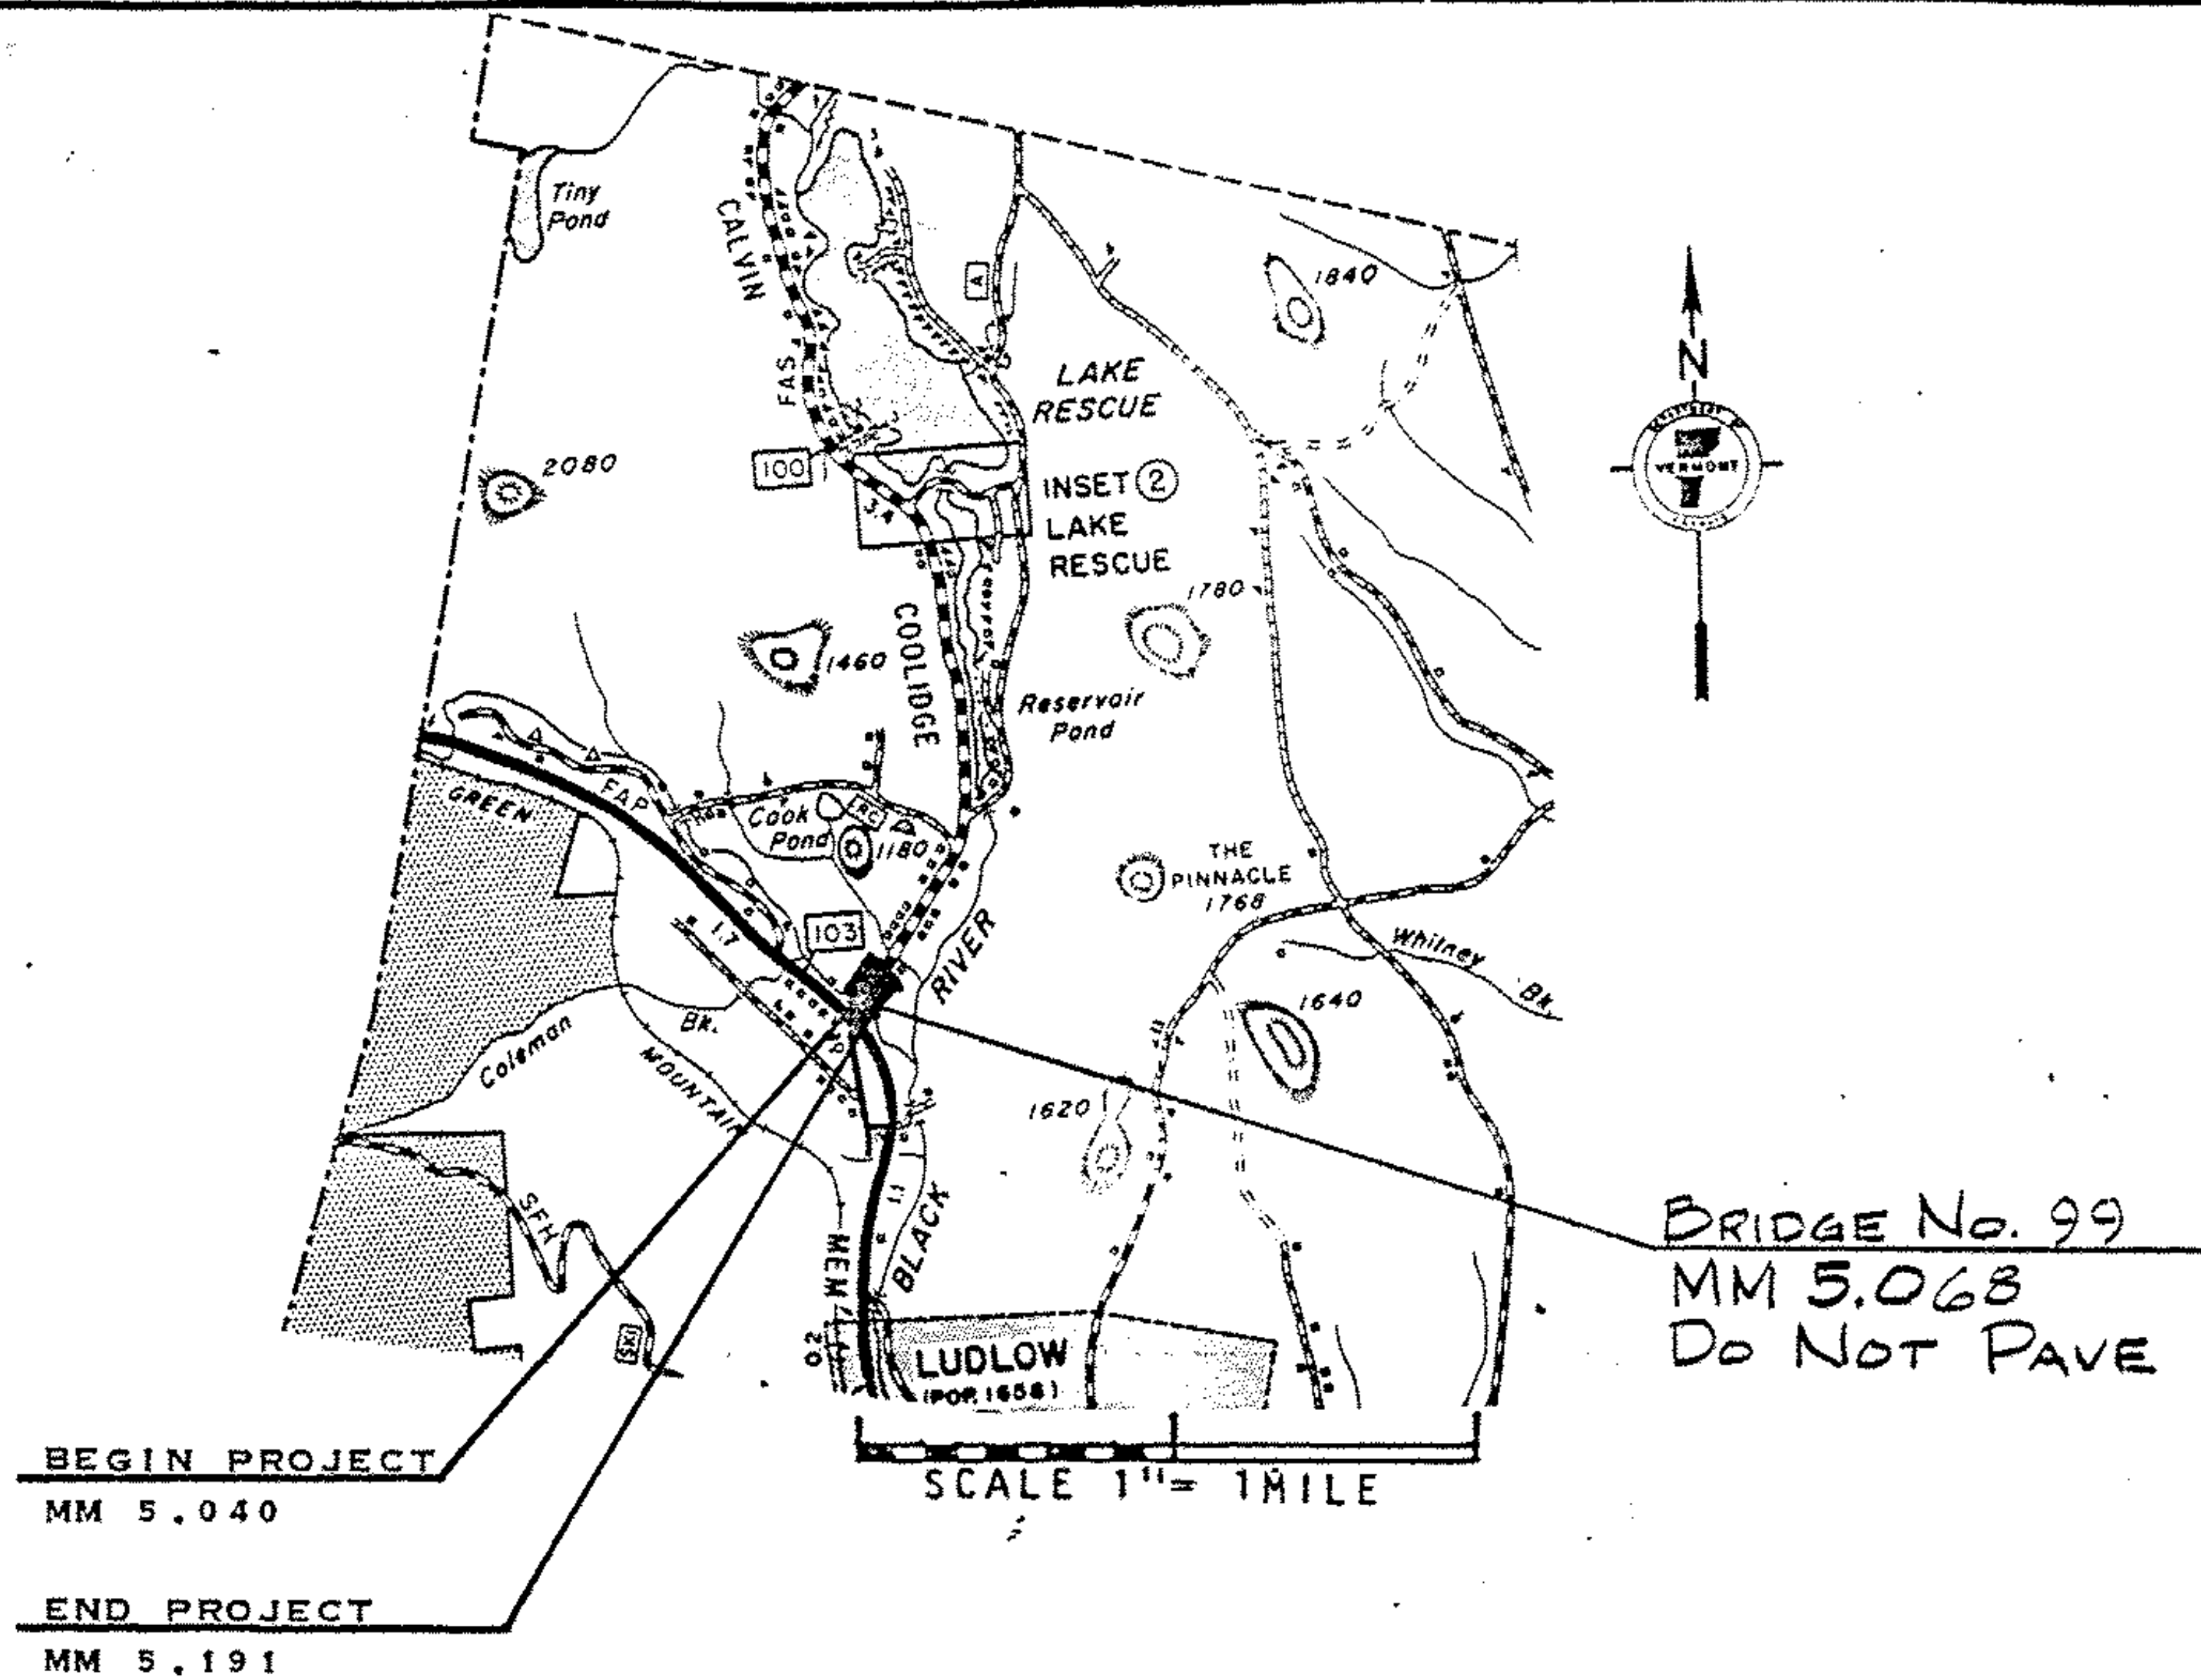

VT-100 BEGINNING AT THE JUNCTION OF VT 103 AND VT 100 AT MM 5.040
AND EXTENDING NORTHERLY 0.151 MILE TO MM 5.191

LENGTH OF PROJECT
0.151 MILES
797 FEET

PROJECT LUDLOW

NO. E-013-3(3)S

SHEET 4 OF 21 SHEETS