


DETAILS

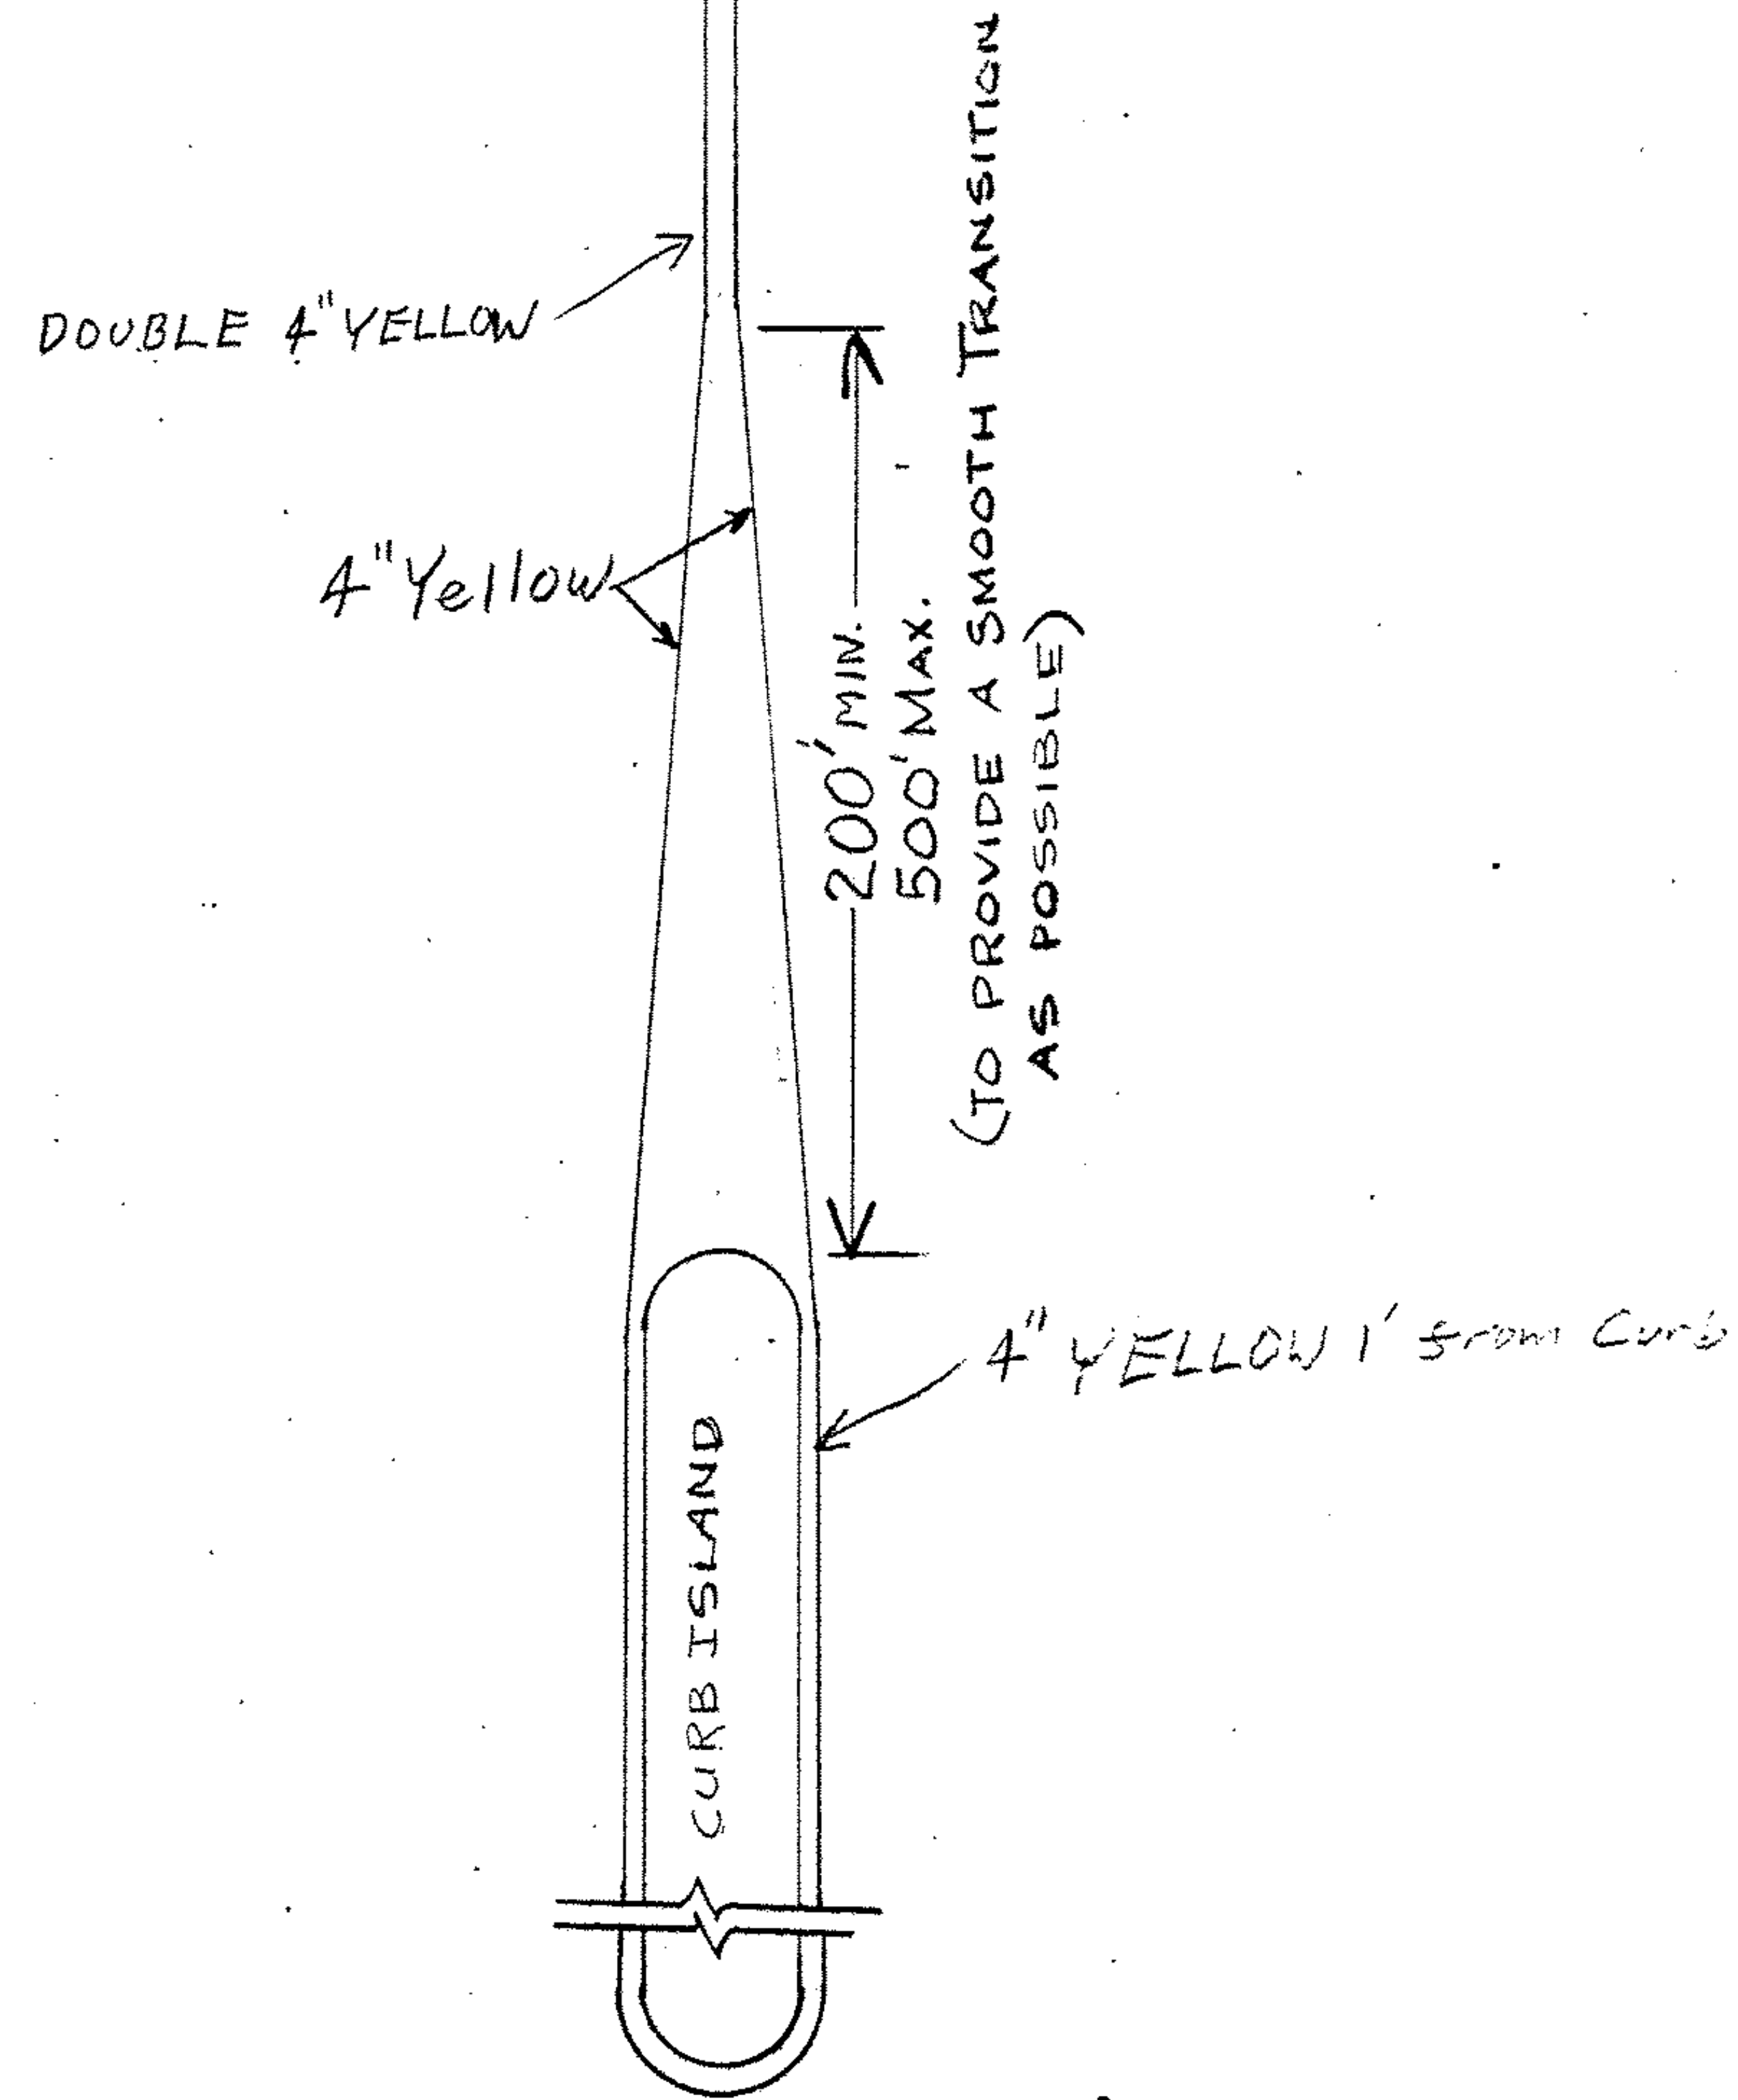

PROJECT LUDLOW

NO. F-013-3(3)S

SHEET 8 OF 21 SHEETS