


PROJECT DESCRIPTION AND LOCATION

BRIDGE No. 103
MM 0.081
TOP COURSE ONLY
END PROJECT
MM 0.438
PLYMOUTH

BEGIN PROJECT
MM 5.191

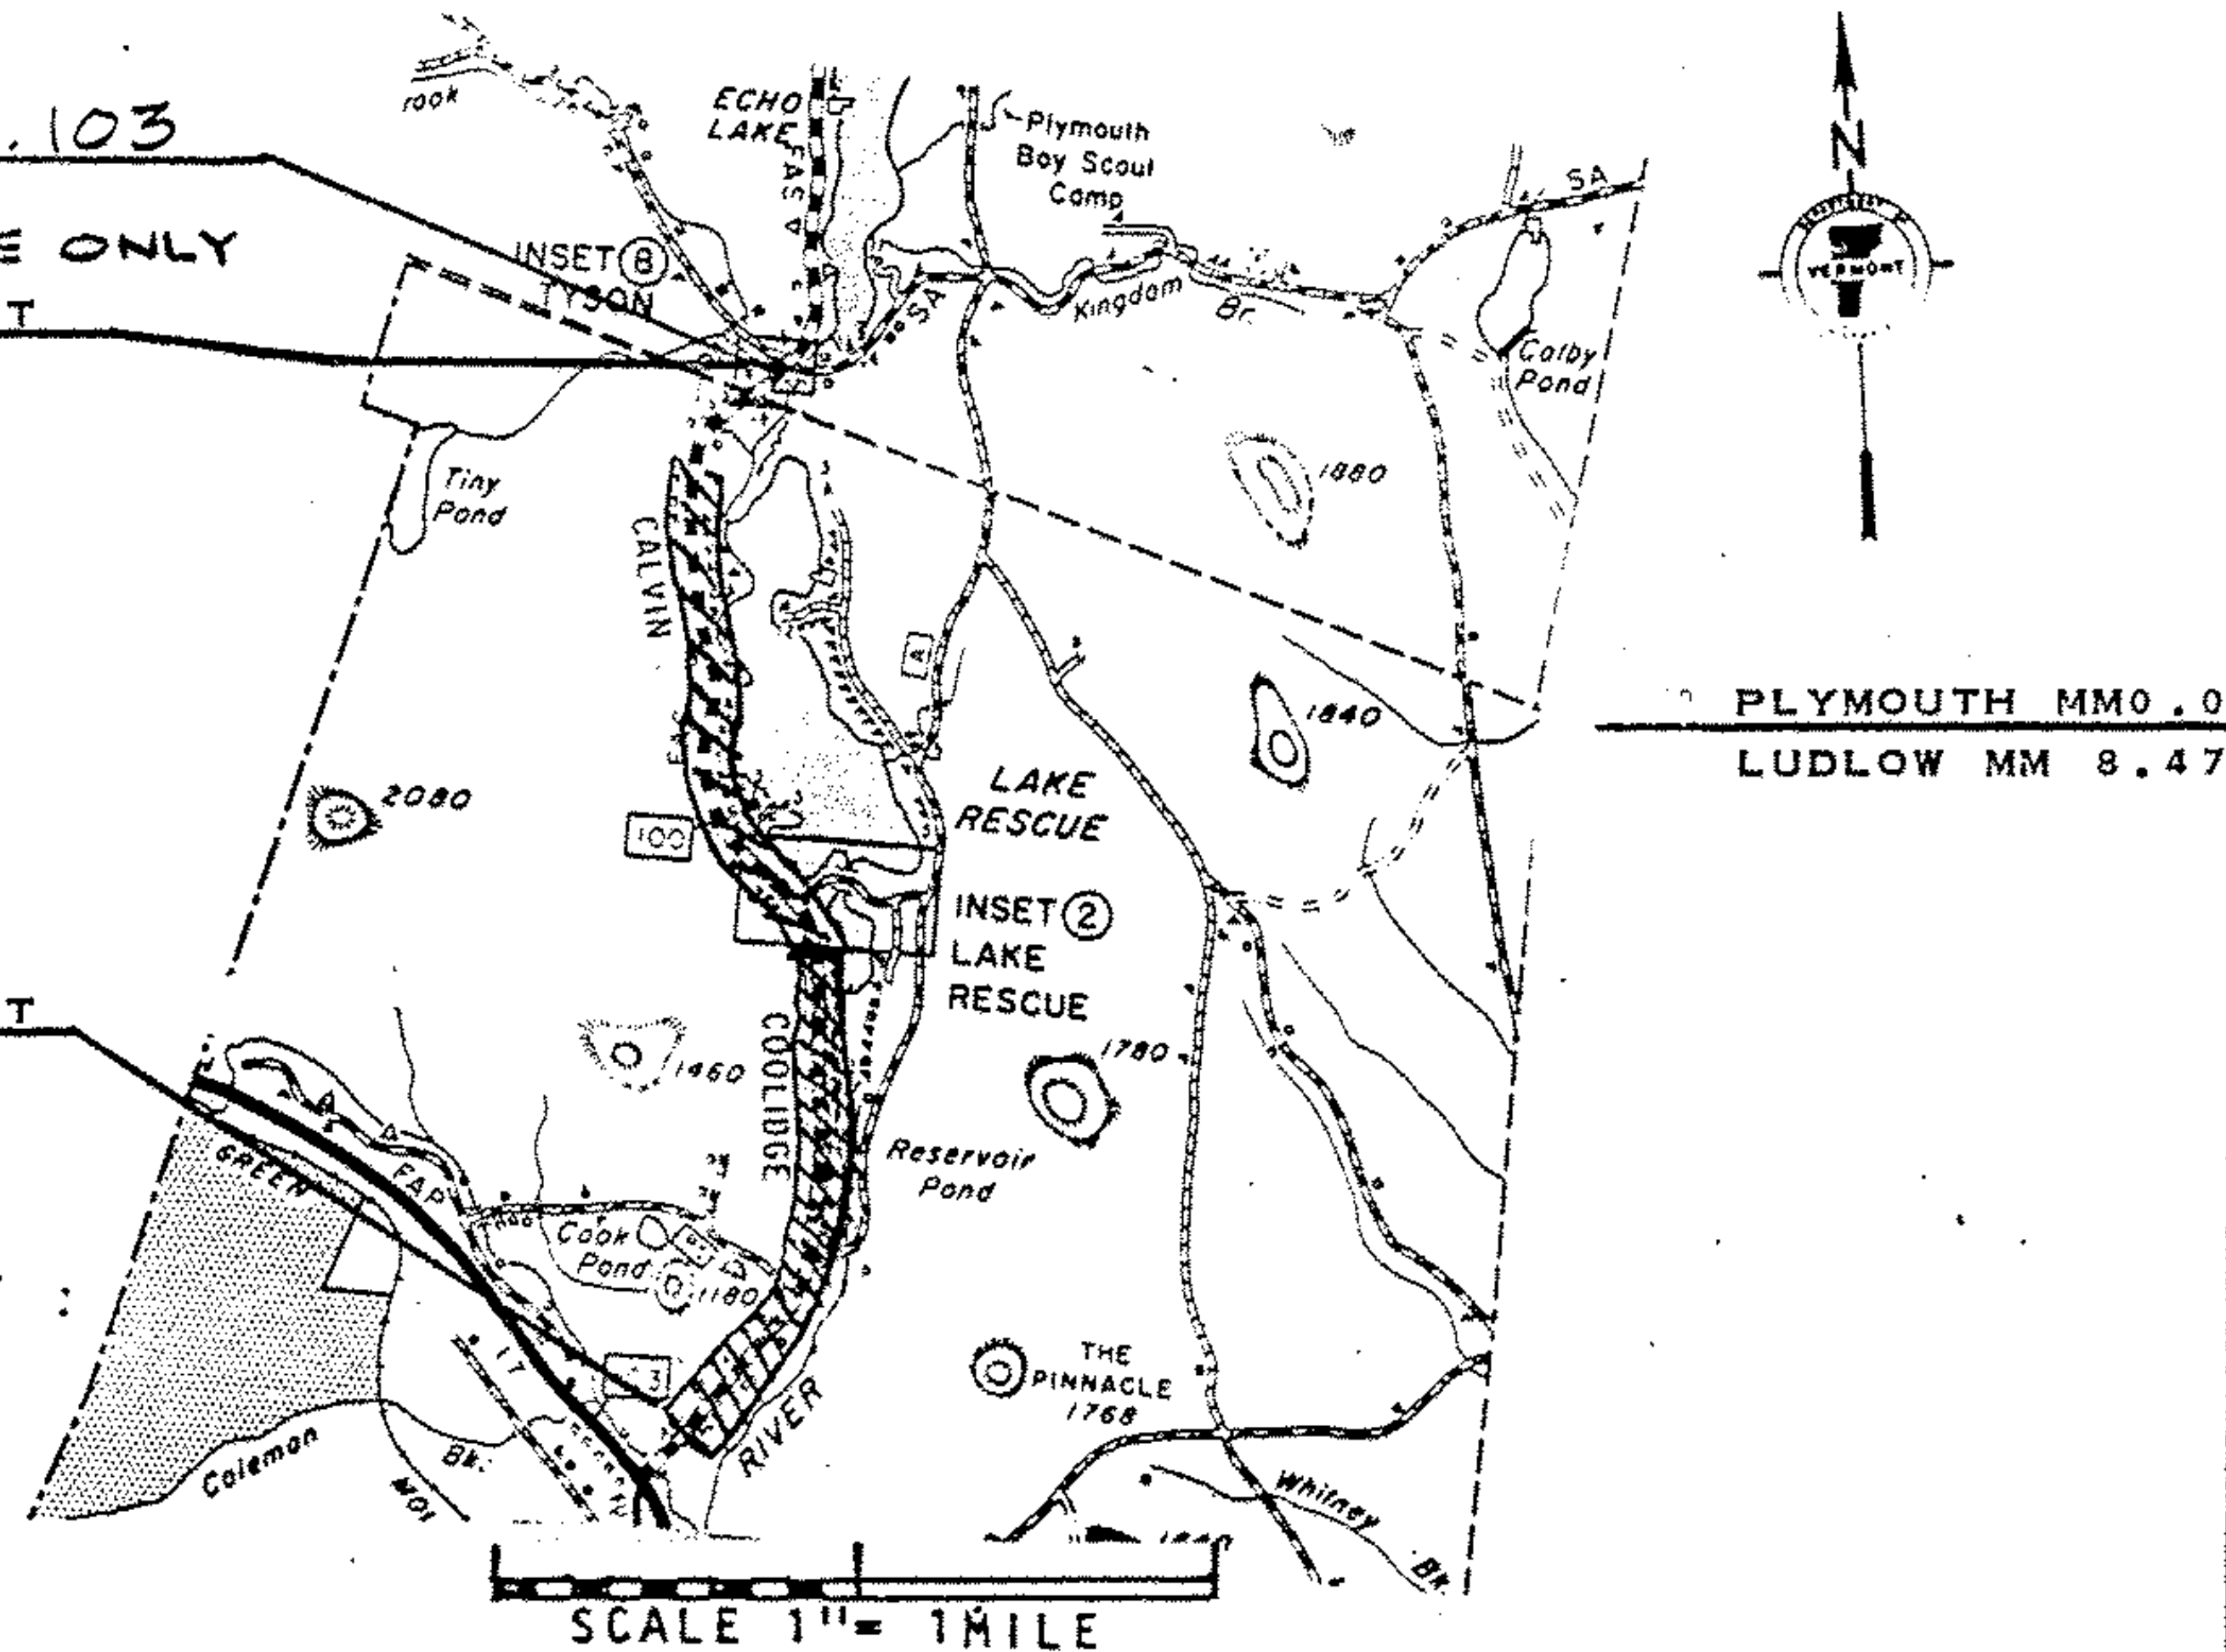

VT 100 BEGINNING IN THE TOWN OF LUDLOW AT MM 5.191 AND EXTENDING
3.418 MILES TO MM 0.138 IN THE TOWN OF PLYMOUTH

LENGTH OF PROJECT
3.418 MILES
18047 FEET

PROJECT LUDLOW_PLYMOUTH

NO. HMA 2631

SHEET 10 OF 21 SHEETS