


PROJECT DESCRIPTION AND LOCATION

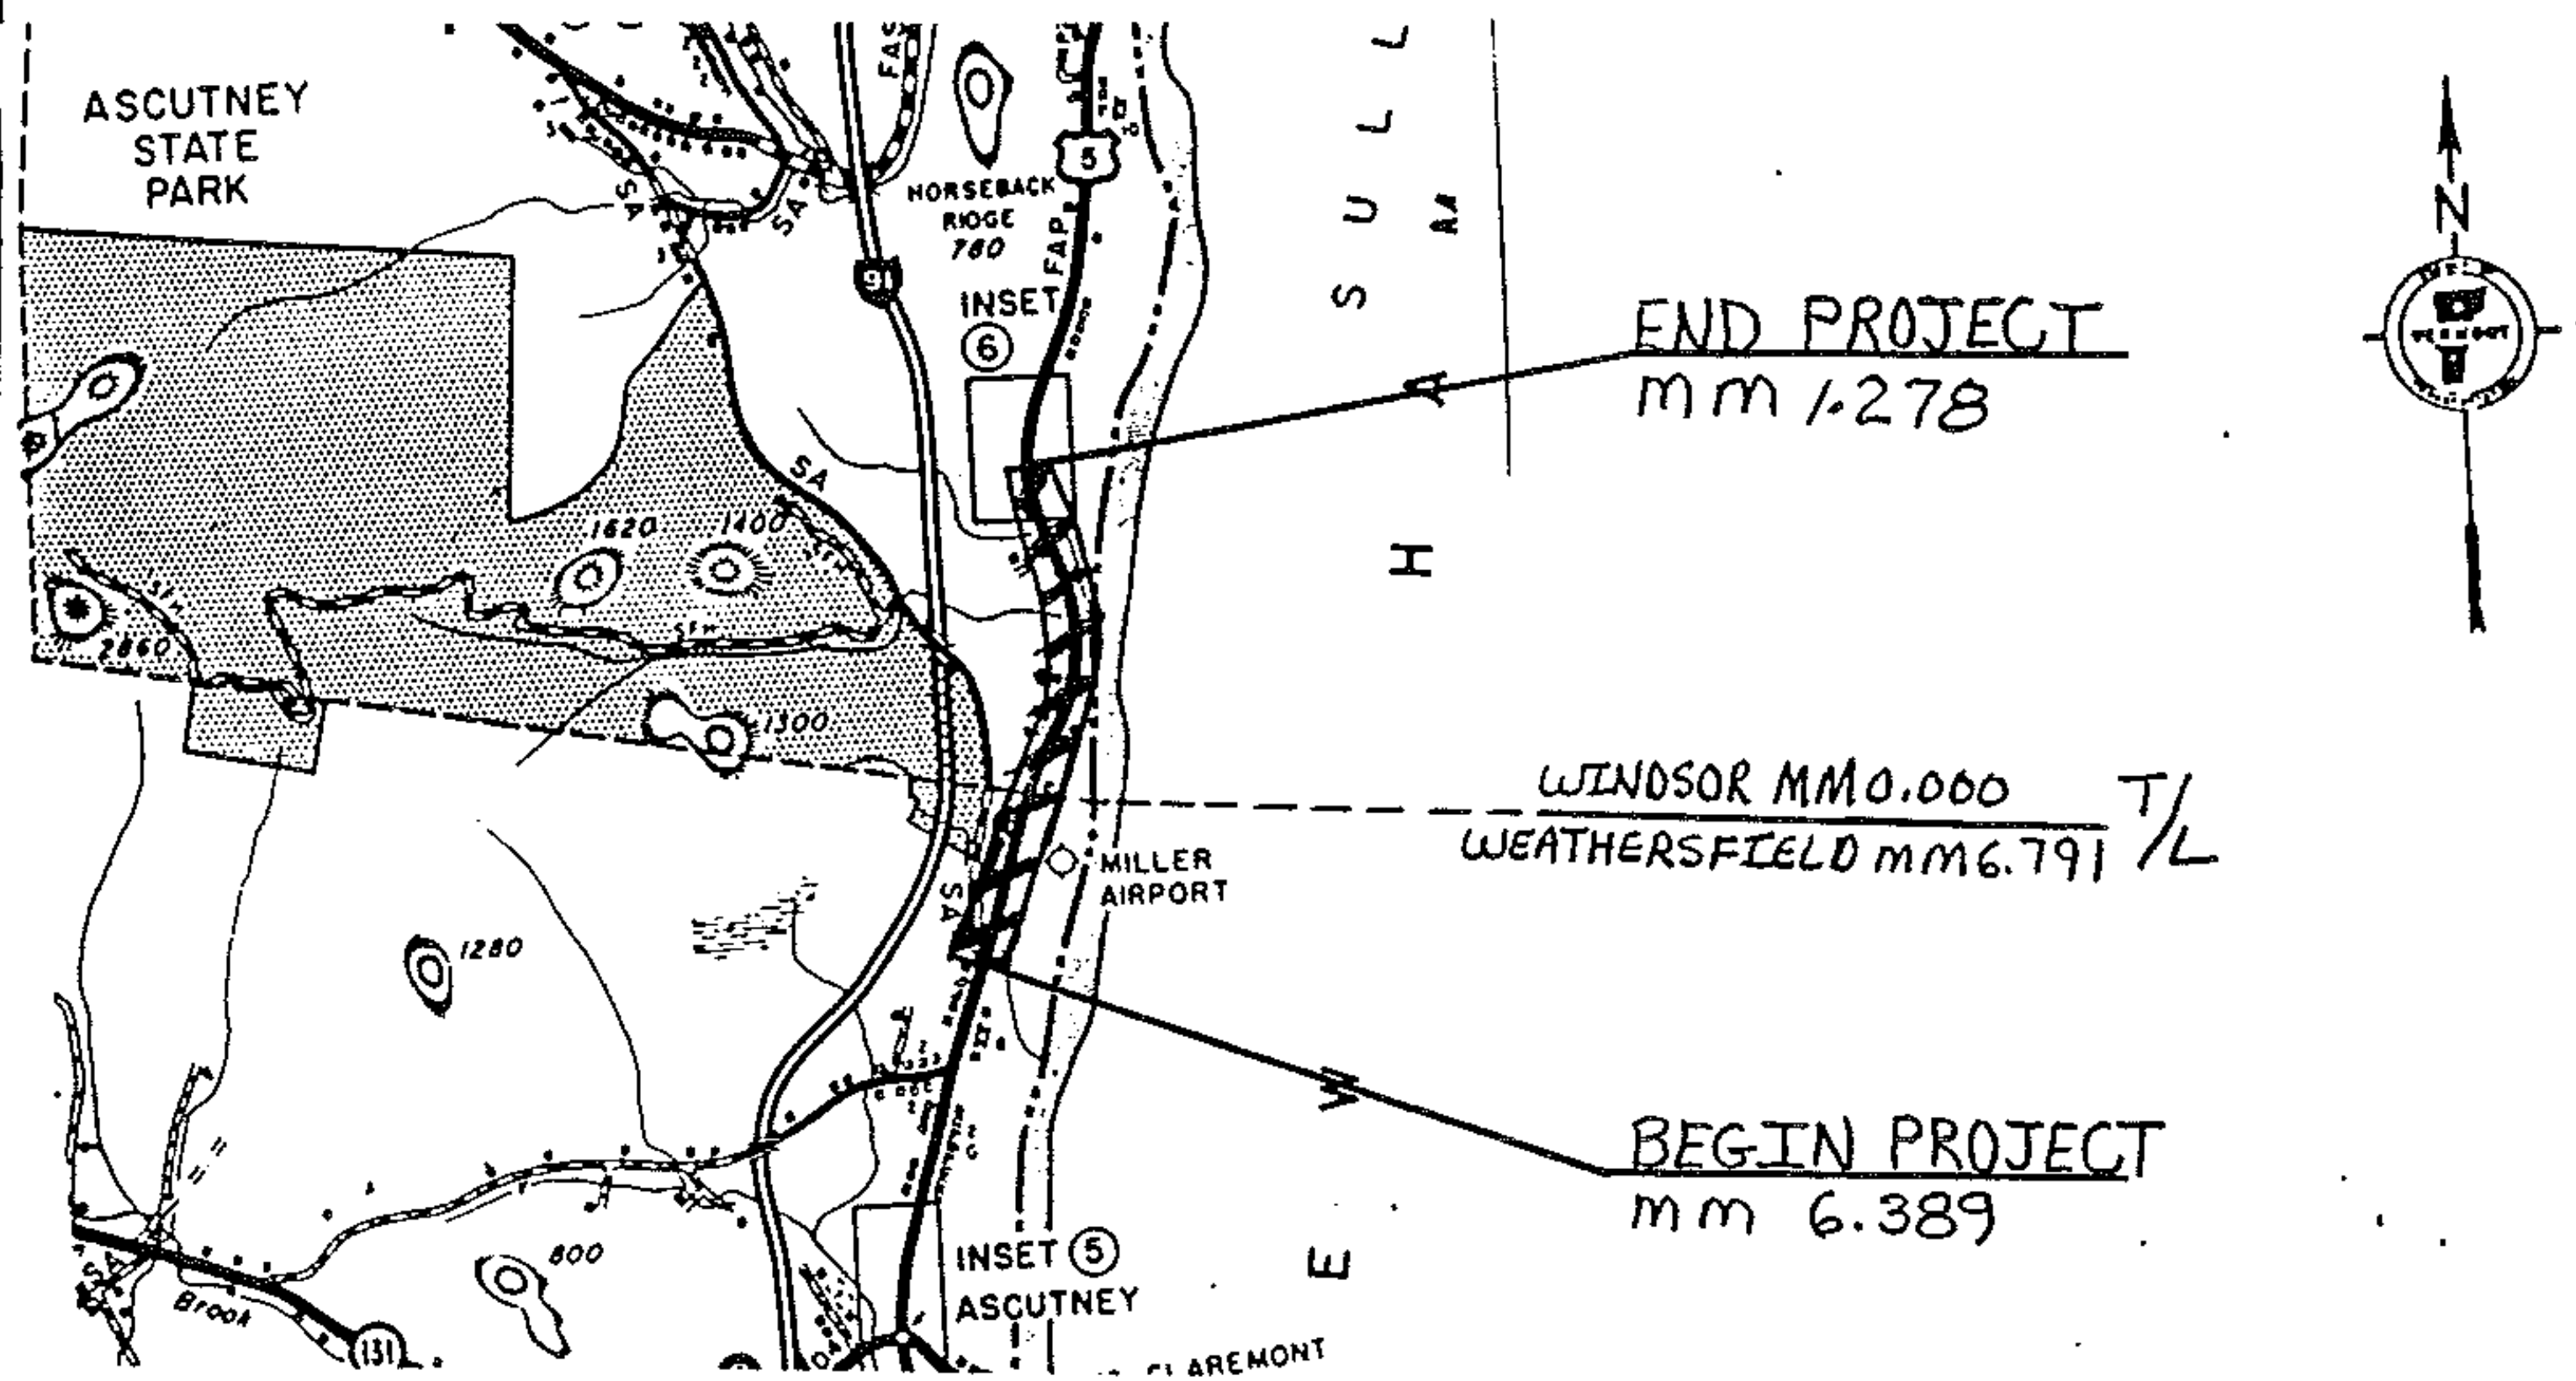

END PROJECT
mm 1.278

WINDSOR MM 0.000 T/L
WEATHERSFIELD MM 6.791 T/L

BEGIN PROJECT
mm 6.389

0
1
1 INCH REPRESENTS 1 MILE

ON US5 - BEGINNING IN THE TOWN OF WEATHERSFIELD AT
MM 6.389 AND EXTENDING 1.680 MILES NORTHERLY TO MM 1.278
IN THE TOWN OF WINDSOR.

LENGTH OF PROJECT
1.680 MILES
8870 FEET