


*Centerline treatment shall consist of a minimum of 400 feet of solid line in advance of the intersection and shall be paired with either a solid or dashed line depending on sight distance availability in the opposing lane.

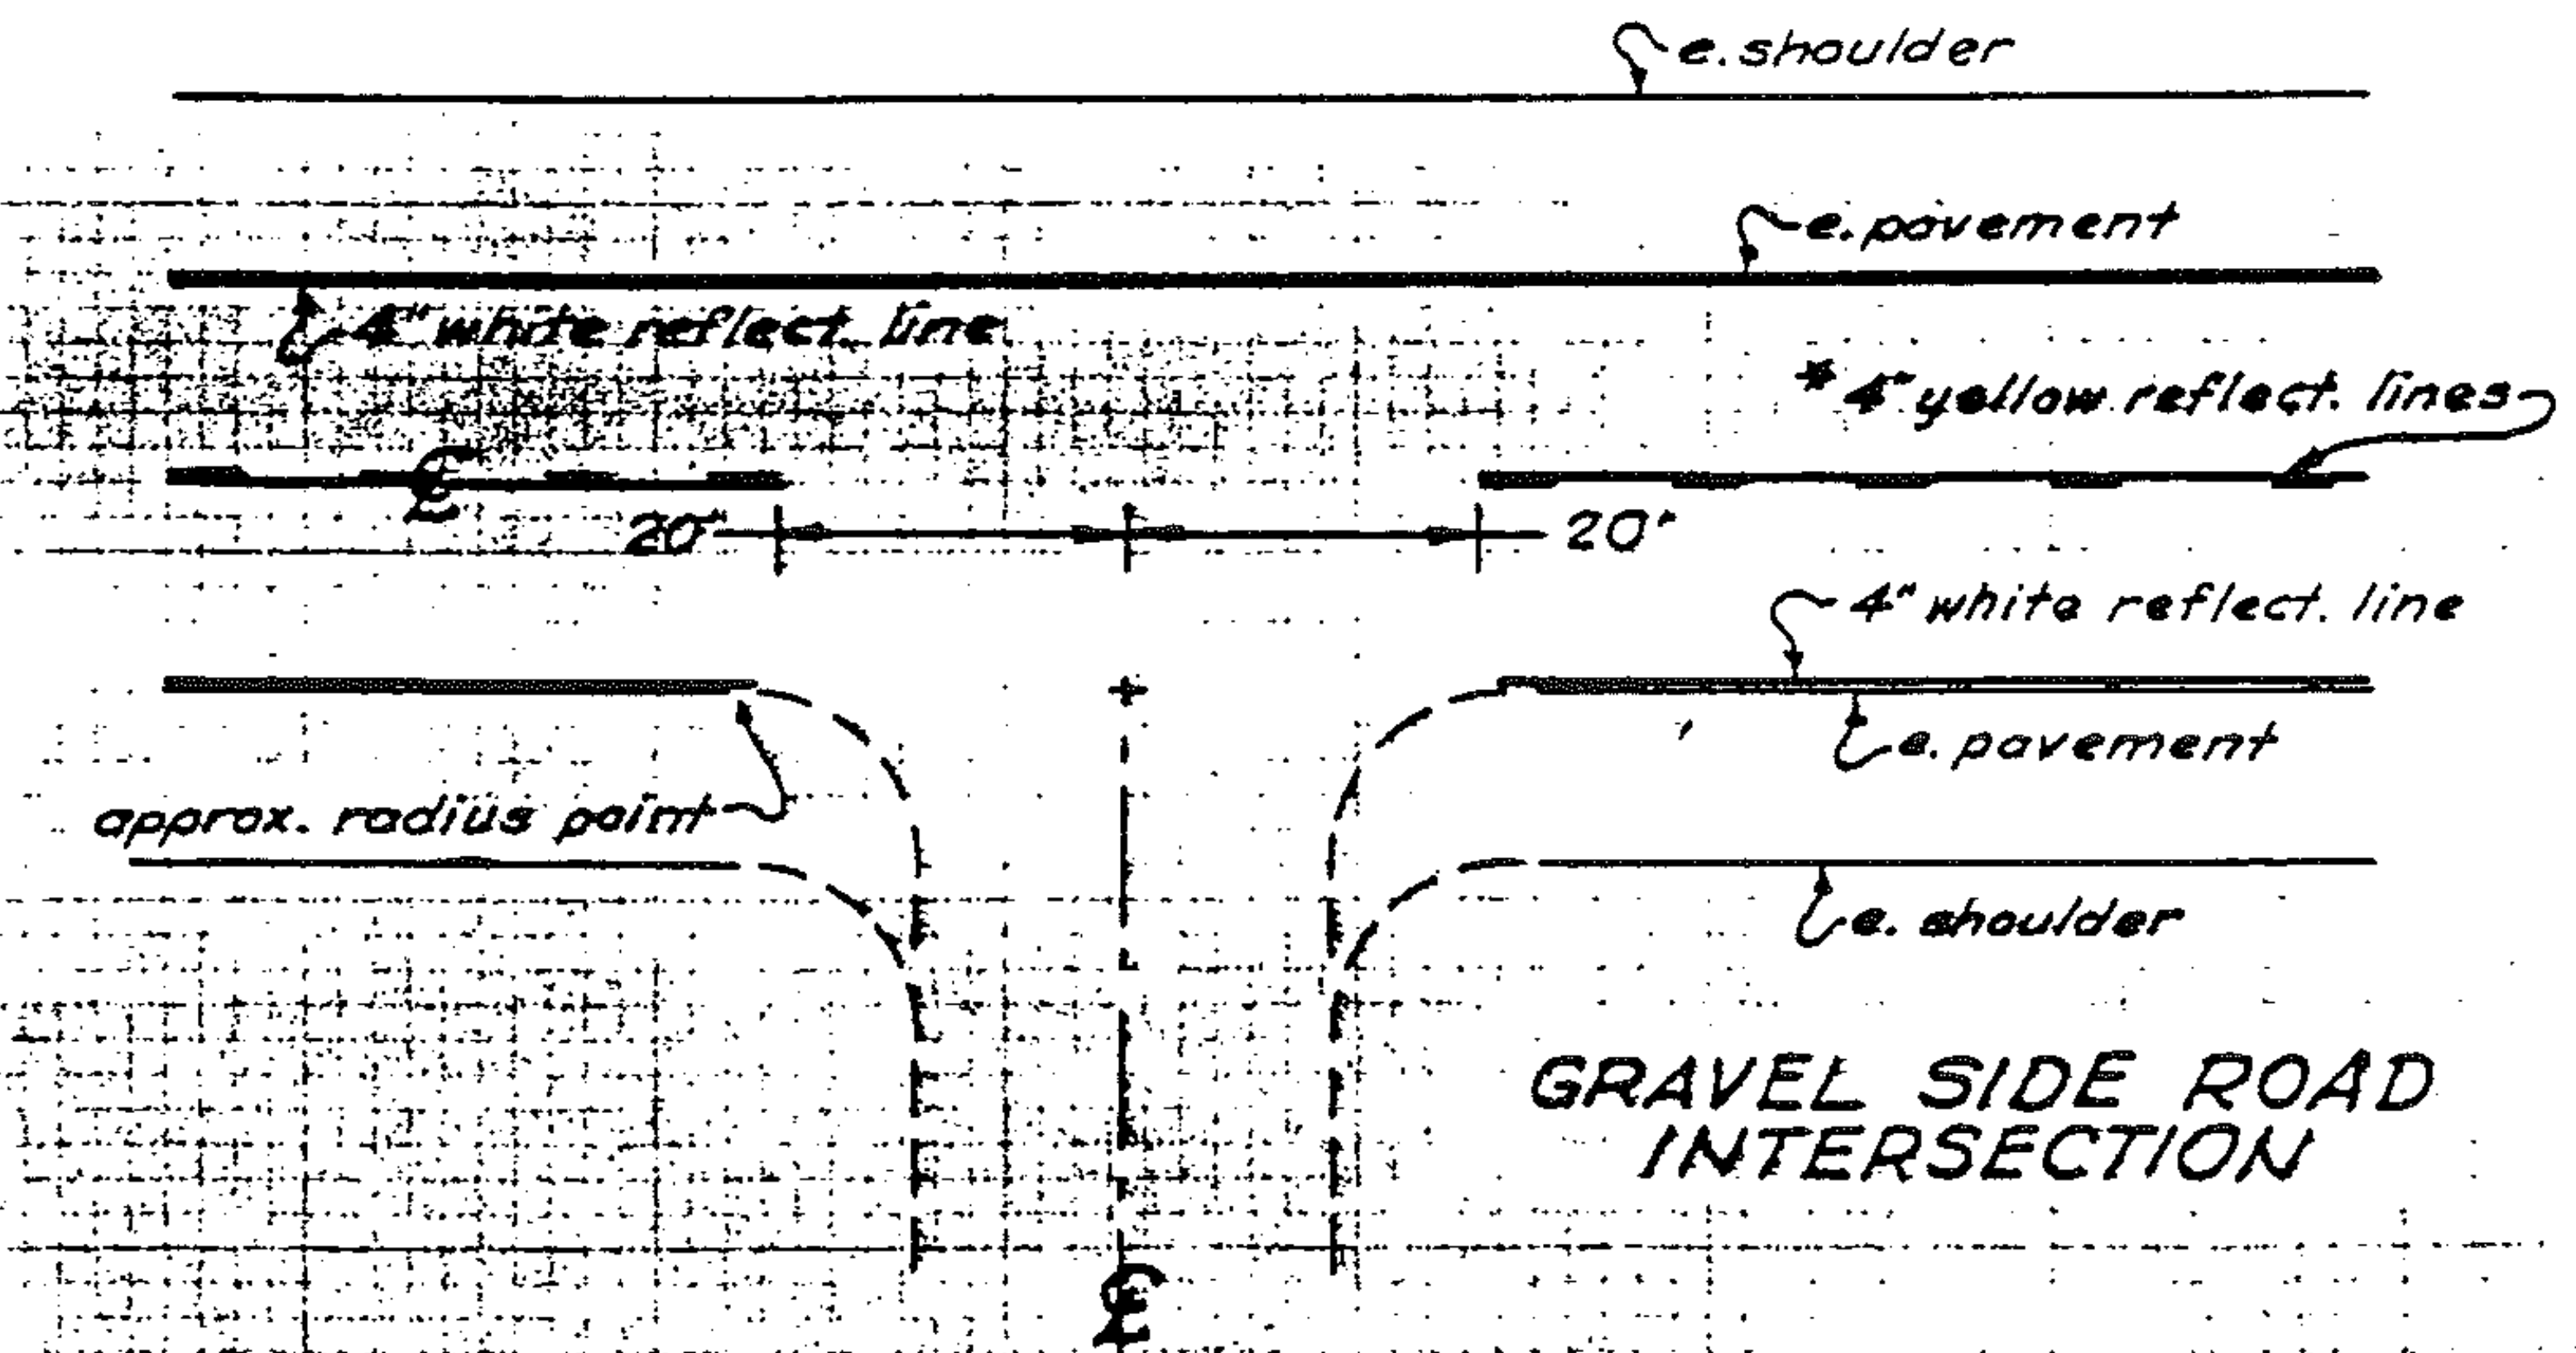

WEATHERSFIELD - WINDSOR
HARTLAND - WOODSTOCK
HMA 2645 HMA 2616 HMA 2617