


# PROJECT DESCRIPTION AND LOCATION

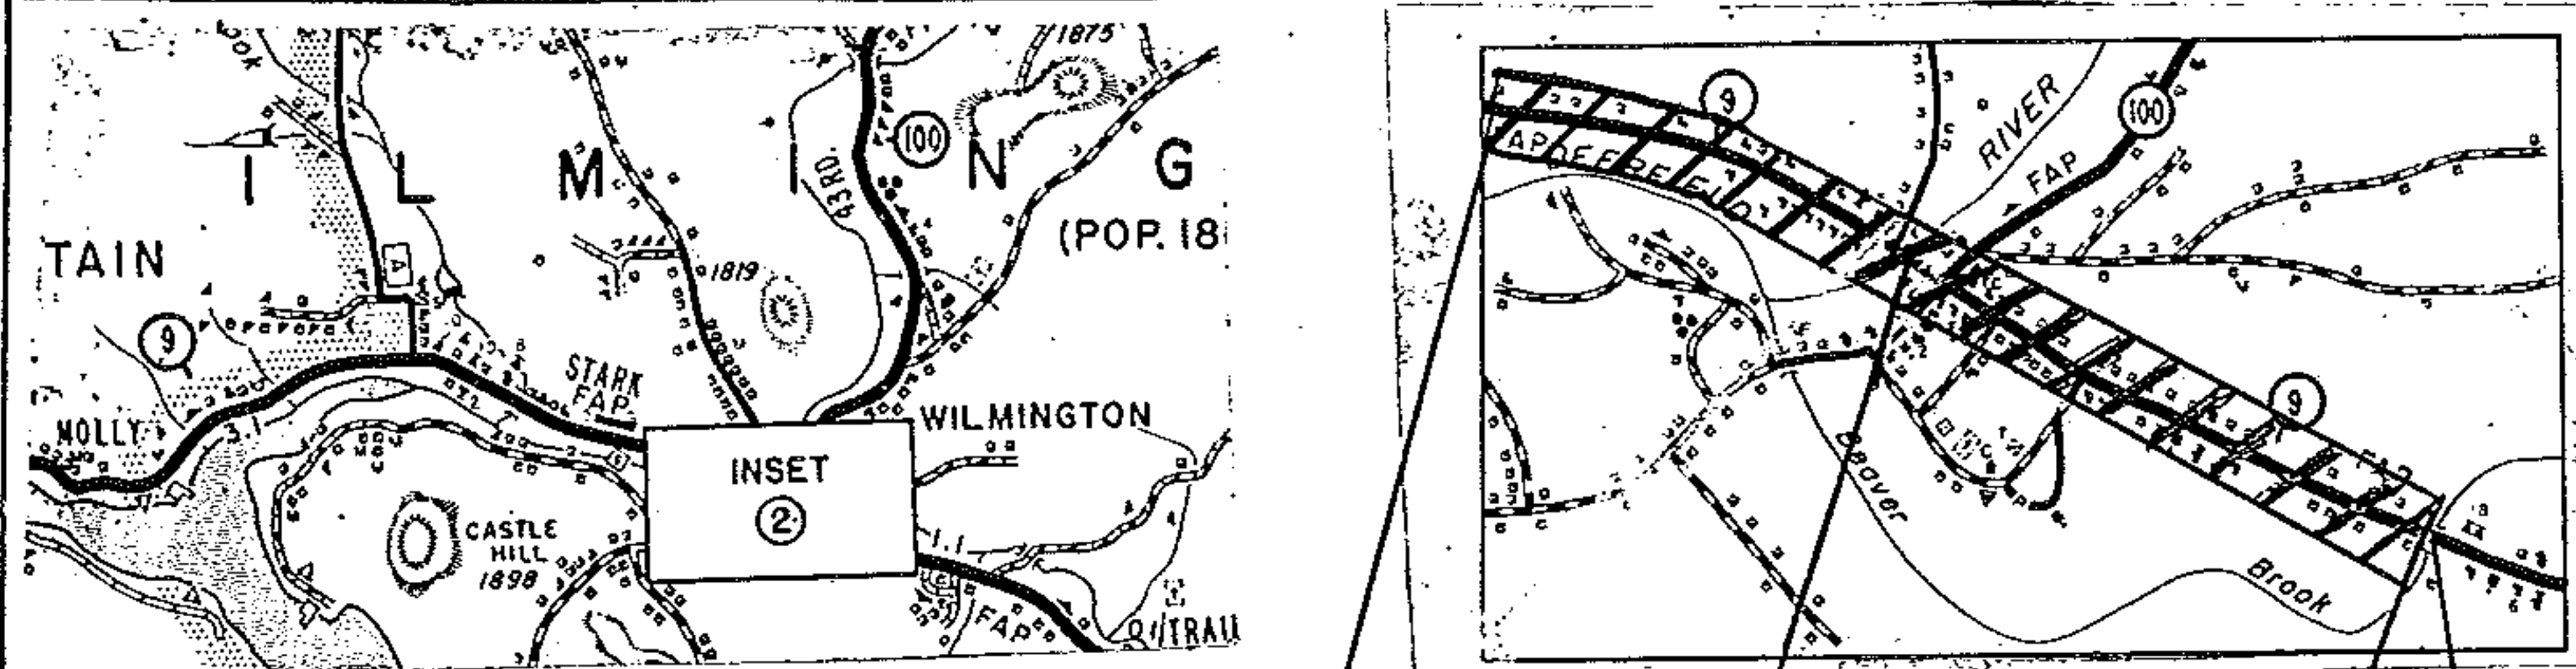


MM 2.640  
BEGIN PROJECT

INSET 2  
WILMINGTON  
SCALE:  
0.1 0.2 MILES  
0.1 0.2 KILOMETERS

BR #32  
DO NOT  
PAVE

MM 3.059  
BRIDGE # 31  
(PAVE WITH A  
THIN LAYER)  
AS DIRECTED BY THE  
ENGINEER

MM 3.460  
END PROJECT

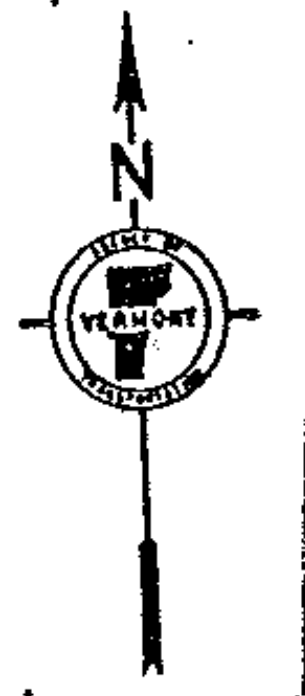

VT. 9 WILMINGTON, BEGINNING AT A POINT ON  
VT. 9 (MM 2.640) APPROXIMATELY 2366 FEET WEST OF  
THE JCT OF VT. 9 AND VT. 100 (NORTH) AND  
EXTENDING 0.820 MILES (4330 FEET) EASTERLY  
TO MM 3.460.

1982 ADT 6110  
V = 35

LENGTH : 0.820 MILES  
4330 FEET