


TYPICAL SECTIONS & DESIGN DATA

ITEM 406.25 BITUMINOUS CONCRETE PAVEMENT
LEVELING COURSE, TYPE III OR IV (355 TONS/MT.)
AS DIRECTED BY THE ENGINEER
1.5" WEARING COURSE, TYPE III

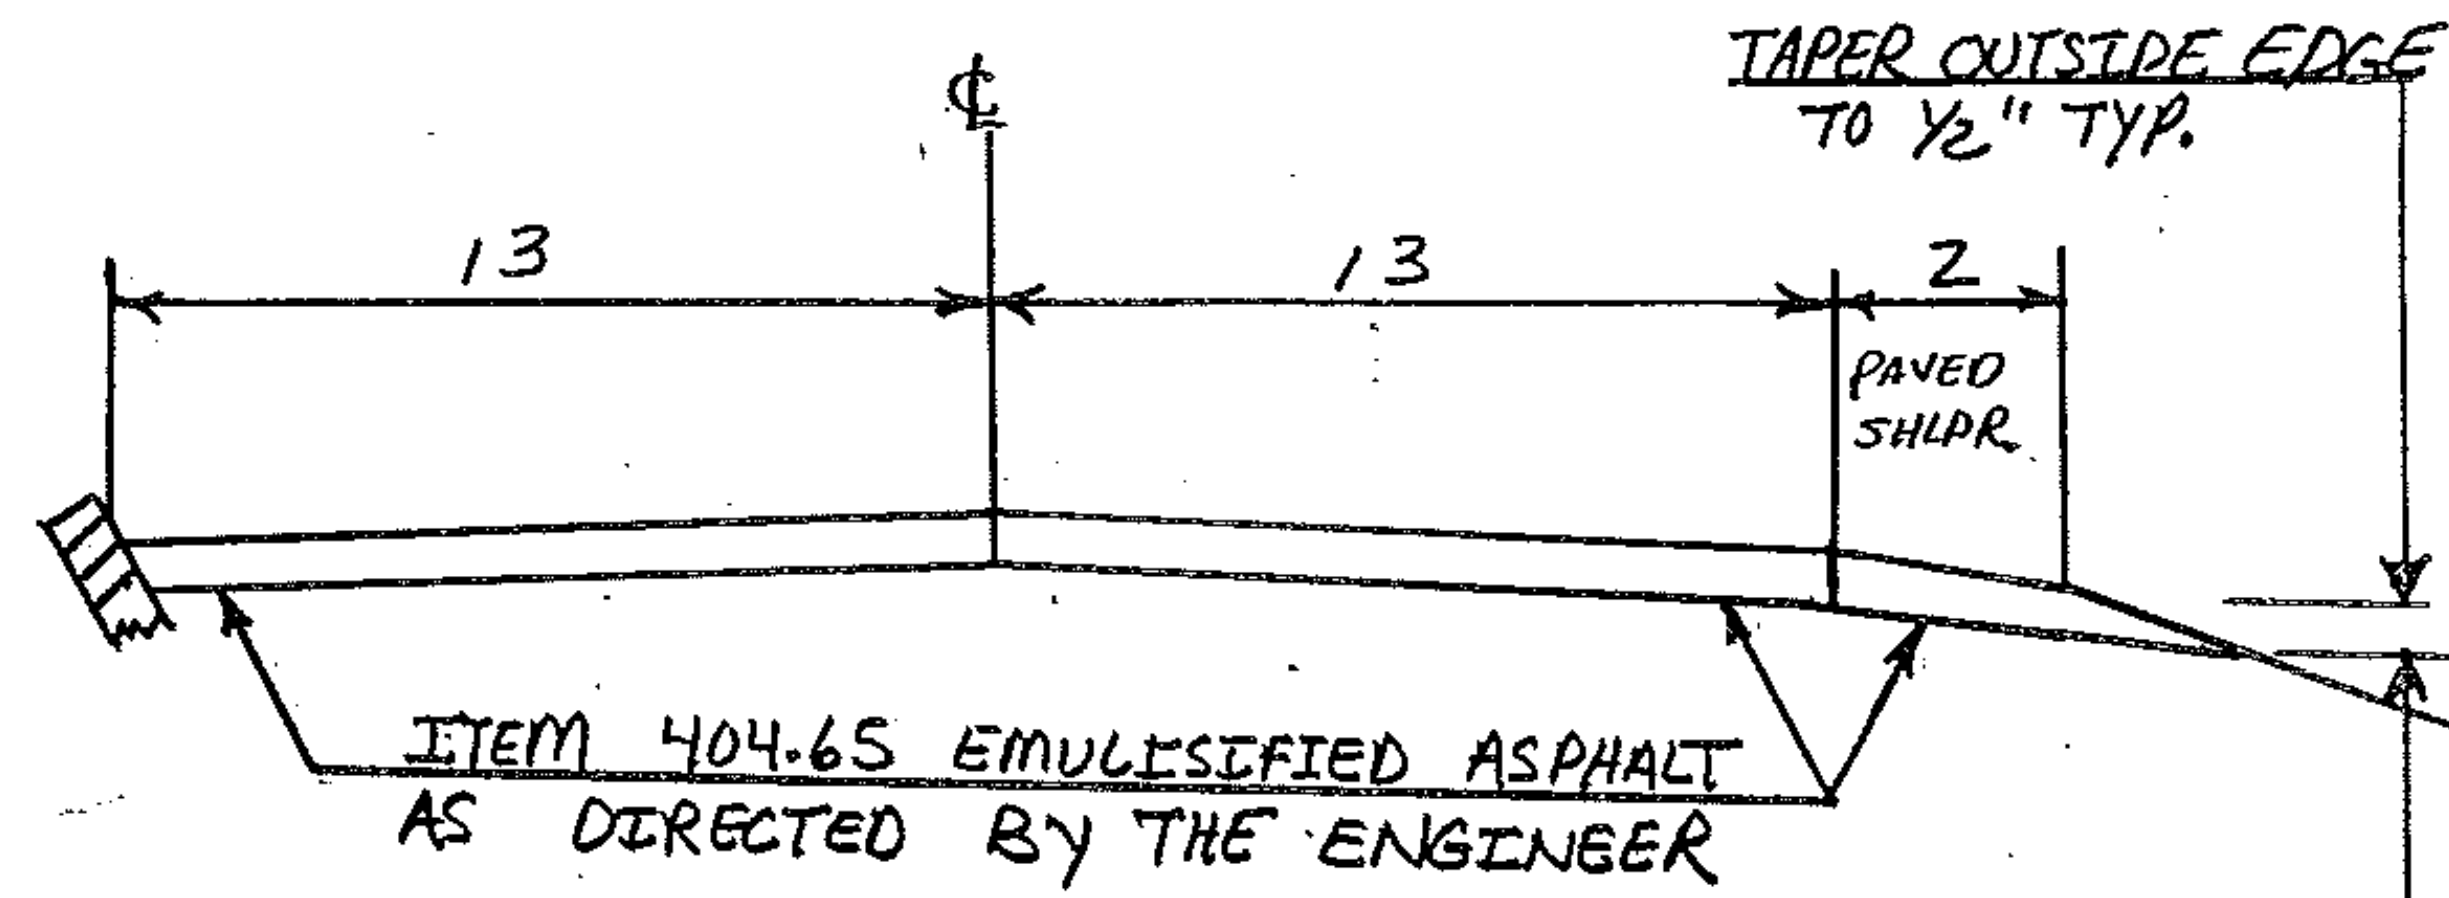

VT. 9 MM 3.230 ~ MM 3.330