


MARKINGS FOR SIGNALIZED INTERSECTION

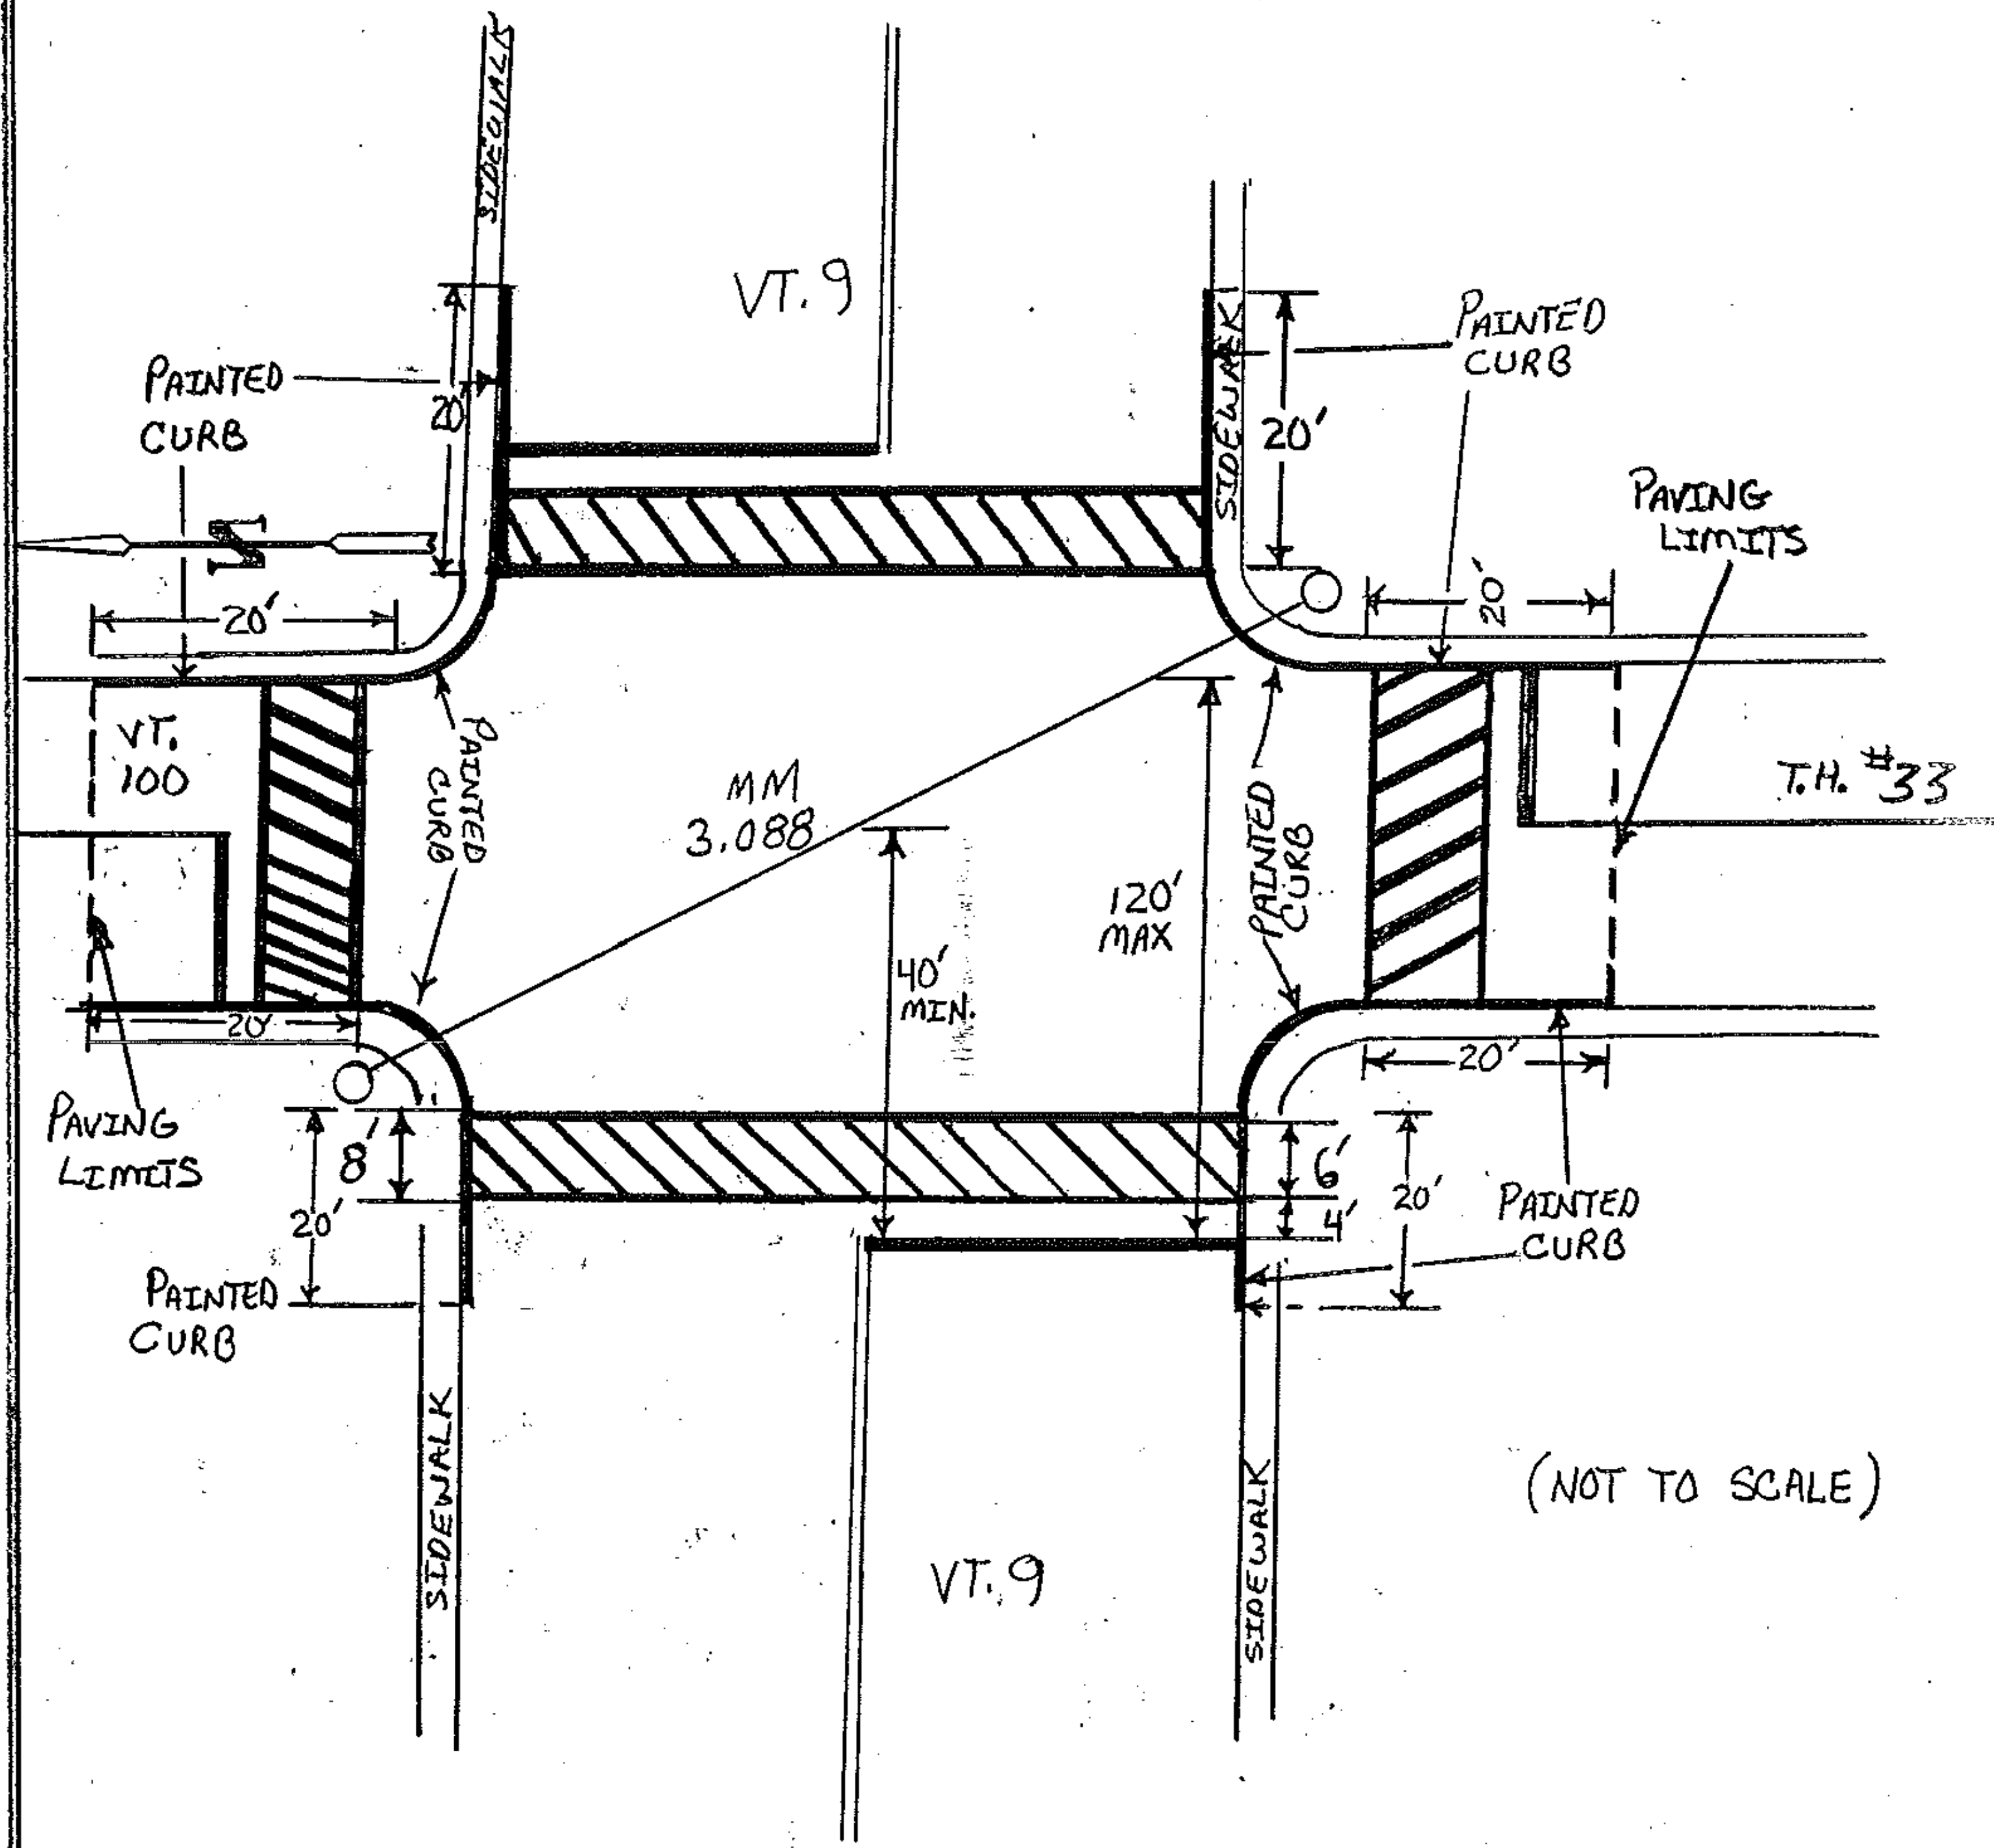

No. HMA 2644