


PROJECT LENGTHS AND ITEM QUANTITIES

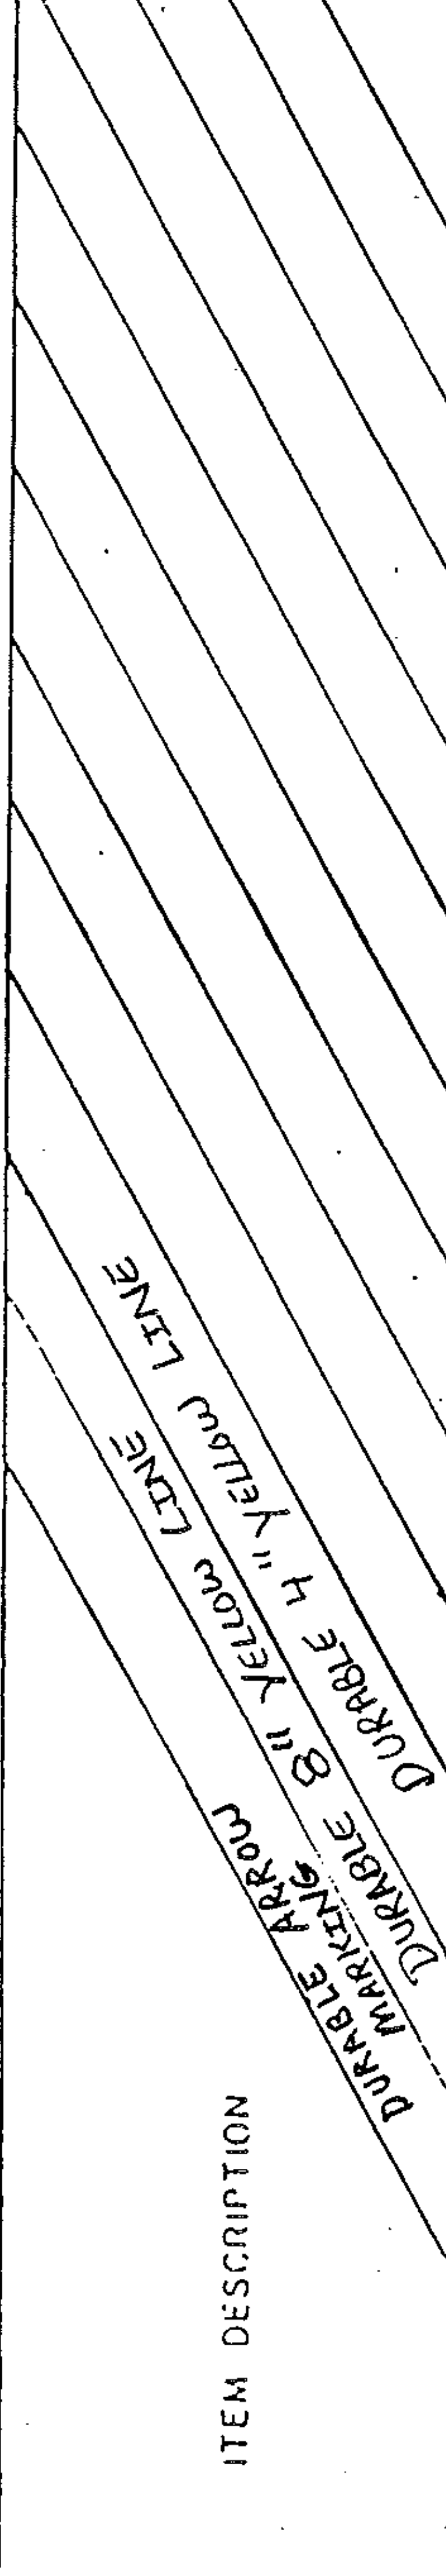

ITEM DESCRIPTION

ITEM NO	EA.	LF	LF						
UNIT									
LOCATION									
64665	64668	64661							
PAWLET HMA 2629									
WELLS-FOULTNEY HMA 2650									
WELLS-FOULTNEY CASTLETON HMA 2628	6	500	2000						
TOTAL	6	500	2000						

COMPOSITE PROJECT PAWLET, WELLS, FOULTNEY, CASTLETON

NO. HMA 2628, HMA 2629

HMA 2650