


PROJECT DESCRIPTION AND LOCATION

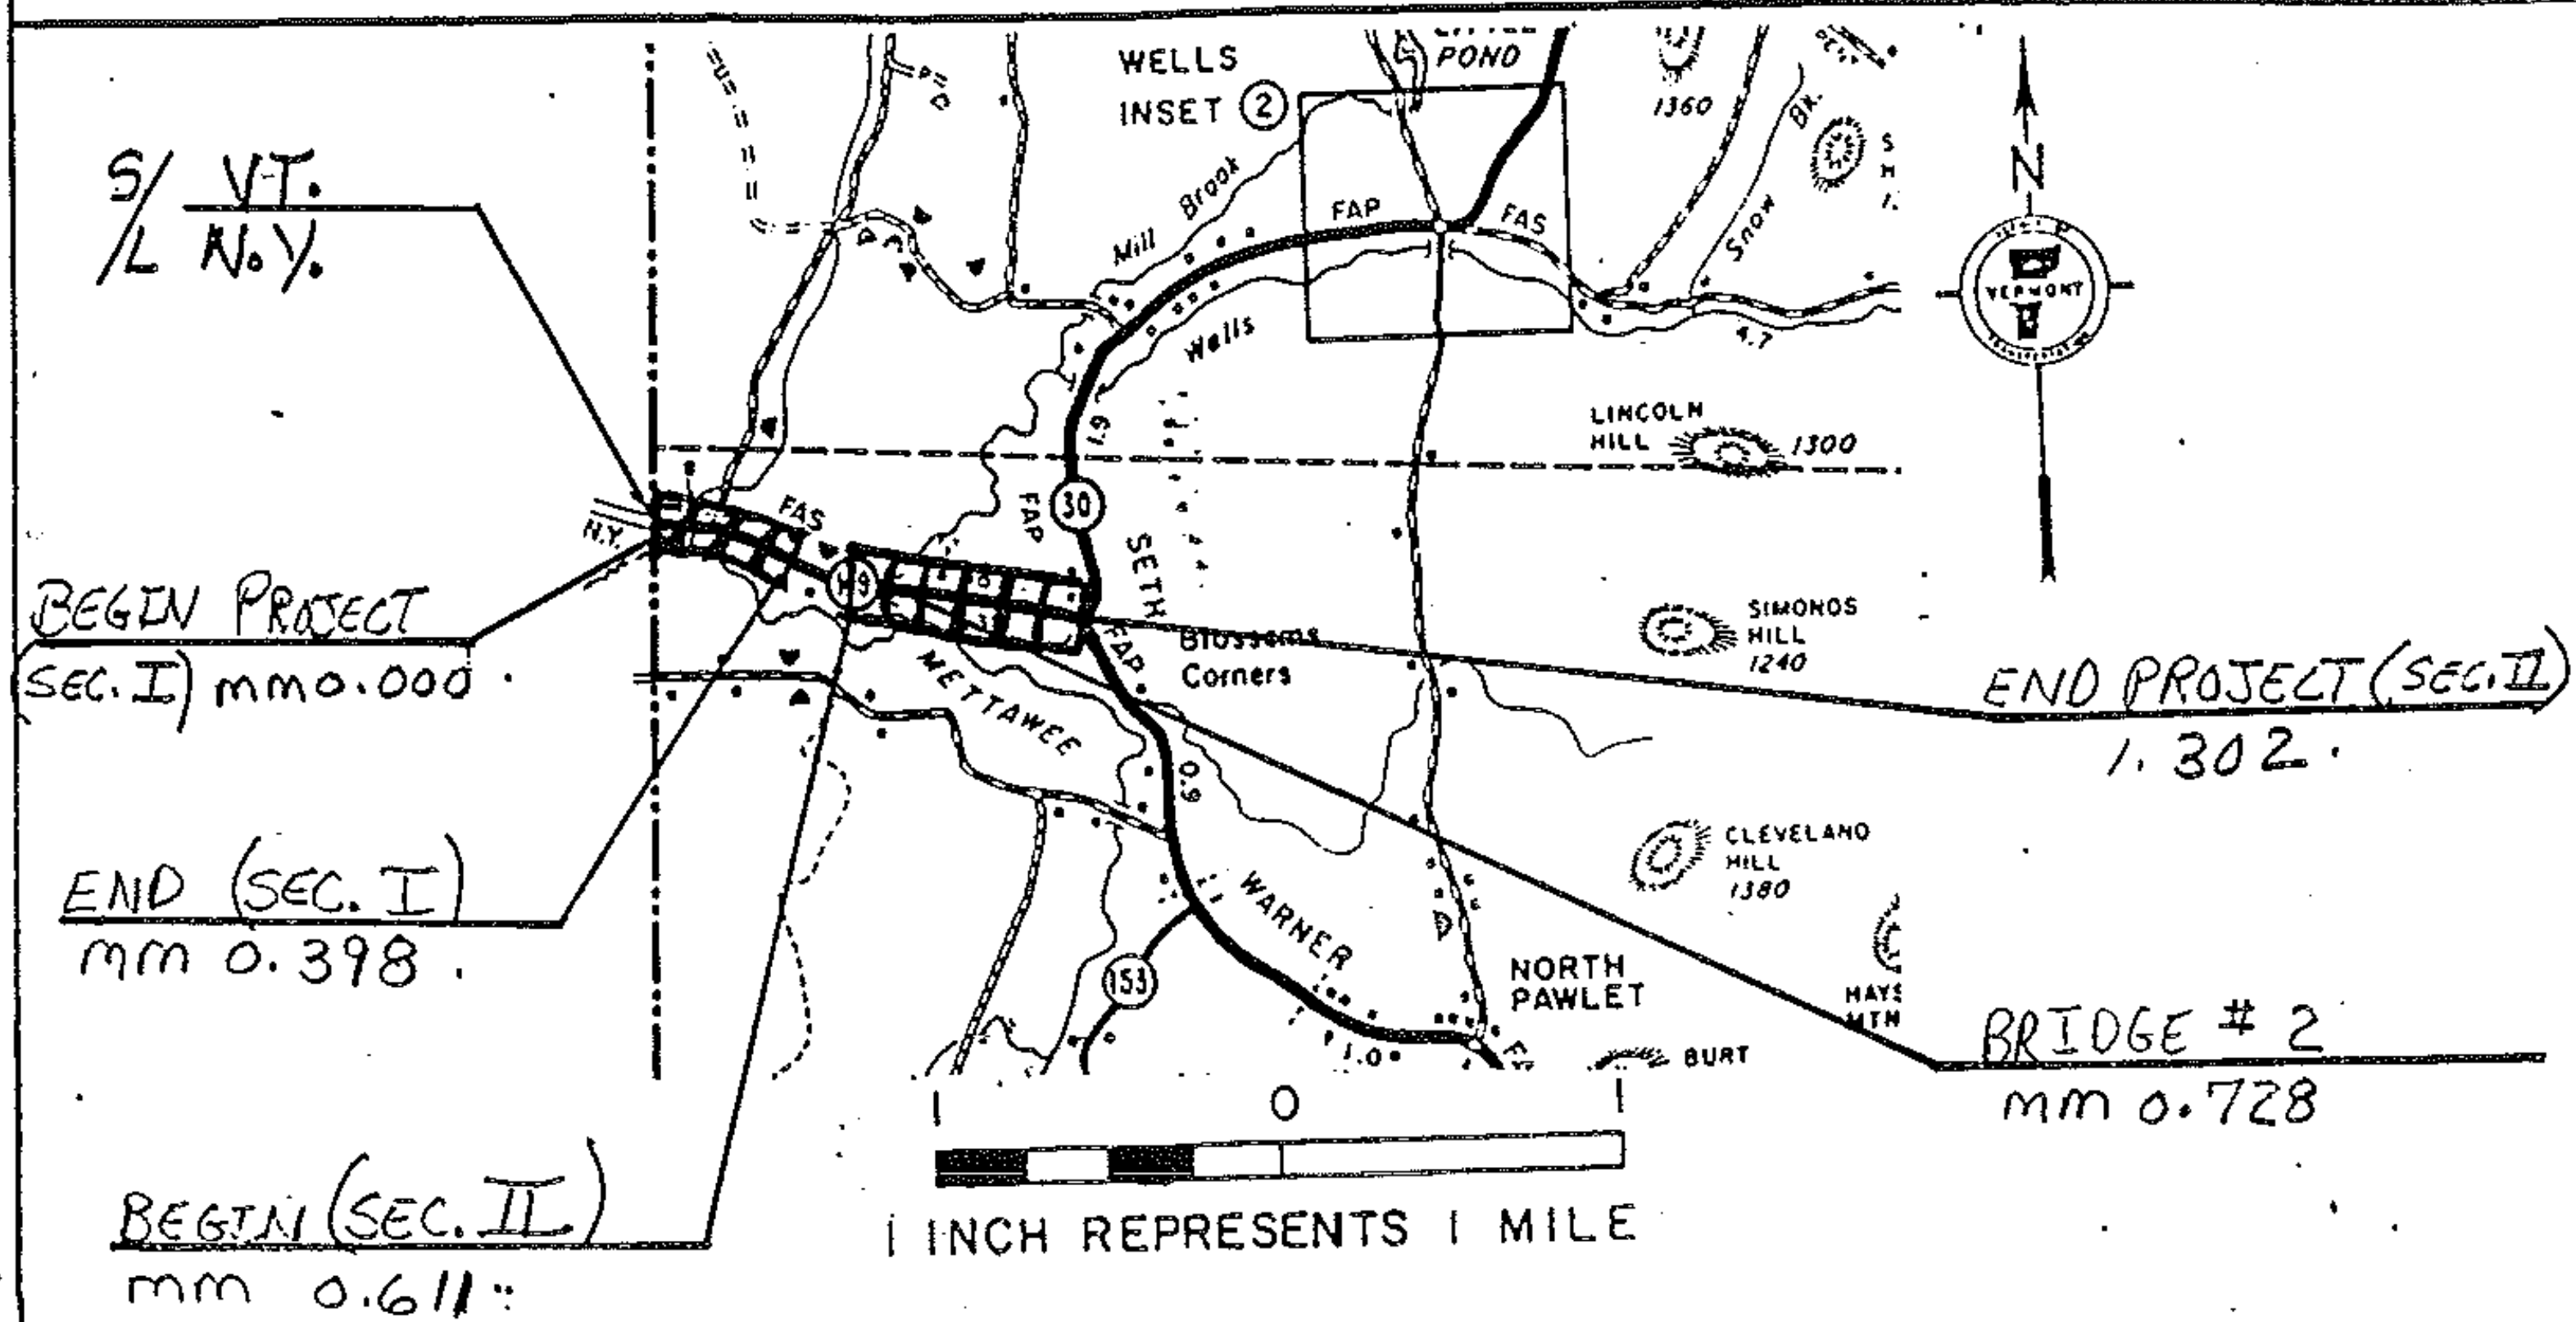

IN PAWLET, BEGINNING AT THE NY-VT. STATE LINE ON ROUTE VT. 149 (mm 0.000) AND EXTENDING EASTERLY FOR 0.398 MILES TO MM 0.398 (SEC. I). (SEC. II) BEGINNING AT A POINT 0.611 MILES EAST OF THE NY-VT. STATE LINE AND EXTENDING EASTERLY FOR 0.691 MILES TO THE JCT. OF VT. 149 AND VT. 30 (MM 1.302).

TRAFFIC DATA

1982 ADT 2205

V=50 mph

LENGTH OF PROJECT: 1.089 miles
5749 feet

SEC. I: 0.398 miles
2101 feet

SEC. II: 0.691 miles
3648 feet