


TYPICAL SECTIONS & DESIGN DATA

ITEM 40625 BITUMINOUS CONCRETE PAVEMENT
LEVELING COURSE TYPE III OR IV (22' WIDE @ 150 TONS/mi)
AS DIRECTED BY THE ENGINEER
3/4" WEARING COURSE TYPE IV

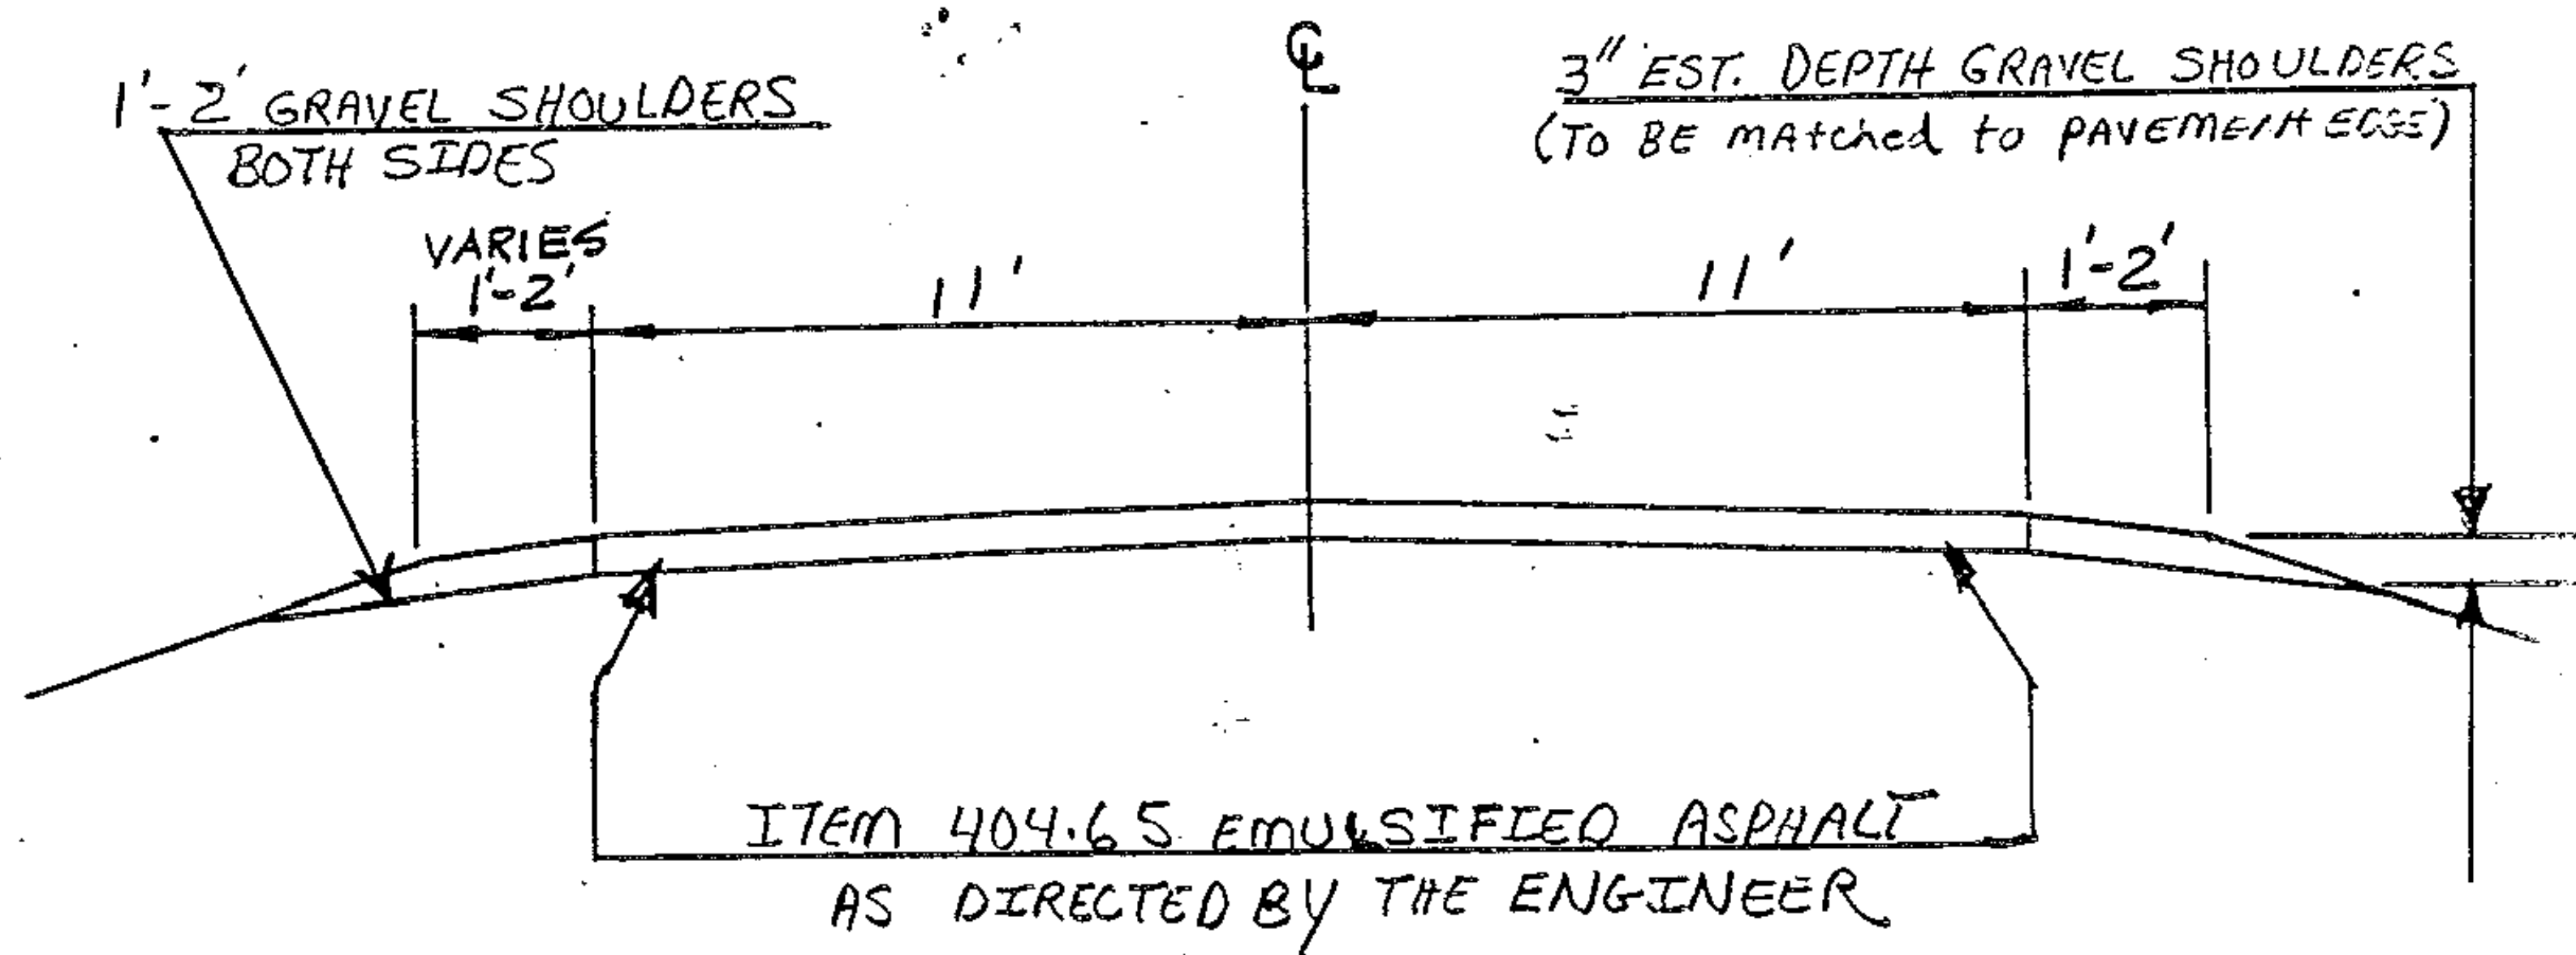

WELLS mm 0.000 ~ Poultney mm 3.201