


PROJECT DESCRIPTION AND LOCATION

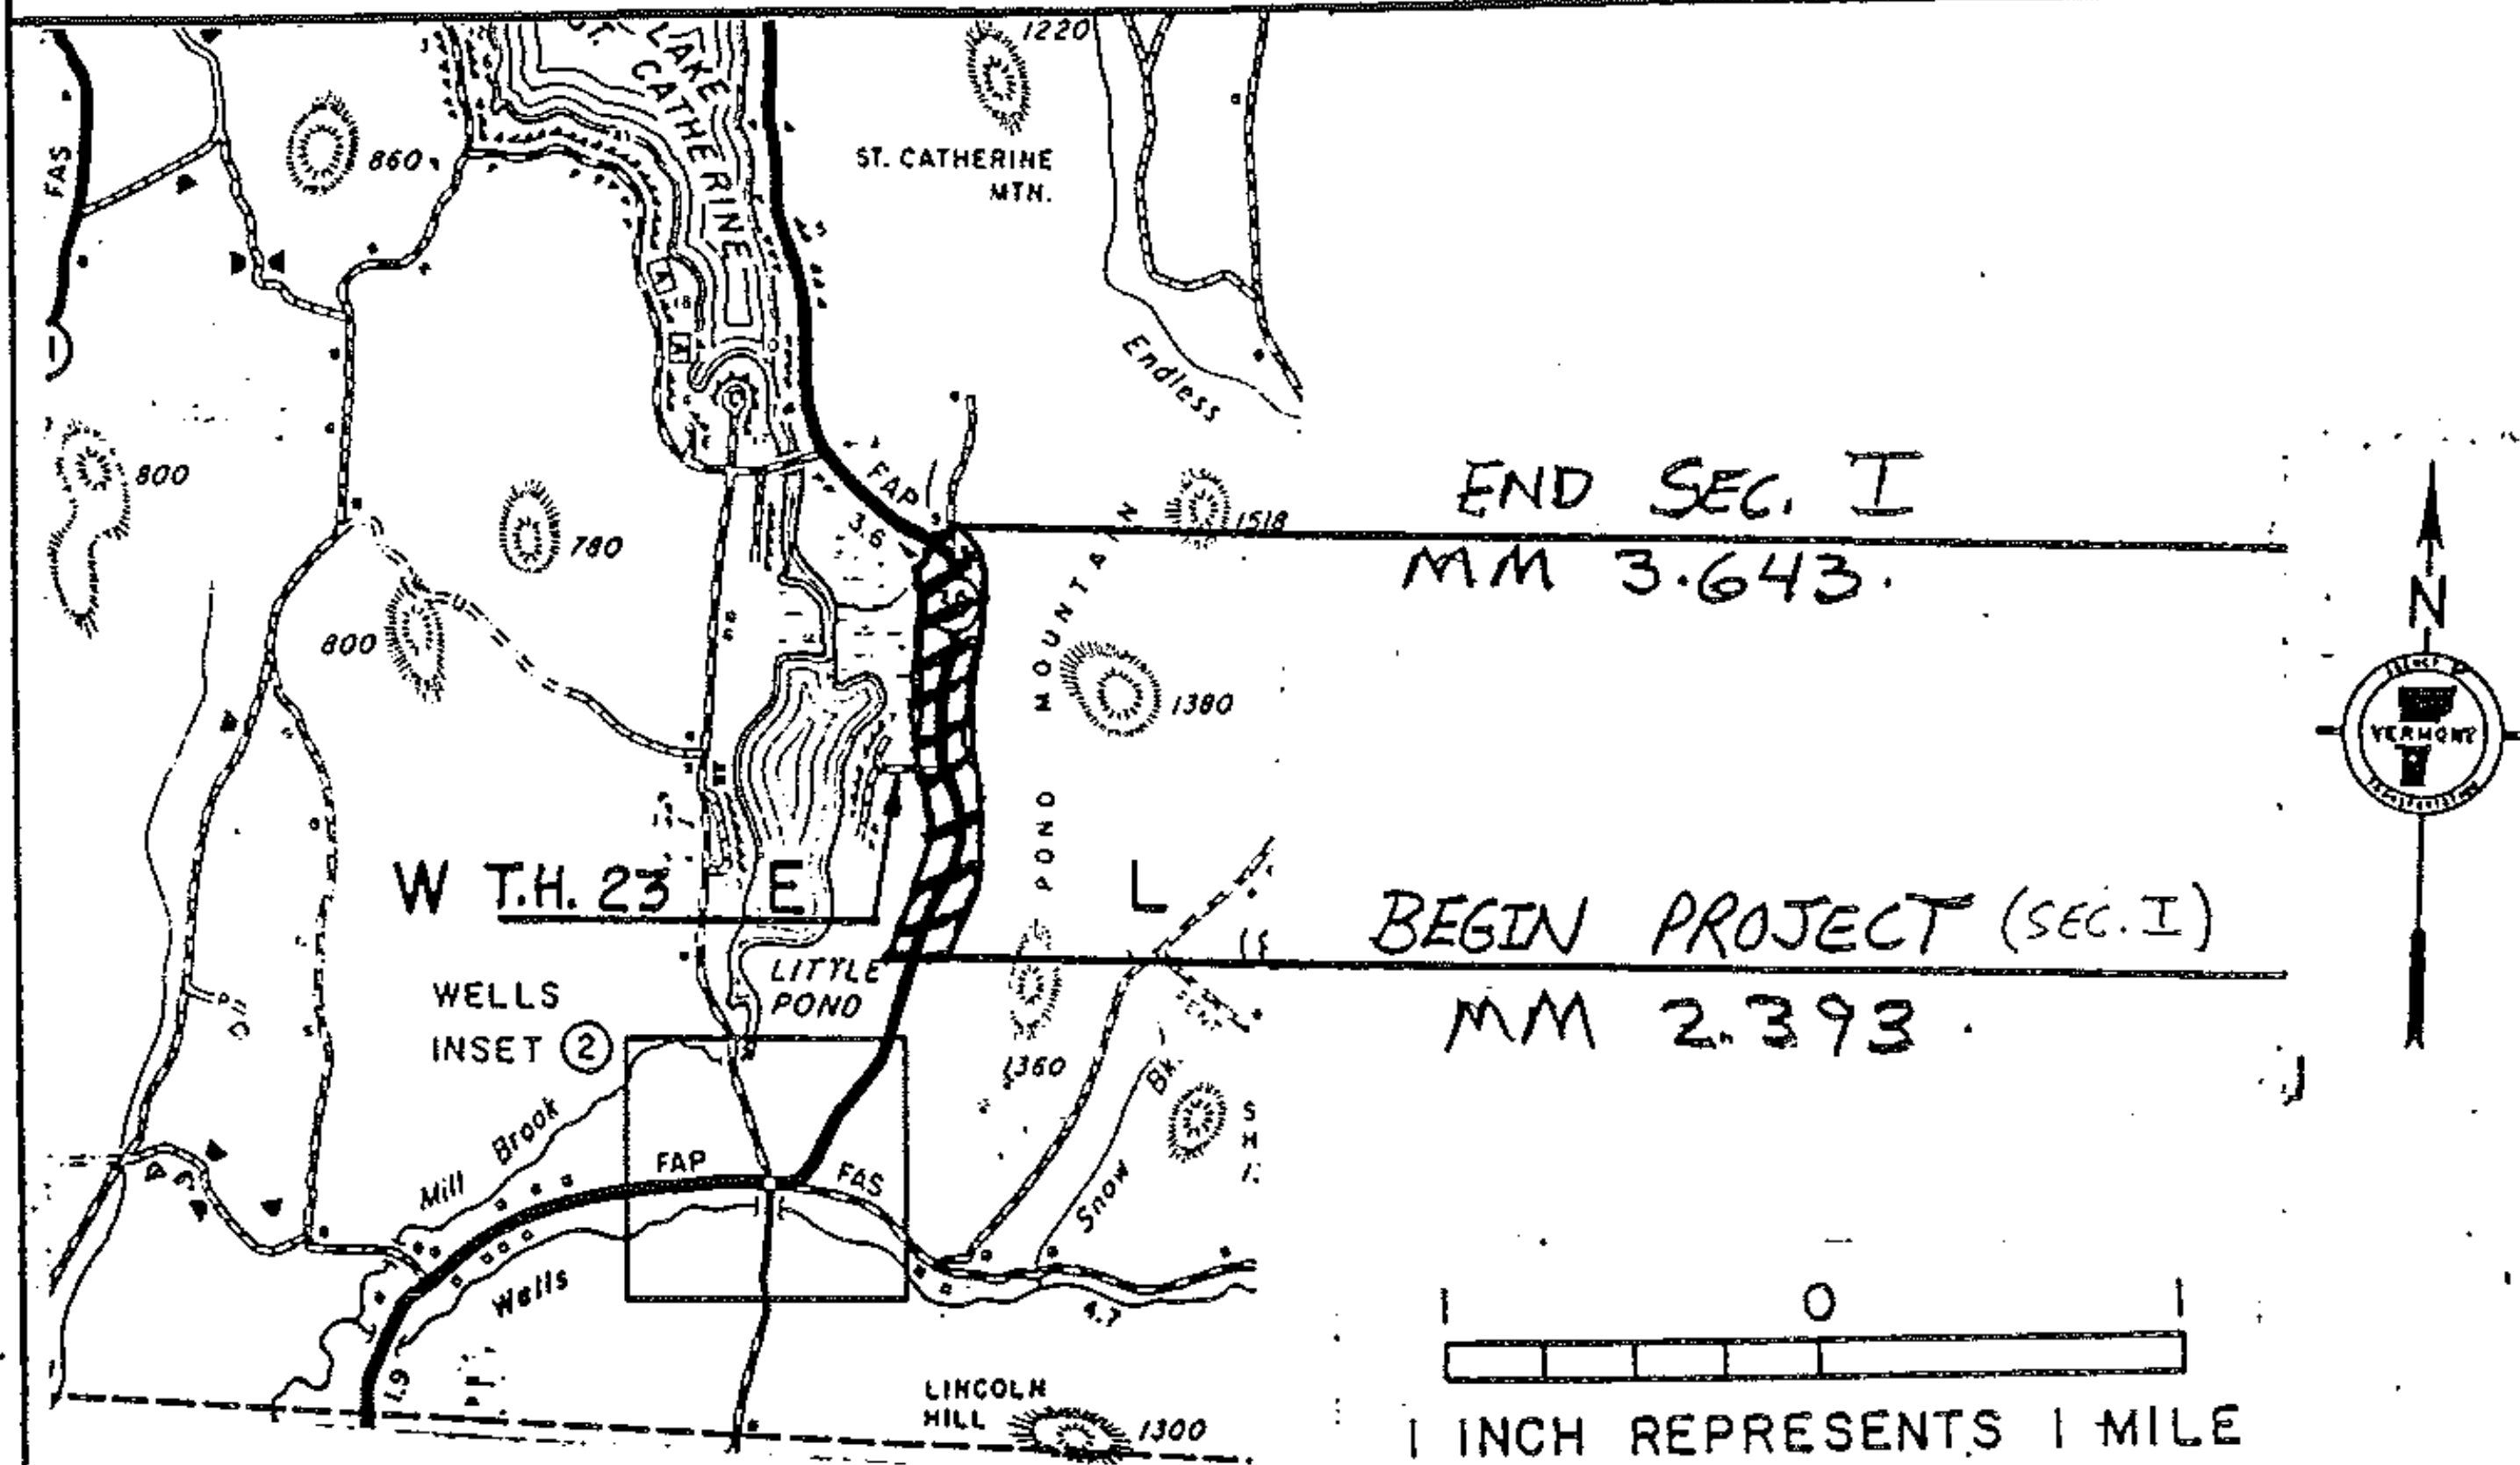

(SEC. I) IN WELLS, BEGINNING AT A POINT ON VT. 30 (MM 2.393) APPROXIMATELY 0.38 MILES SOUTH OF THE JCT. OF VT. 30 AND THE LITTLE LAKE EAST ROAD (TH 23) AND EXTENDING NORTHERLY 1.250 MILES SOUTH OF THE JCT OF VT. 30 AND TH. 3.

TRAFFIC DATA
 1982 ADT 800
 V = 50 MPH

LENGTH OF SEC. I : 1.250 miles
 6600 feet

NO. HMA 2628

SHEET 17 OF 35 SHEETS

PROJECT WELLS - POULTNEY - CASTLETON