

Plan
Scale: 1" = 20'

B CURVE DATA (P.C.C. Sta. 713+61.22)

Δ	45°03'24" Lt
D	3'-30"
R	1637.02'
T	679.03'
L	1287.34'
E	70.69'
SC	5'-15"
LS	300.00'
P	2.29'
X	149.96'
Y	299.75'
Xc	9.16'
LT	200.00'
ST	100.08'

Note: All stationing is offset radially from Median Stations

Note: For Ditch drainage refer to Roadway Plan and Section Sheets (Typ)

General Notes


- Elevation datum is sea level based on nearest U.S. Government Vertical control.
- For additional General Notes see Standard SCB-D1-65
- Where Bottom of Footing Elevations are above old ground fill is to be placed 0.5 feet above Bottom of Footing before Piles are driven. Excavation of this material to Bottom of Footing Elevation after Piles are driven shall be paid for as Structure Excavation, Item 109.
- Approach Slabs shall be constructed as part of Stage I construction.
- Shop Drawings for Item 556-C, Granite Bridge Curb, shall be submitted in triplicate to the State of Vermont, Department of Highways, for approval before fabrication.

List of Bridge Sheets

- | | |
|-------------|-----------------------------------|
| Br. 300 | Plan and Elevation, General Notes |
| 301 | Quantity Sheet |
| 302 | Preliminary Information Sheet |
| 303-305 | Borings |
| 306 | S.B. Superstructure |
| 307 | N.B. Superstructure |
| 308-311 | Abutments #1-#4 |
| 312-315 | Piers #1-#4 |
| 316-319 | Approach Slabs #1-#4 |
| Br. 320-322 | Reinforcing Steel Schedules |

STANDARD SHEETS

- SCB-37.25-65
- SCB-D1-65
- SCB-D2-65 (All details)
- SCB-D3-65 (All details)
- SCB-D4-65
- SCB-D5-65
- SCB-D6-65 (Details A, B, D, F)
- SCB-D7-65 (All details)
- SCB-D8-65 (All details)
- SCB-D9-65 (Detail A)
- SB-R1-64, Sh 1 & 2 of 2
- SB-R2-65

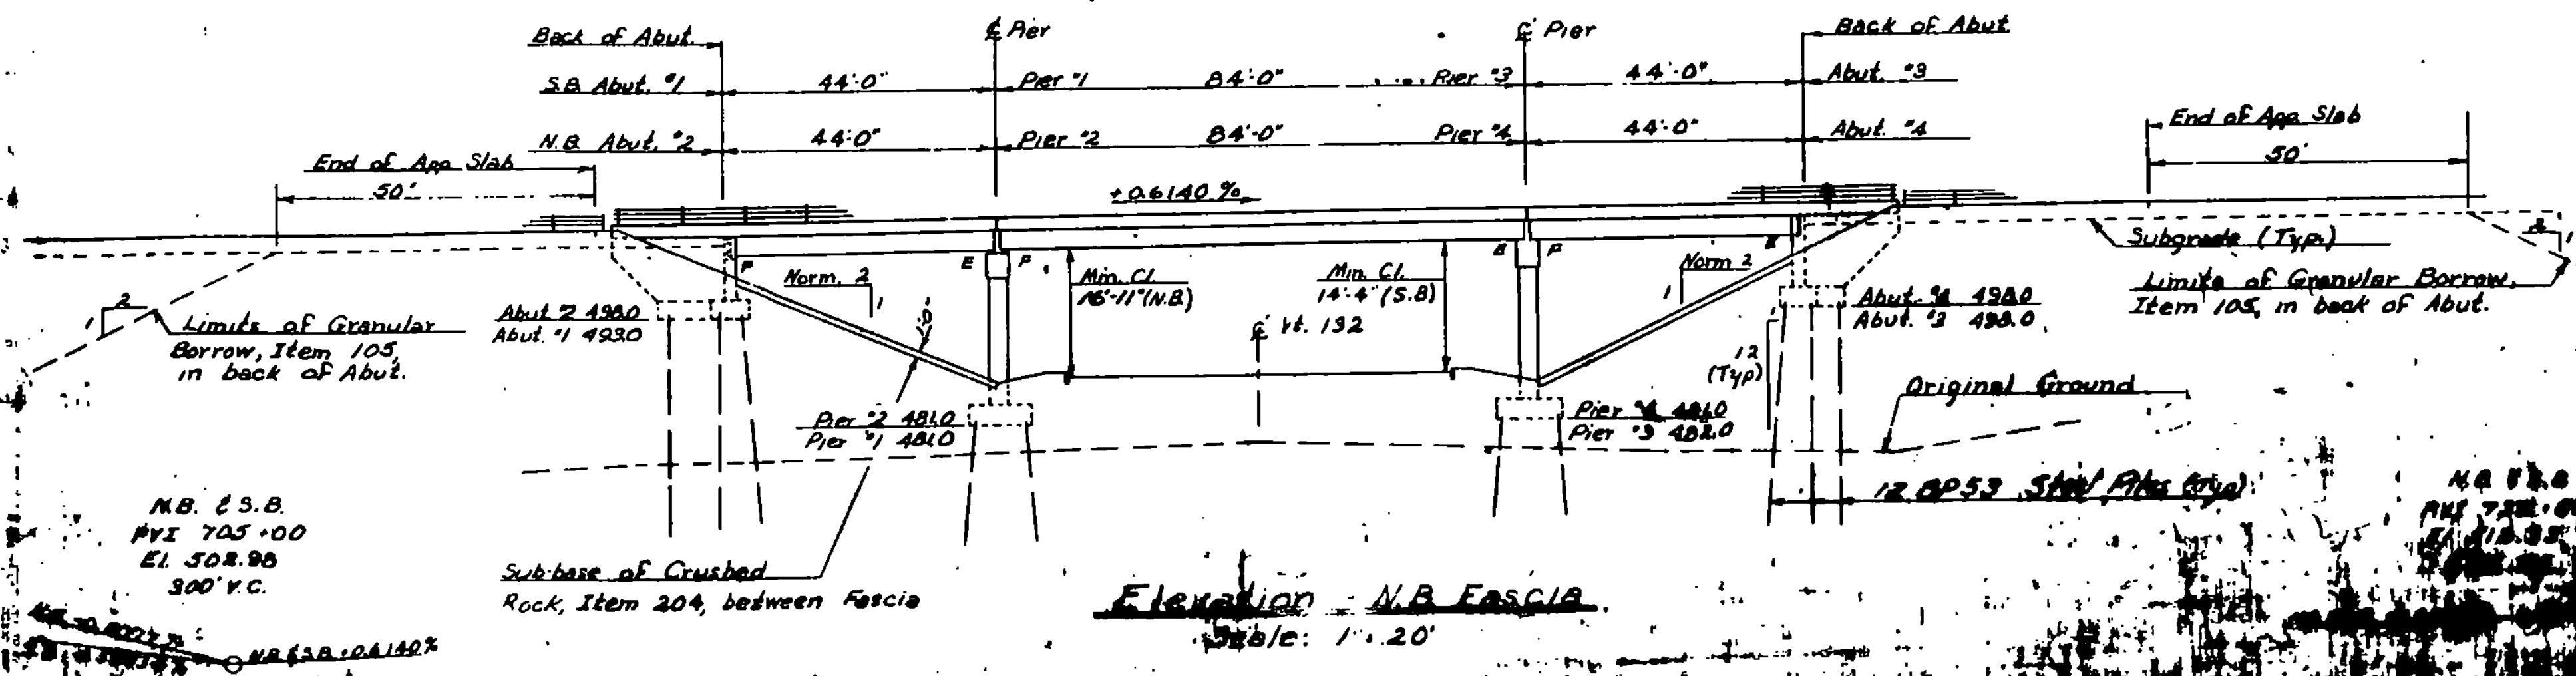

Elevation - N.B. Fascia
Scale: 1" = 20'

IR-DECK (15) I-89, BR. #15 N.E.S.
THIS SHEET FOR INFORMATION ONLY

STATE OF VERMONT
DEPARTMENT OF HIGHWAYS

PROJECT - HARTFORD SHARON
TOWN OF - SHARON

ROUTE No. I 89 STA. 712

I 89 OVER RR

PLAN & ELEVATION, GENERAL NOTES