
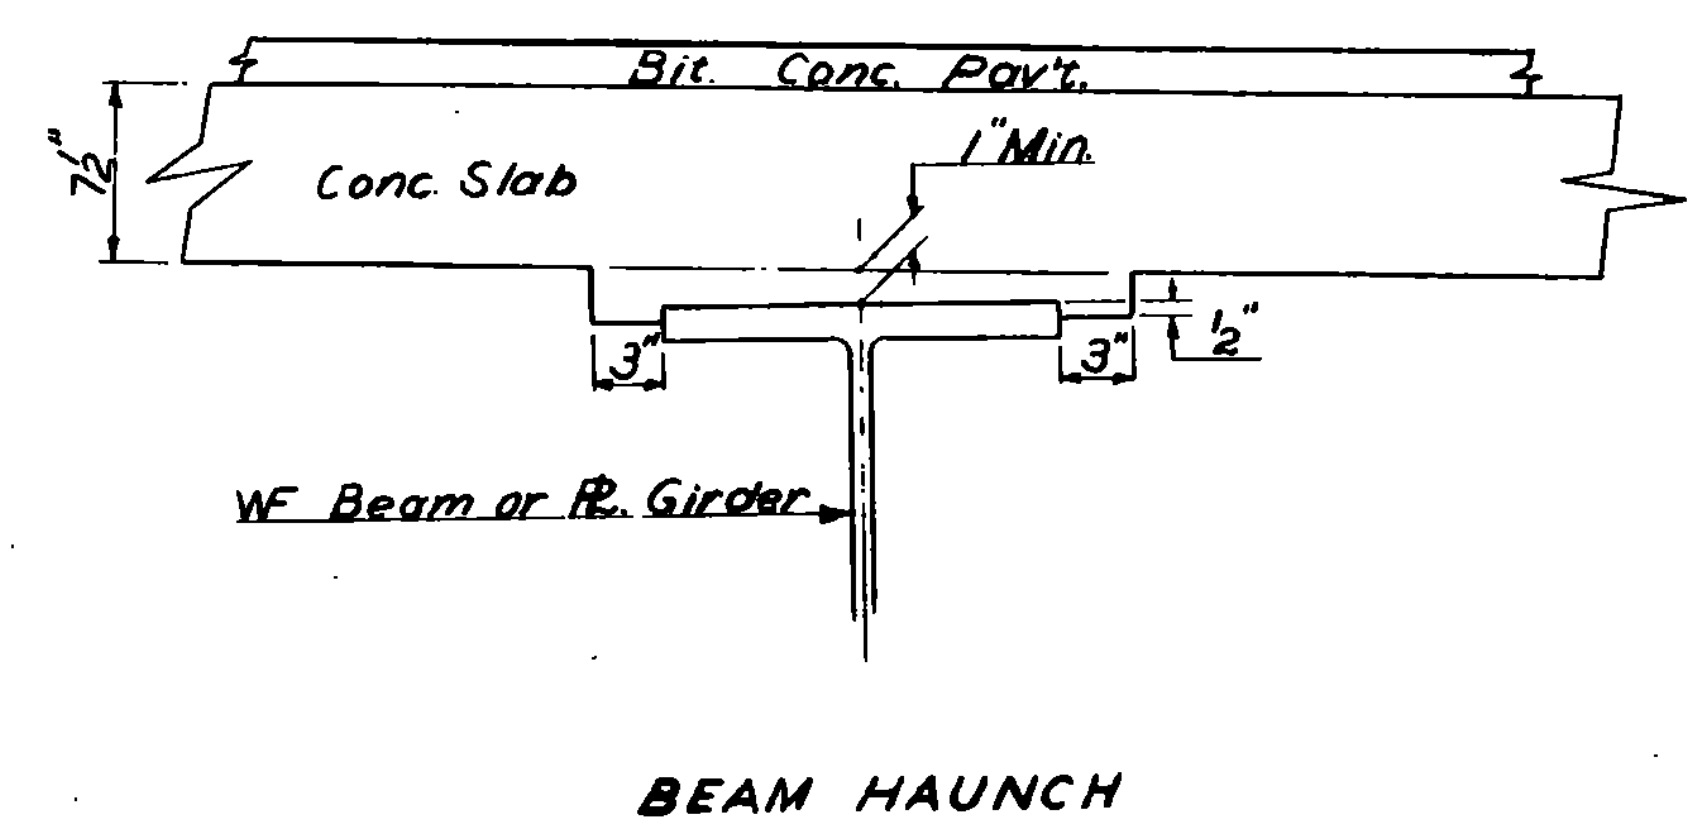


IR-DECK (15) I-89, BR # 15 N&S
THIS SHEET FOR INFORMATION ONLY

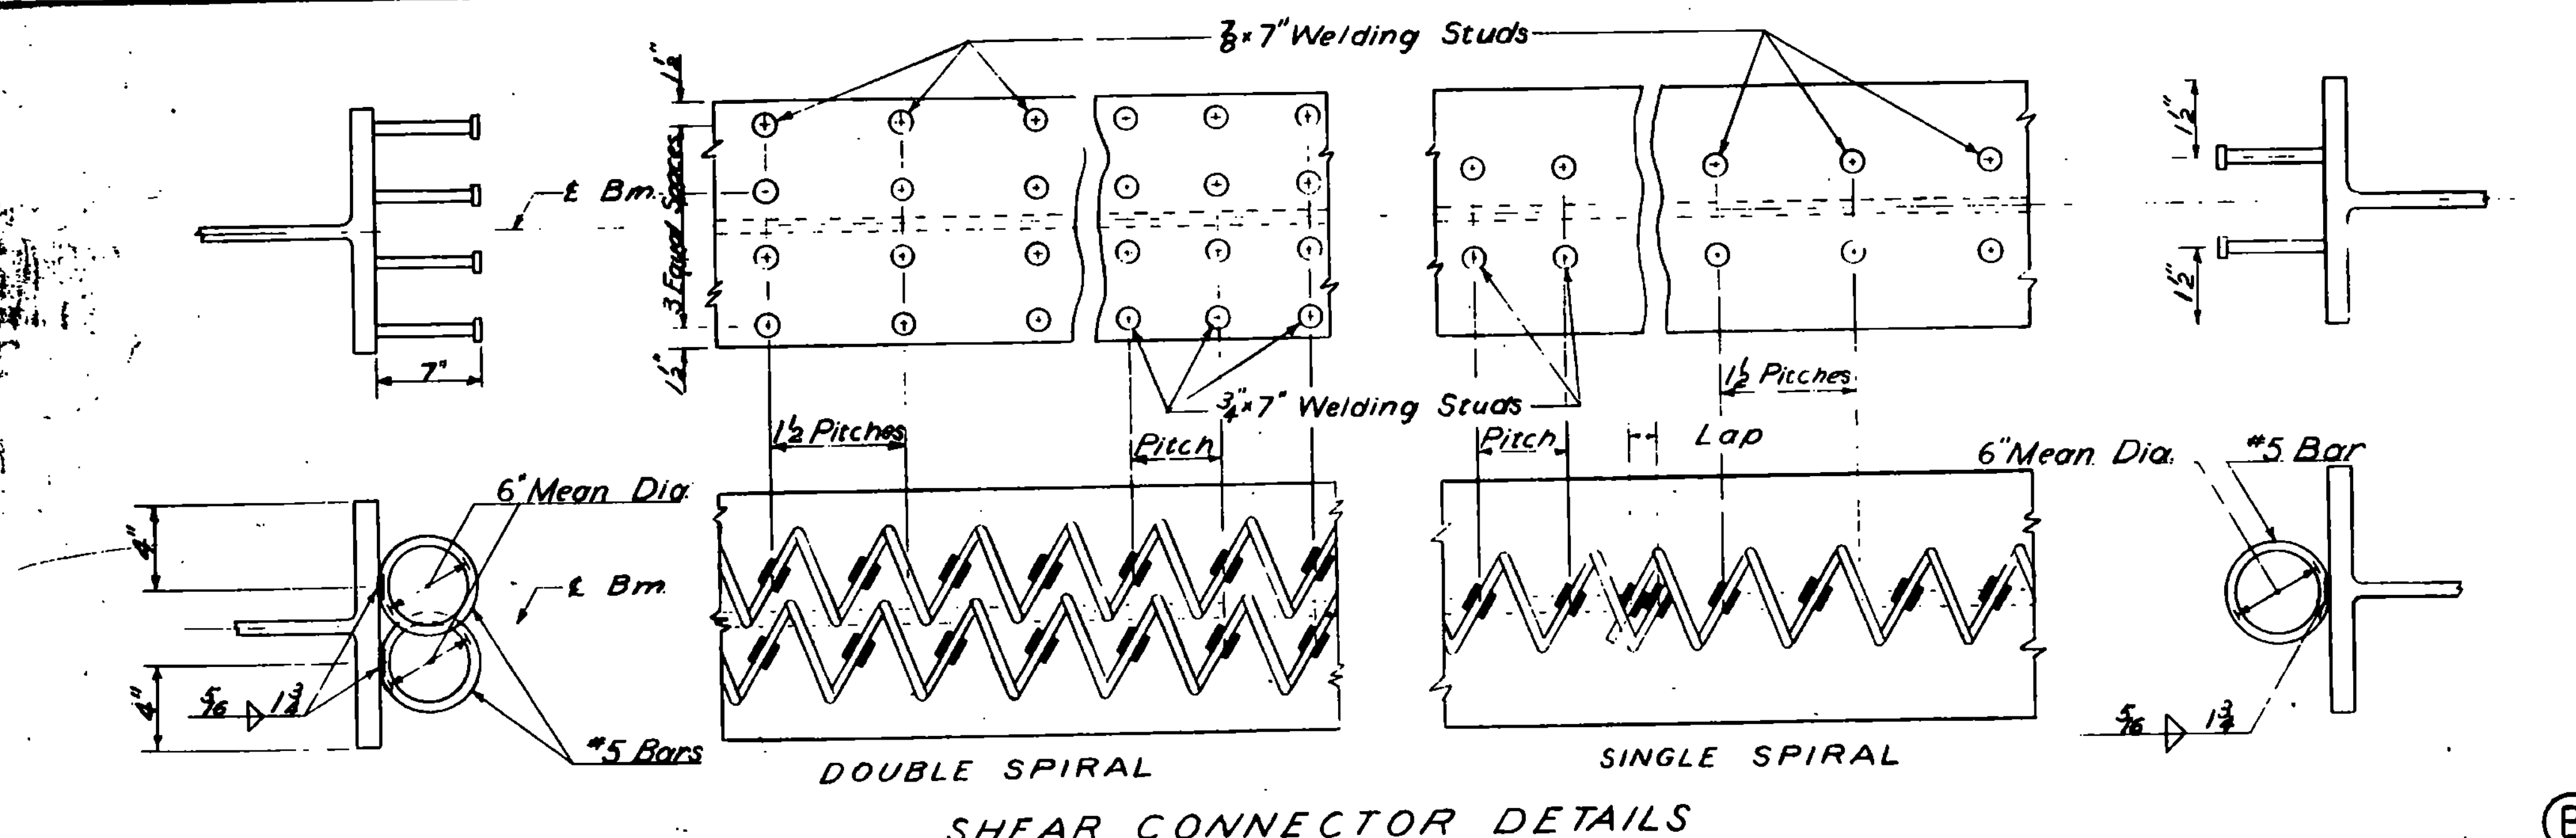

REVISIONS & CORRECTIONS

Drawn By: W 12/1/62 Revised WBT/12/3/62
 Traced By: W 12/1/62 Revised WBT/12/3/62
 Checked By: FER/VMS/BSH 12/7/62 Rev. VMS/1/64

Recommended LMB/Brom - 2/4/65
 For Approval Bridge Engineer Date

Recommended [Signature] 2/1/65
 For Approval Assist. Chief Engineer Date

Approved By: A. D. [Signature] - 2/4/65
 Chief Engineer

- DETAILS OF WF BEAM BRIDGES
- (A) ELEVATION VIEWS
 - (B) SHEAR CONNECTOR DETAILS
 - (C) BEAM HAUNCH DETAIL

VERMONT
DEPARTMENT OF HIGHWAYS
STRUCTURE STANDARDS

SCB