


GENERAL NOTES
 1. ALL WORK AND MATERIALS SHALL CONFORM TO THE STATE OF VERMONT, DEPARTMENT OF HIGHWAYS, STANDARD SPECIFICATIONS FOR HIGHWAY AND BRIDGE CONSTRUCTION DATED APRIL 1964, AND THE A.A.S.H.O. SPECIFICATIONS DATED 1961. DESIGNED FOR HS 20-44 LOADING.
 2. ALL REINFORCING STEEL SHALL BE DETAILED ON THE REINFORCING STEEL SCHEDULE. ALL SPLICES SHALL BE A MINIMUM OF 40 BAR DIAMETERS.

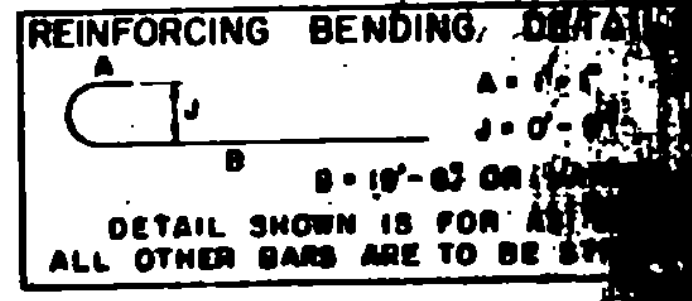

LIST OF QUANTITIES

ITEM NO.	ITEM	UNIT
310	TAR EMULSION FOR BRIDGE FLOORS	GAL.
361-B	BITUMINOUS CONCRETE PAVEMENT	TONS
372-A	JOINT SEALER - HOT POURED	L.F.
372-C	JOINT SEALER - PREFORMED, TYPE A	L.F.
401-B	CONCRETE CLASS B	CY.
402	REINFORCING STEEL	LB.

IR-DECK (15), I-89, BR.#'s 151
 THIS SHEET FOR INFORMATION ONLY
 PROJECT HARTFORD - SHARON
 TOWN OF SHARON
 ROUTE NO. I 89 STA. 717.0

REVISIONS AND CORRECTIONS
 DIMENSIONS OF JOINT SEALER TYPE A REVISED 6/18/85 WBT.
 DIMENSIONS OF JOINT SEALER TYPE B REVISED 6/23/85 WBT.
 JOINT BETWEEN CURB AND SLAB REVISED, BITUMINOUS CONCRETE REVISED TO E. QUANTITY TOTALS REVISED, 12/7/85, WBT.

DRAWN BY: WAT
 TRACED BY: WBT
 CHECKED BY: WMS
 RECOMMENDED FOR APPROVAL: [Signature] 2/4/65
 RECOMMENDED FOR APPROVAL: [Signature] 2/11/65
 APPROVED BY: [Signature] 2/11/65

DETAILS OF APPROACH SLAB FOR 37.25 FOOT BRIDGE (WIDTH)
 TO BE USED FOR BRIDGE AT STATION 717.0
 LOCATION I 89 over Rt. 712

STATE OF VERMONT
 DEPARTMENT OF HIGHWAYS
 STANDARD STRUCTURE
 SB-A8