


GENERAL NOTES  
 1. ALL WORK AND MATERIALS SHALL CONFORM TO THE STATE OF VERMONT, DEPARTMENT OF HIGHWAYS, STANDARD SPECIFICATIONS FOR HIGHWAY AND BRIDGE CONSTRUCTION DATED APRIL 1964, AND THE A.A.S.H.O. SPECIFICATIONS DATED 1961, DESIGNED FOR HS20-44 LOADING.  
 2. ALL REINFORCING STEEL SHALL BE DETAILED ON THE REINFORCING STEEL SCHEDULE. ALL SPLICES SHALL BE A MINIMUM OF 40 BAR DIAMETERS.

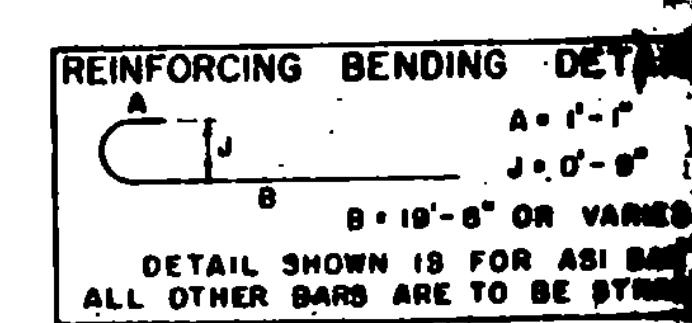

LIST OF QUANTITIES

ITEM NO.	ITEM	UNIT
318	TAR EMULSION FOR BRIDGE FLOORS	GAL.
361-B	BITUMINOUS CONCRETE PAVEMENT	TONS
372-A	JOINT SEALER - HOT Poured	L.F.
372-C	JOINT SEALER - PREFORMED, TYPE A	L.F.
401-B	CONCRETE CLASS B	CY.
402	REINFORCING STEEL	LB.

IR-DECK (15), I-89, BR.#'S 15N  
 THIS SHEET FOR INFORMATION ONLY  
 PROJECT HARTFORD - SHARON  
 TOWN OF SHARON  
 ROUTE NO. I 89 STA. 717+0  
I 89 OVER VT. 132  
Approach Slab 53  
 NOT TO SCALE  
 IN CHARGE E. O. Hall

REVISIONS AND CORRECTIONS  
 1. DIMENSIONS OF JOINT SEALER TYPE A REVISED 4/18/85 M.B.T.  
 2. DIMENSIONS OF JOINT SEALER TYPE B REVISED 8/23/85 M.B.T.  
 3. JOINT BETWEEN CURB AND SLAB REVISED, BITUMINOUS CONCRETE REVISED TO 2, QUANTITY TOTALS REMOVED. 12/7/85. M.B.T.

DRAWN BY: W.S.T. van 12-83  
 TRACED BY: W.S.T. van 12-83  
 CHECKED BY: WMS. Fab 12-83  
 RECOMMENDED FOR APPROVAL: L. J. Boyce 2/4/65  
 BRIDGE ENGINEER DATE  
 RECOMMENDED FOR APPROVAL: R. H. Curran 2/4/65  
 ASSISTANT CHIEF ENGINEER DATE  
 APPROVED BY: A. D. Bishop 2/4/65  
 CHIEF ENGINEER DATE

DETAILS OF APPROACH SLAB  
 FOR 37.25 FOOT BRIDGE  
 (WIDTH)  
 TO BE USED FOR BRIDGE AT STATION 717+0  
 LOCATION I 89 OVER VT 132

STATE OF VERMONT  
 DEPARTMENT OF HIGHWAYS  
 STANDARD STRUCTURE  
 SB-AS-65