


PROPERTY LINE FENCE w/STEEL POSTS, ITEM 583-B
 Ramp A 11+00-15+00 Rt.
 Ramp D 6+00-9+77 Rt.
 Ramp B 8+00 Rt. - 3223+00 S.B. Lt.
 Ramp C 11+00 Rt. - 3223+00 N.B. Rt.

US 5 - 35+33.6
 Begin Decel. Lane
 110
 35+50
 110
 34+65
 100
 10+85

US Rt. 5 POT 35+69.95
 Ramp A POT 10+00.00
 Δ 107°00' Lt.
 125
 35+50
 Ramp B POT 9+05.07
 US Rt. 5 POT 35+69.95
 Δ 66° Rt.
 * THREE CABLE GUARD RAIL w/STEEL POSTS, ITEM 542
 'D' 9+52 Lt. - 26+95 Rt. 5 Lt.
 'C' 12+00 Lt. - 26+95 Rt. 5 Lt.
 'A' 15+00 Lt. - 35+50 Rt. 5 Lt.
 'A' 11+00 Lt. - 31+45 Rt. 5 Lt.
 'A' 13+50 Lt. - 15+00 Lt.
 US Rt. 5 Rt. 31+45 - 32+01

SUB-BASE of SAND, ITEM 202
 3211+00 - 3212+50 SB
 3211+00 - 3213+00 NB
 3216+00 - 3223+00 NB
 3218+50 - 3223+00 SB
 US Rt. 5 25+50 - 26+95

EXCAVATION & REMOVAL of ROAD SURFACE on ROADWAYS, ITEM 116-A
 25+50 - 26+05
 27+40 - 29+40
 STONE FILL for SLOPE PROTECTION ITEM 522
 11+38 Ramp 'C' Rt.
 * STANDARD STEEL BEAM GUARD RAIL w/STEEL POSTS ITEM 545-A
 3219-36 - 3219-65 N.B. Lt. 6 Rt.
 3219-47 - 3219-70 S.B. Lt. 6 Rt.
 * GRANITE SLOPE EDGING ITEM 556-A
 Ramp A 9+16 Rt. - 11+76.5 Rt. (U.S. 35+33.6 Lt.)
 Ramp A 10+00 Lt. - 10+83 Lt. (U.S. 34+44 Lt.)
 Ramp A 10+83 Lt. - U.S. 33+55 Lt. U.S. 33+55 - 34+44 Lt.
 Ramp B 2+01 - 2+52 Lt. S.B. 3220+20 - 3220+72 Lt.
 Ramp C 9+37 Rt. - 11+40 Rt. (U.S. 25+51 Rt.)
 Ramp C 10+17.5 Lt. - 10+86 Lt. (U.S. 26+37)
 U.S. 26+37 - 27+15 Rt.
 Ramp C 10+86 Lt. - U.S. 27+15 Rt.

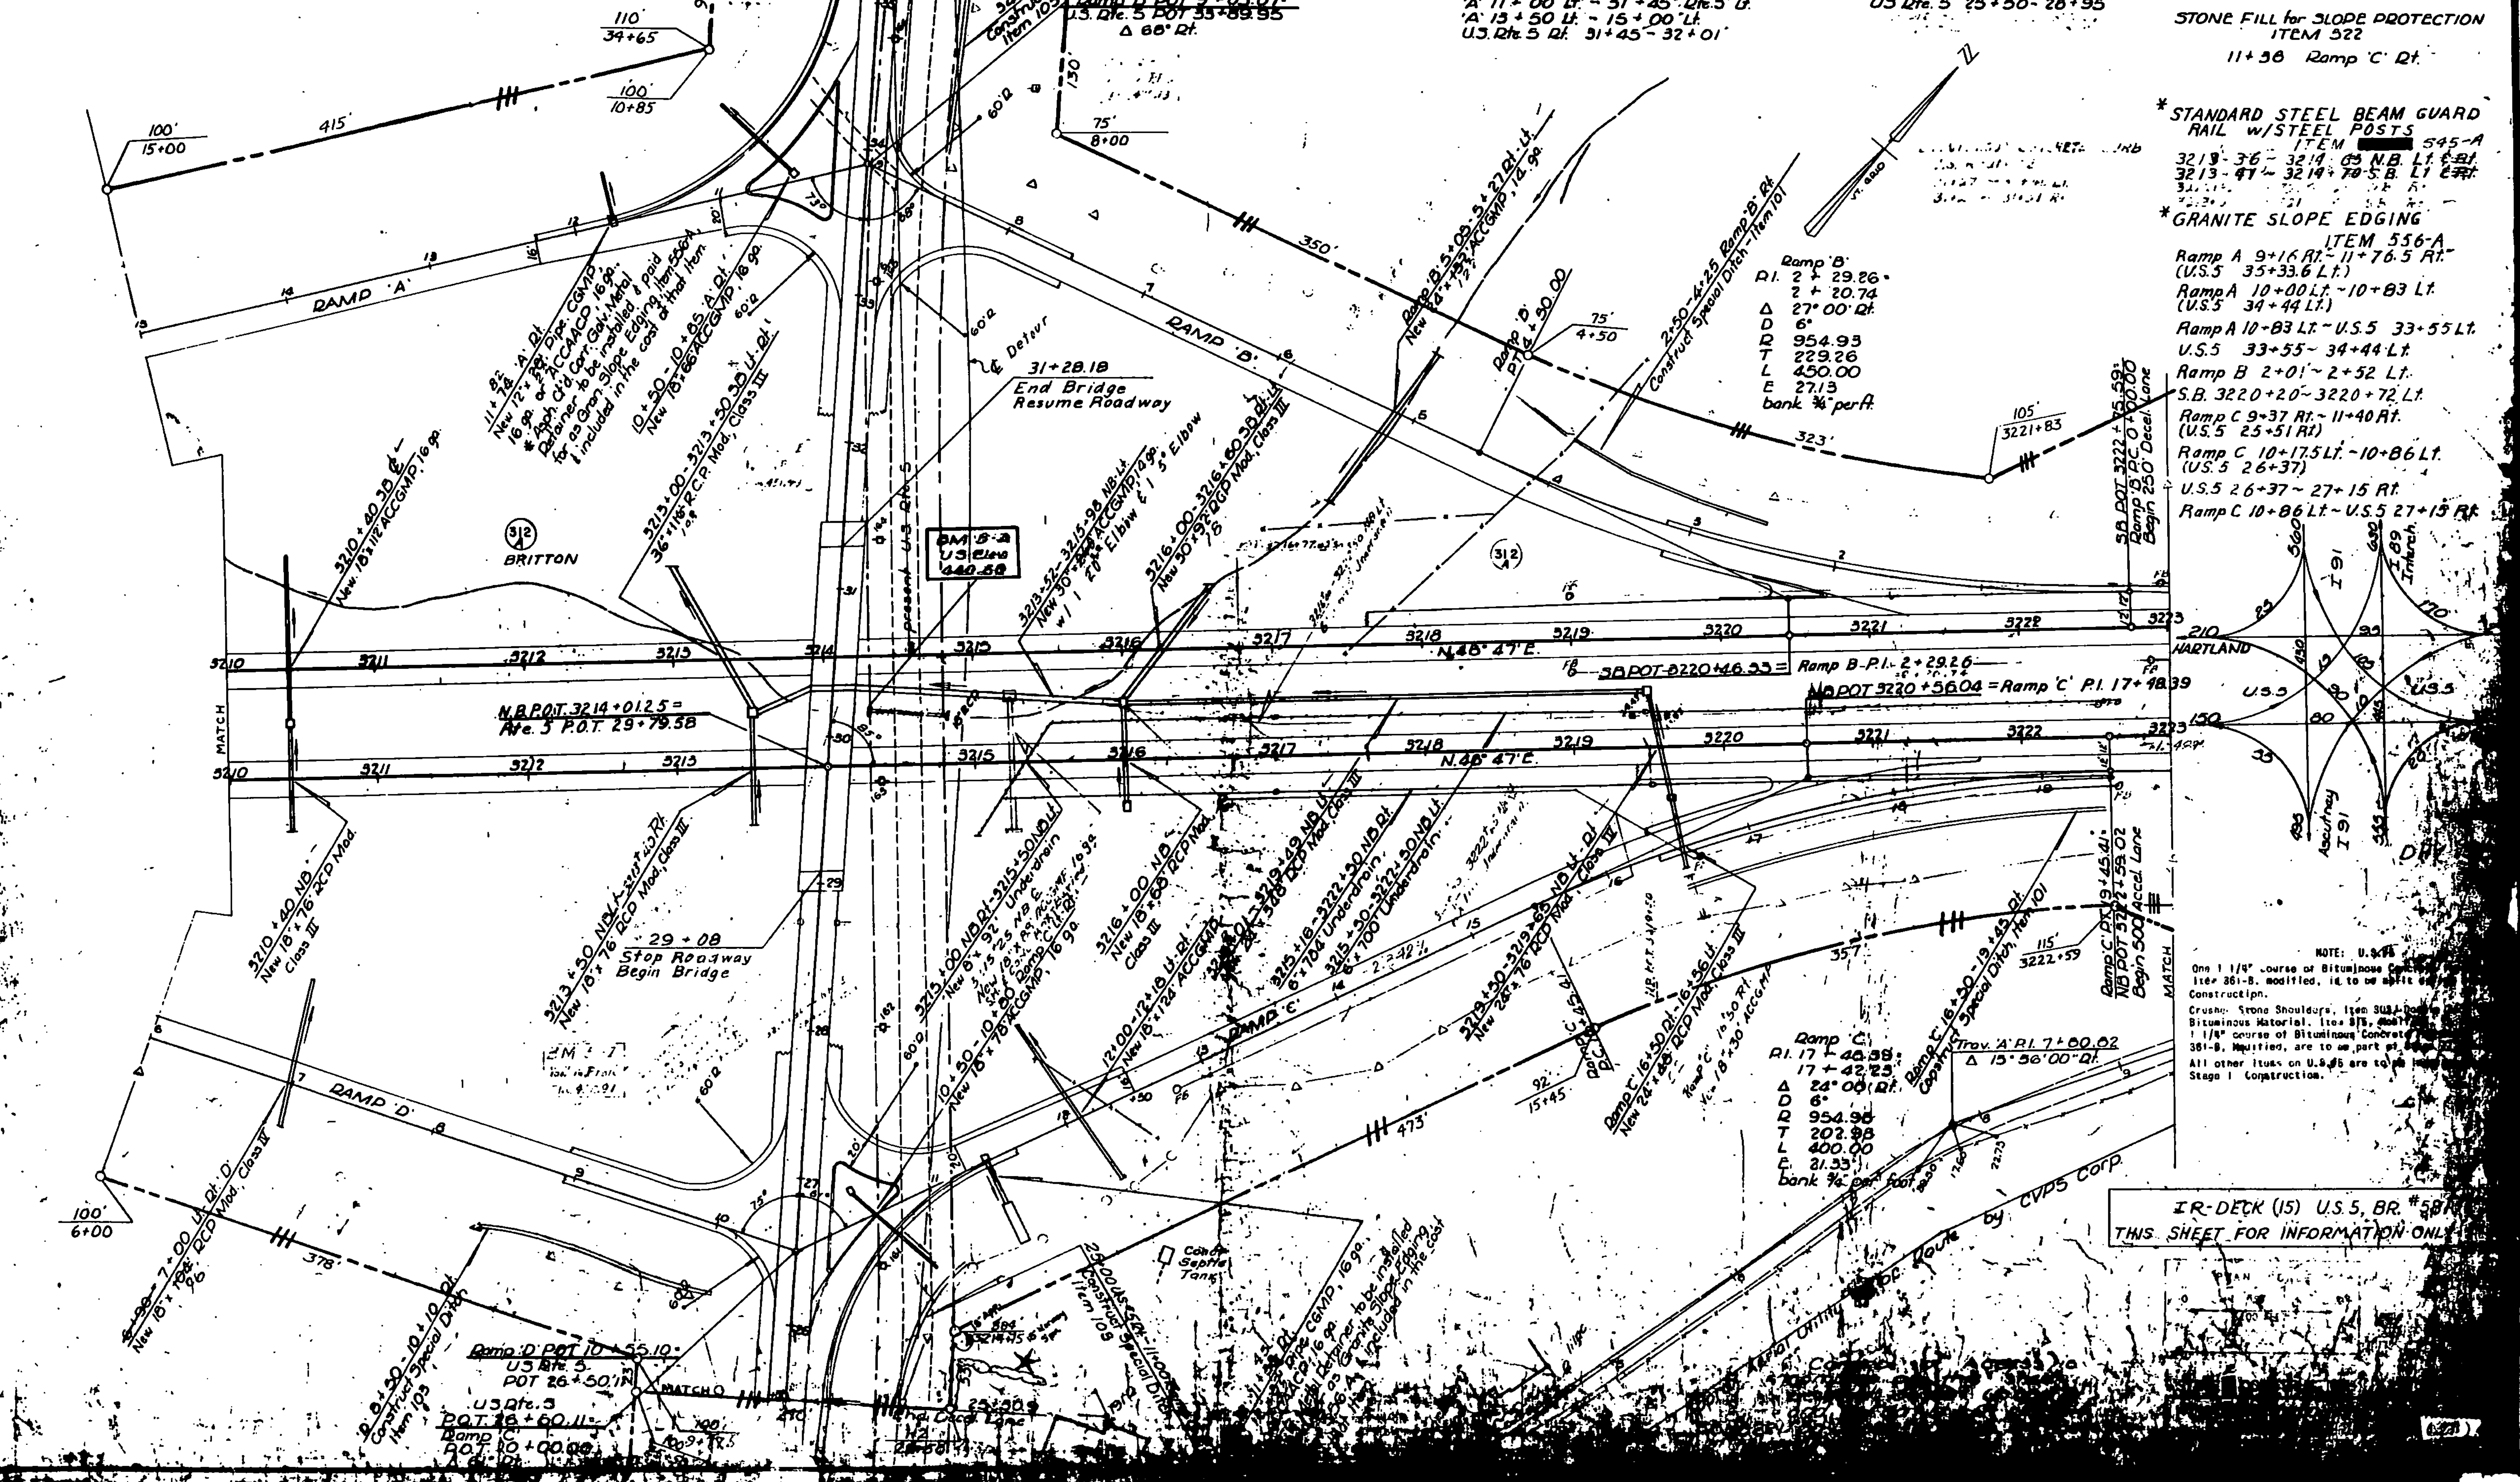

Ramp B:
 P.I. 2+29.26
 2+20.74
 Δ 27°00' Rt.
 D 6'
 R 954.93
 T 229.26
 L 450.00
 E 27.13
 bank 3/4 per ft.

Ramp A 9+16 Rt. - 11+76.5 Rt. (U.S. 35+33.6 Lt.)
 Ramp A 10+00 Lt. - 10+83 Lt. (U.S. 34+44 Lt.)
 Ramp A 10+83 Lt. - U.S. 33+55 Lt. U.S. 33+55 - 34+44 Lt.
 Ramp B 2+01 - 2+52 Lt. S.B. 3220+20 - 3220+72 Lt.
 Ramp C 9+37 Rt. - 11+40 Rt. (U.S. 25+51 Rt.)
 Ramp C 10+17.5 Lt. - 10+86 Lt. (U.S. 26+37)
 U.S. 26+37 - 27+15 Rt.
 Ramp C 10+86 Lt. - U.S. 27+15 Rt.

Ramp C:
 P.I. 17+40.38
 17+42.23
 Δ 24°00' Rt.
 D 6'
 R 954.98
 T 202.98
 L 400.00
 E 21.33
 bank 3/4 per foot

NOTE: U.S. 35
 One 1 1/4" course of Bituminous Concrete, Item 381-B, modified, is to be applied in construction.
 Crush: Stone Shoulders, Item 381-B, modified, is to be applied in construction.
 1 1/4" course of Bituminous Concrete, Item 381-B, modified, is to be applied in construction.
 All other items on U.S. 35 are to be applied in Stage 1 construction.

IR-DECK (15) U.S. 5, BR. #58
 THIS SHEET FOR INFORMATION ONLY