

**GENERAL NOTES:-**

- 1- Elevation datum is sea level based on nearest U.S. Government vertical control.
- 2- For additional notes see SCB-DI-65.

**LIST OF SHEETS:-**

- BR.200 - Plan and Elevation
- 201 - Bridge Quantity Sheet
- 202 - Preliminary Information Sheet
- 203 - Borings
- 204 - Superstructure Spans "1 f 2"
- 205 - Superstructure Spans "3 f 4"
- 206 - Approach Slab No. 1
- 207 - Approach Slab No. 2
- 208 - Abutment No. 1
- 209 - Abutment No. 2
- 210 - Pier No. 1
- 211 - Pier No. 2
- 212 - Pier No. 3
- BR. 21321+ - Reinforcing Steel Schedules


**STANDARD SHEETS**

- G-3a
- SCB-30-65
- SCB-DI thru D9-65
- SB-R1-64 Sheets 1 and 2
- SB-R3-64

**PLAN**

P.V.I. 90+75  
Elev. 687.64  
350' V.C.

+1.5817%      -0.2821%

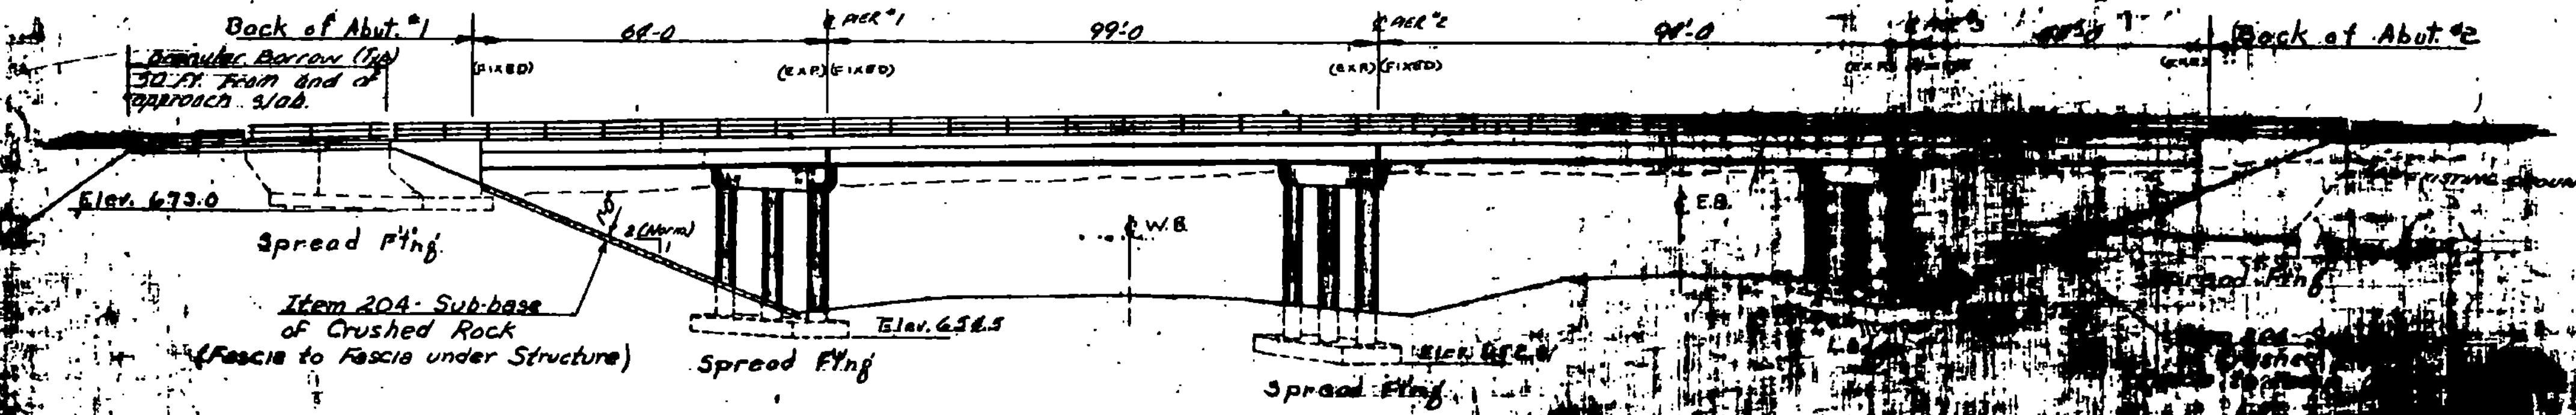

**ELEVATION**

IR-DECK (15)  
THIS SHEET FOR INFORMATION  
BR.200

STATE OF  
DEPARTMENT OF