



Curve Layout
Scale: 1" = 20'

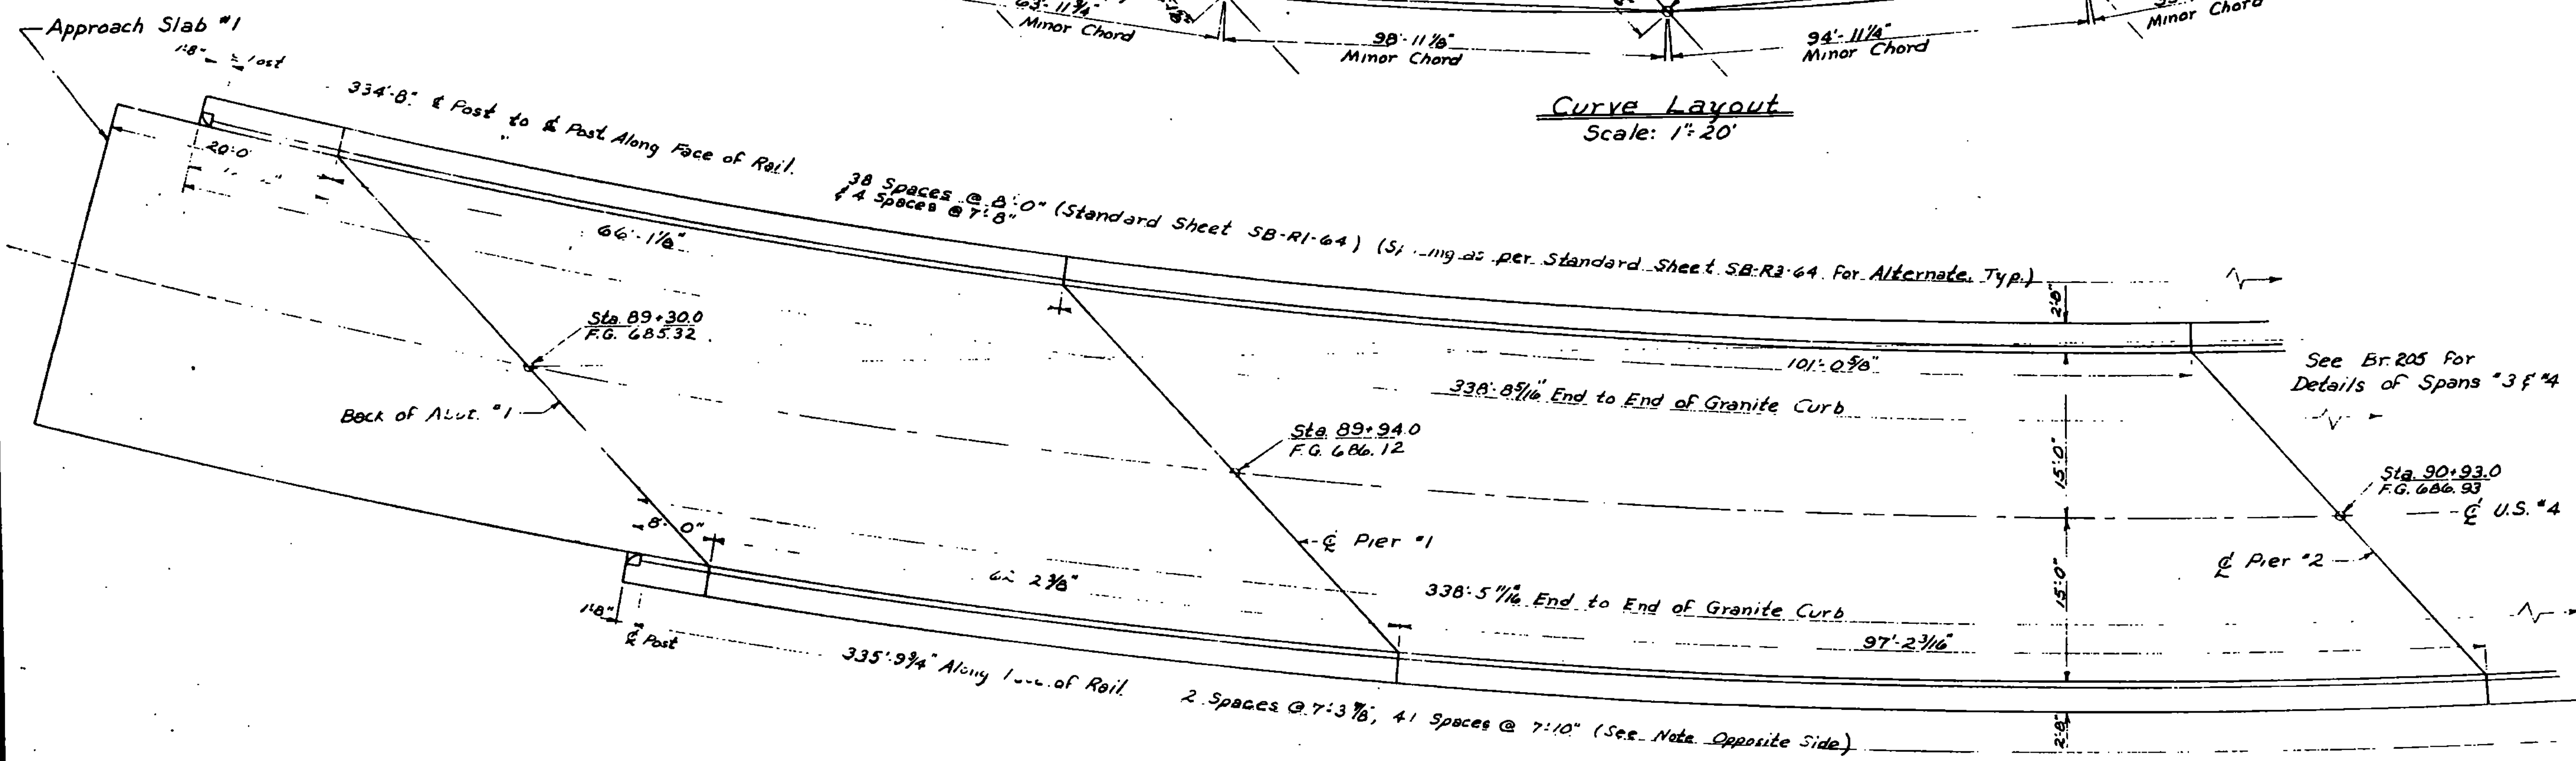

Superstructure Plan - Spans #1 & #2
Scale: 1/8" = 1' 0"

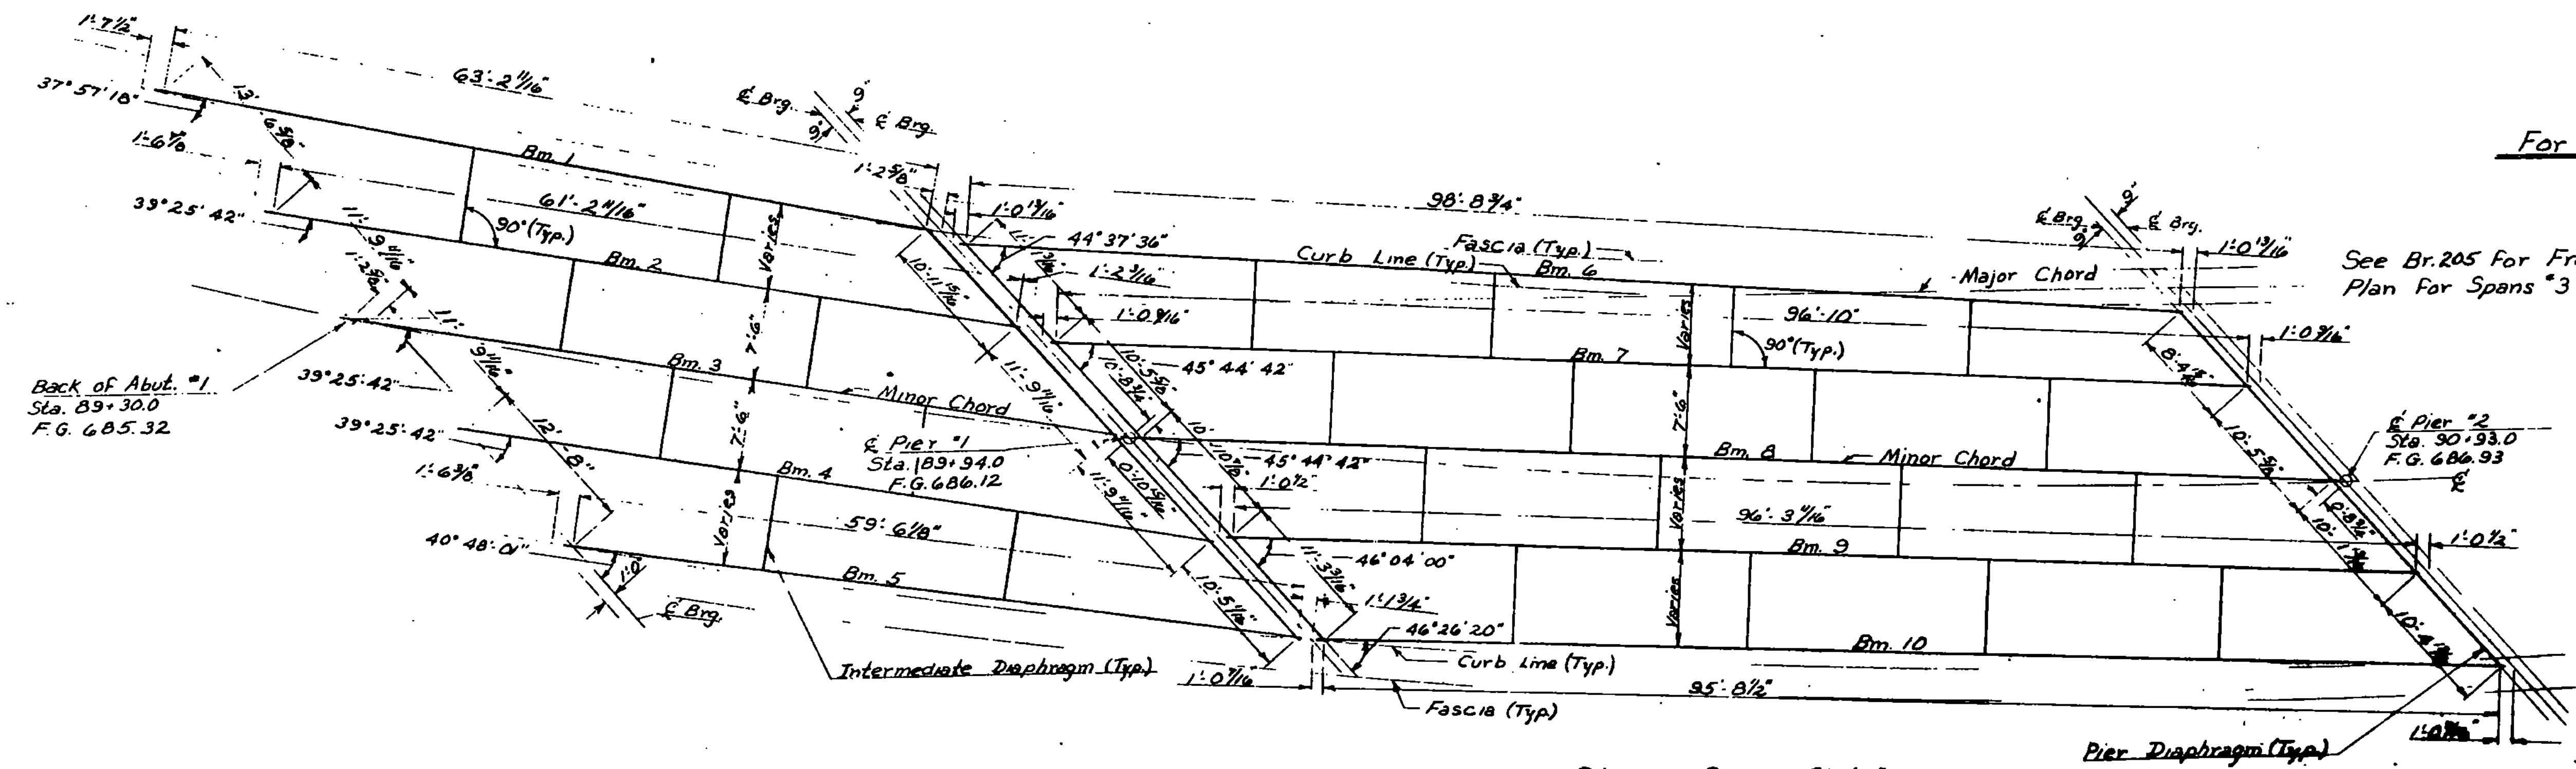

Framing Plan - Spans #1 & #2
Scale: 1/8" = 1' 0"

For Superstructure Notes see Br. 205

See Br. 205 for Framing Plan for Spans #3 & #4.

IR-DECK (15) U.S. #4, BR. #65A
THIS SHEET FOR INFORMATION ONLY
Br. 204 OF 214

STATE OF VERMONT
DEPARTMENT OF HIGHWAYS

TOWN OF Hartford
ROUTE No. U.S. #4 LOG STA. U.S. #4 over I 89
Superstructure - Spans #1 & #2
SCALE As noted

SURVEYED BY _____
DRAWN BY H.B.T. CHECKED BY _____
PROJECT No. 122-122
DATE 11/22/52