

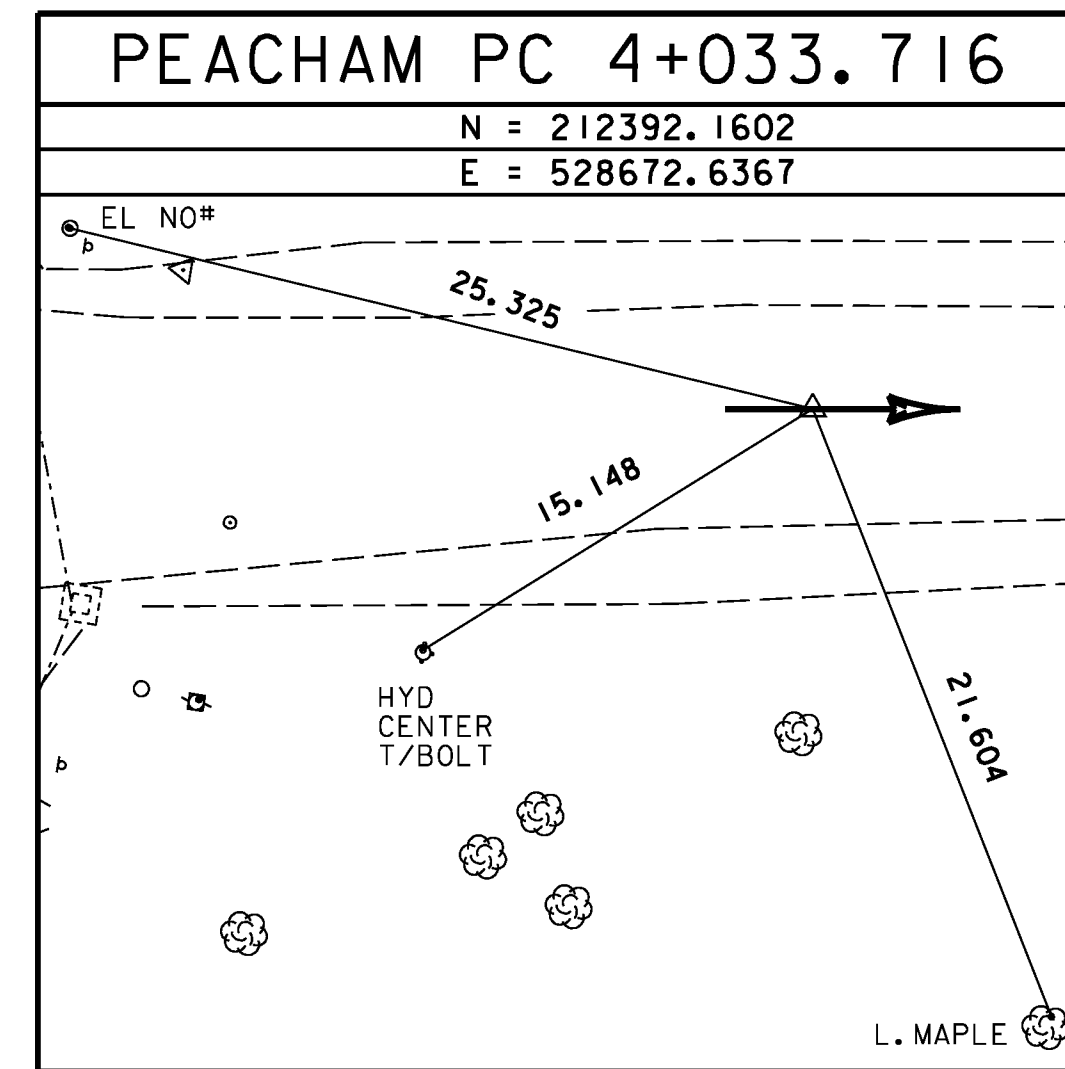
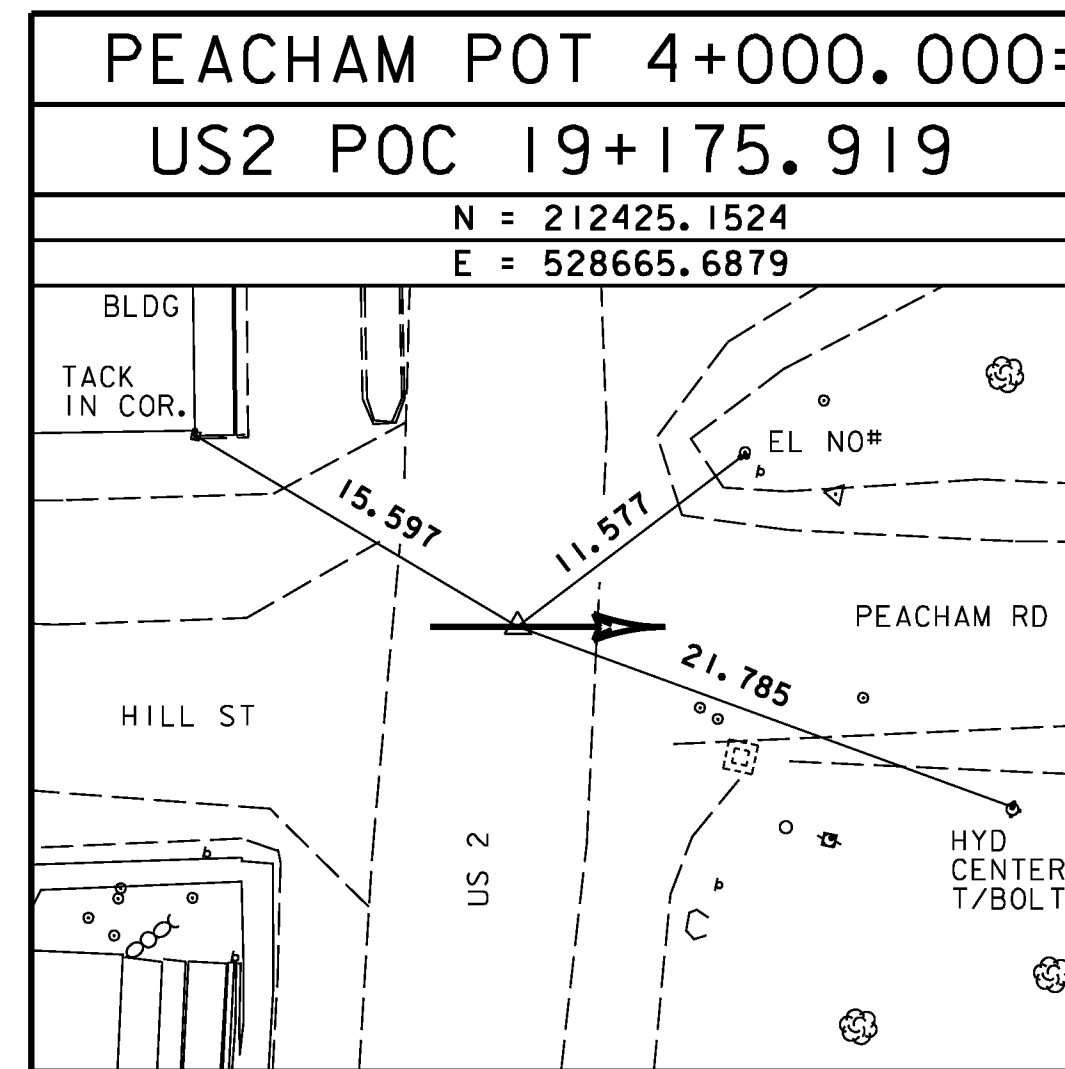
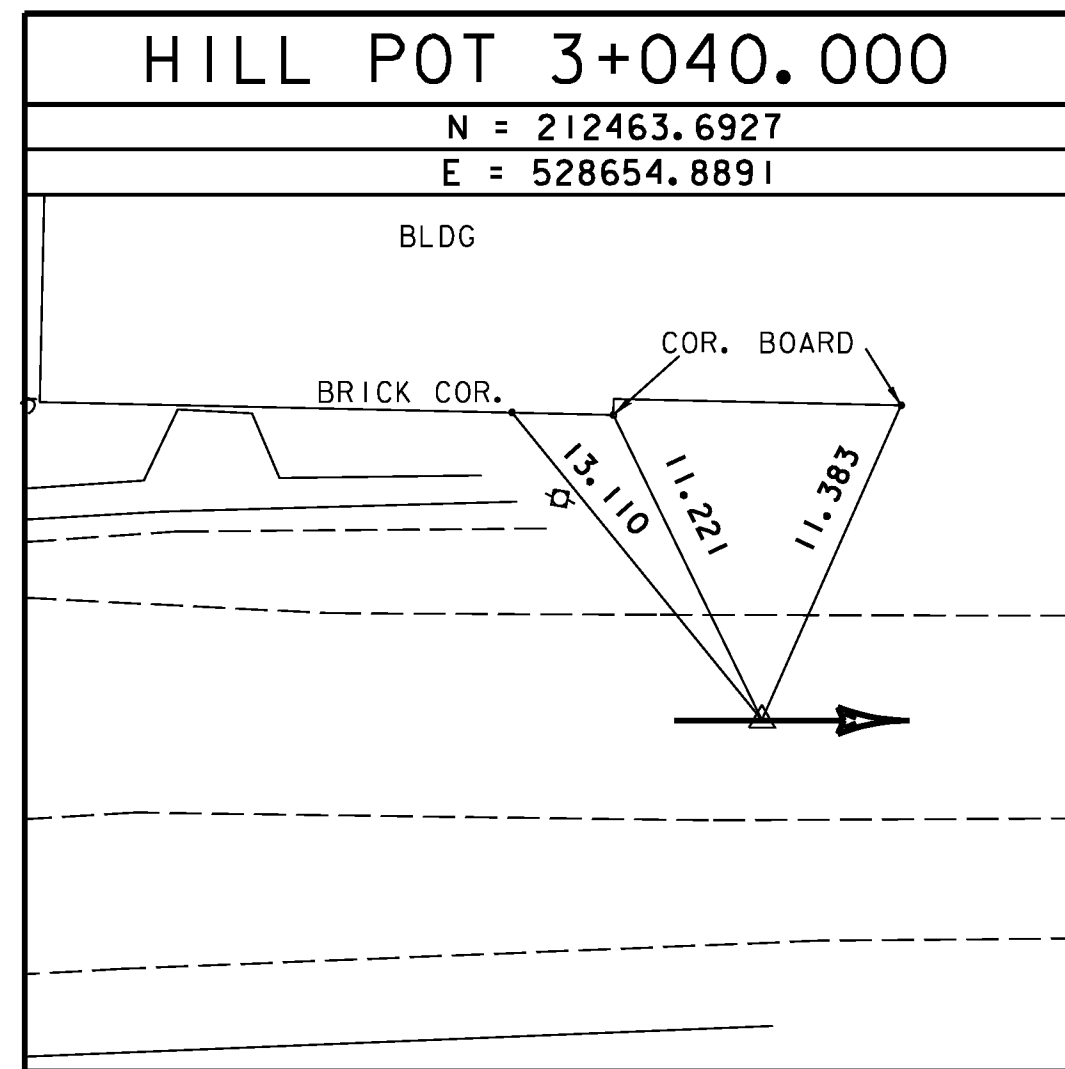
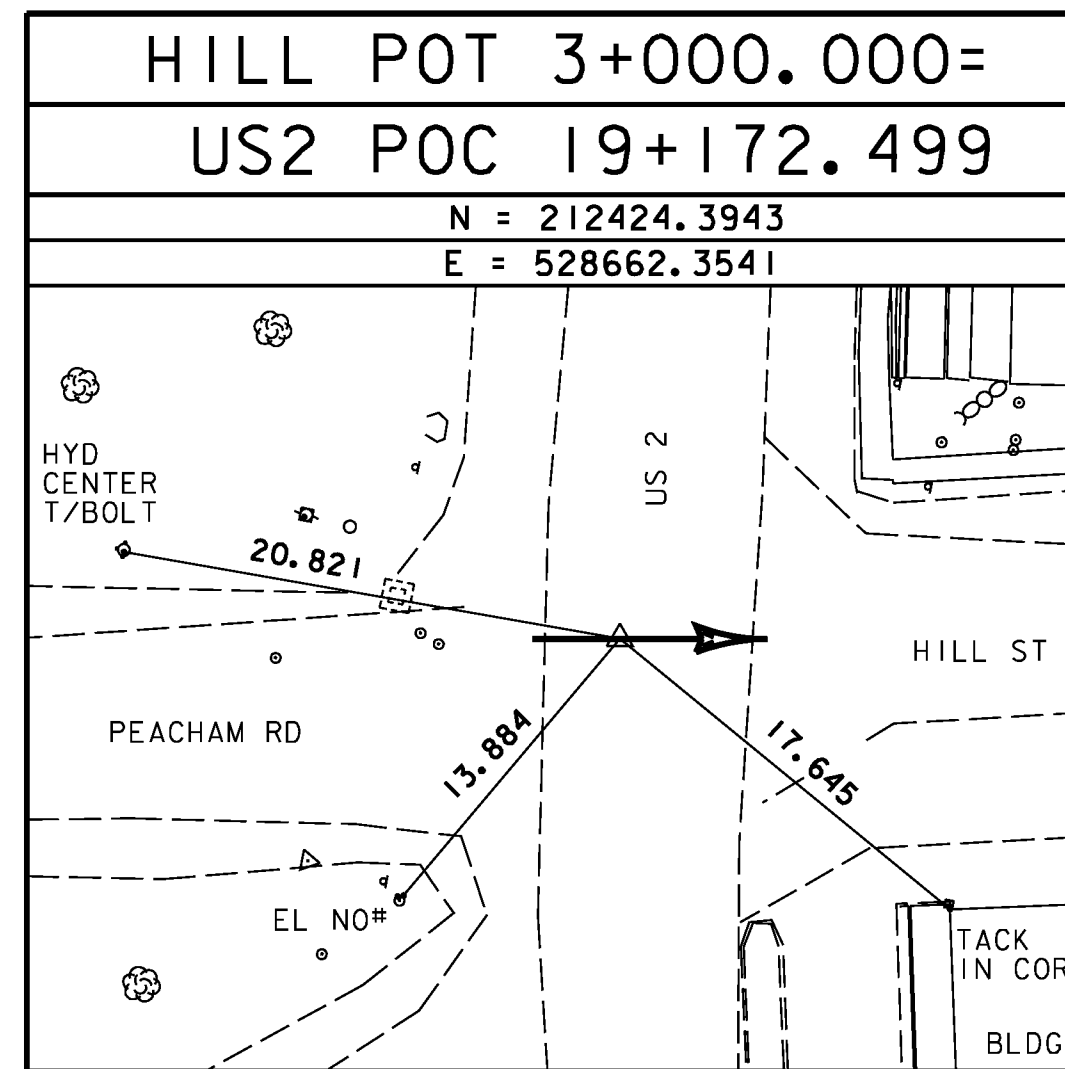
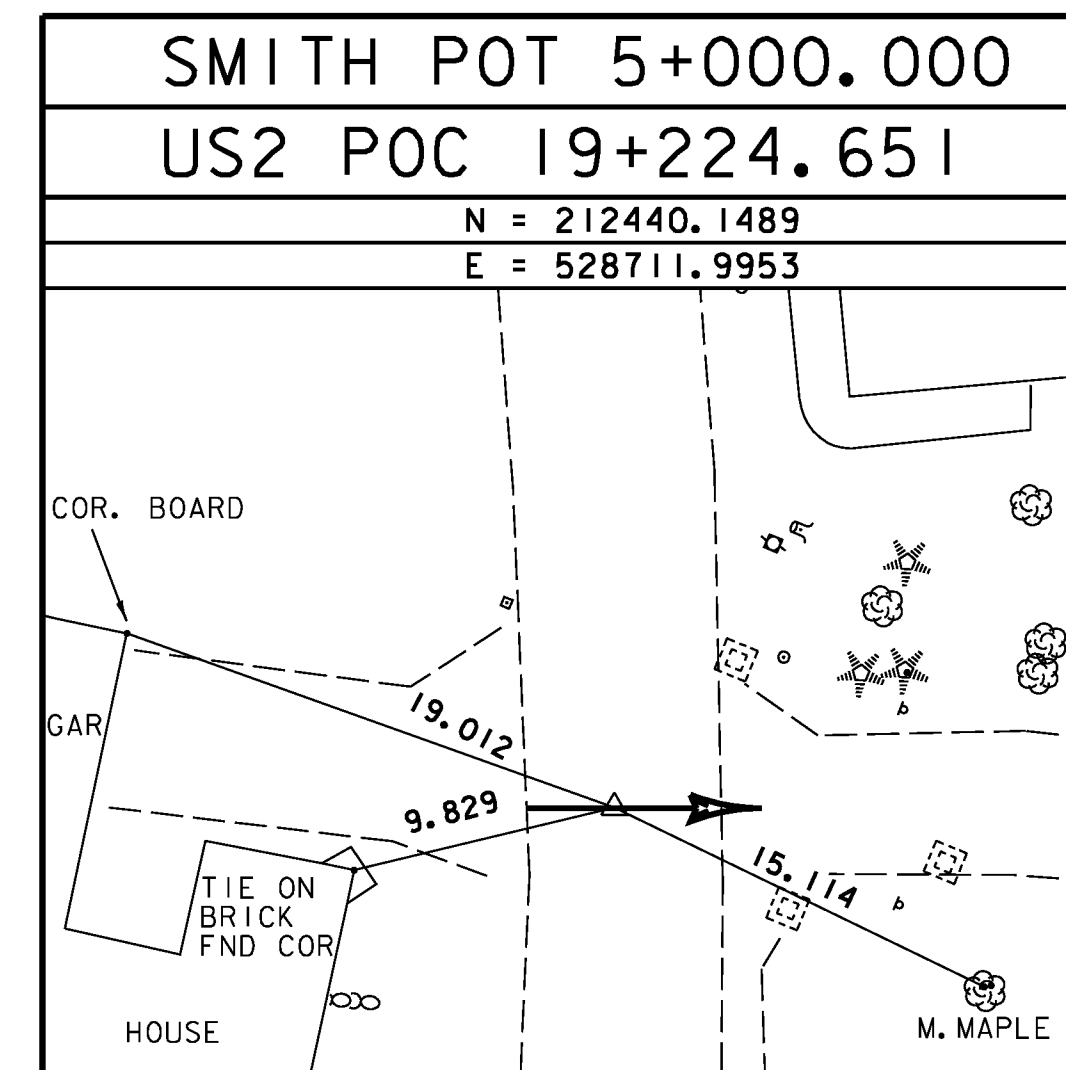
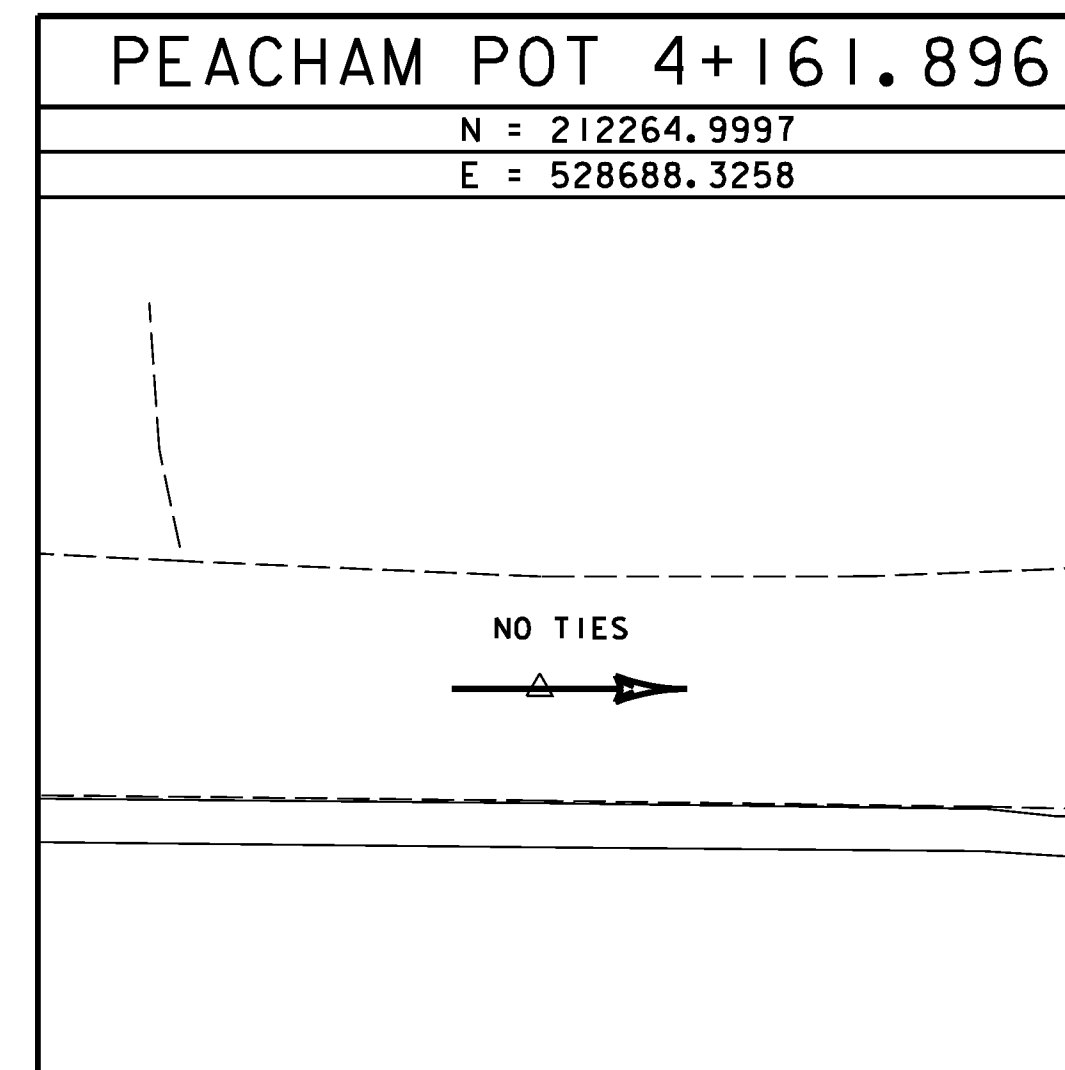
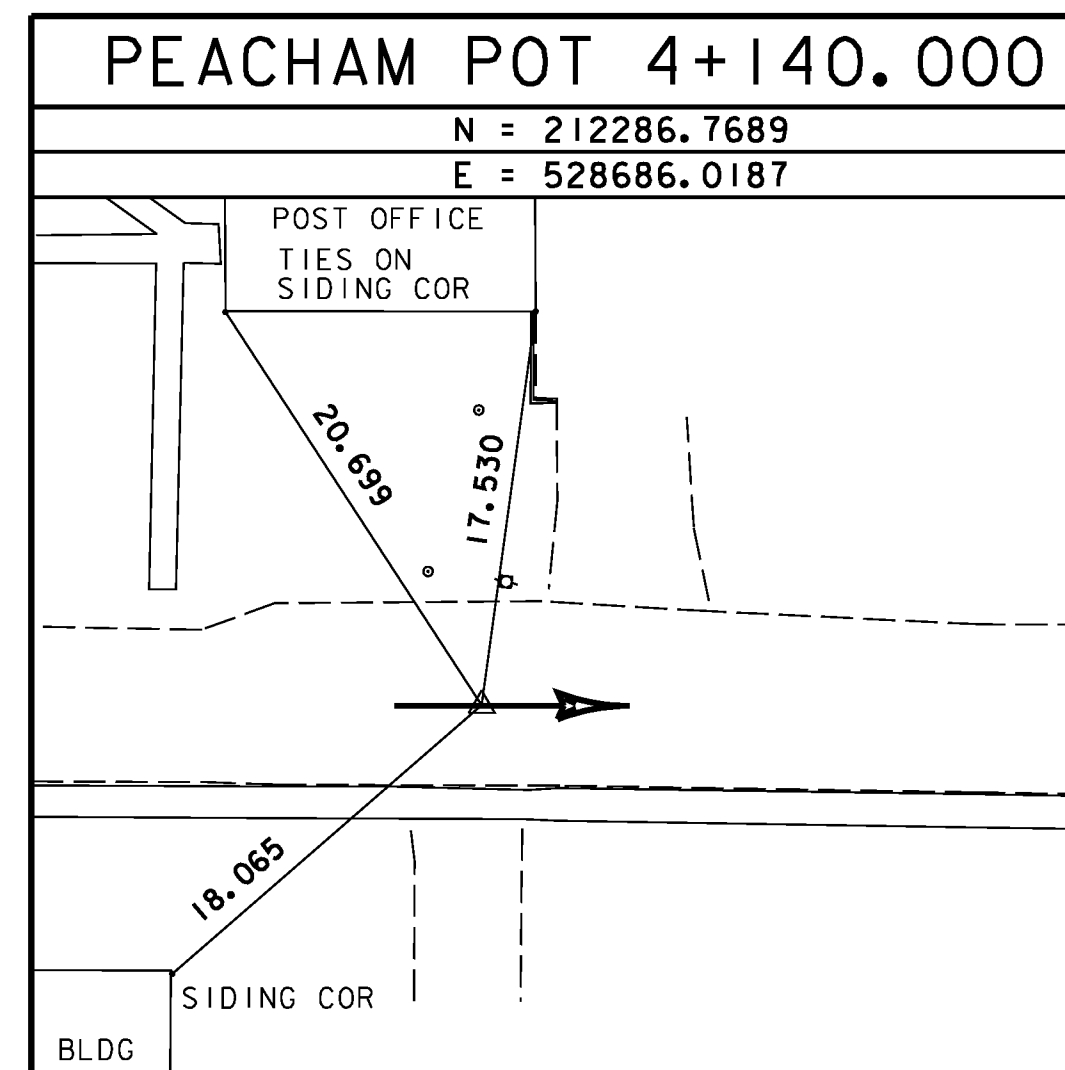


ALIGNMENT TIES

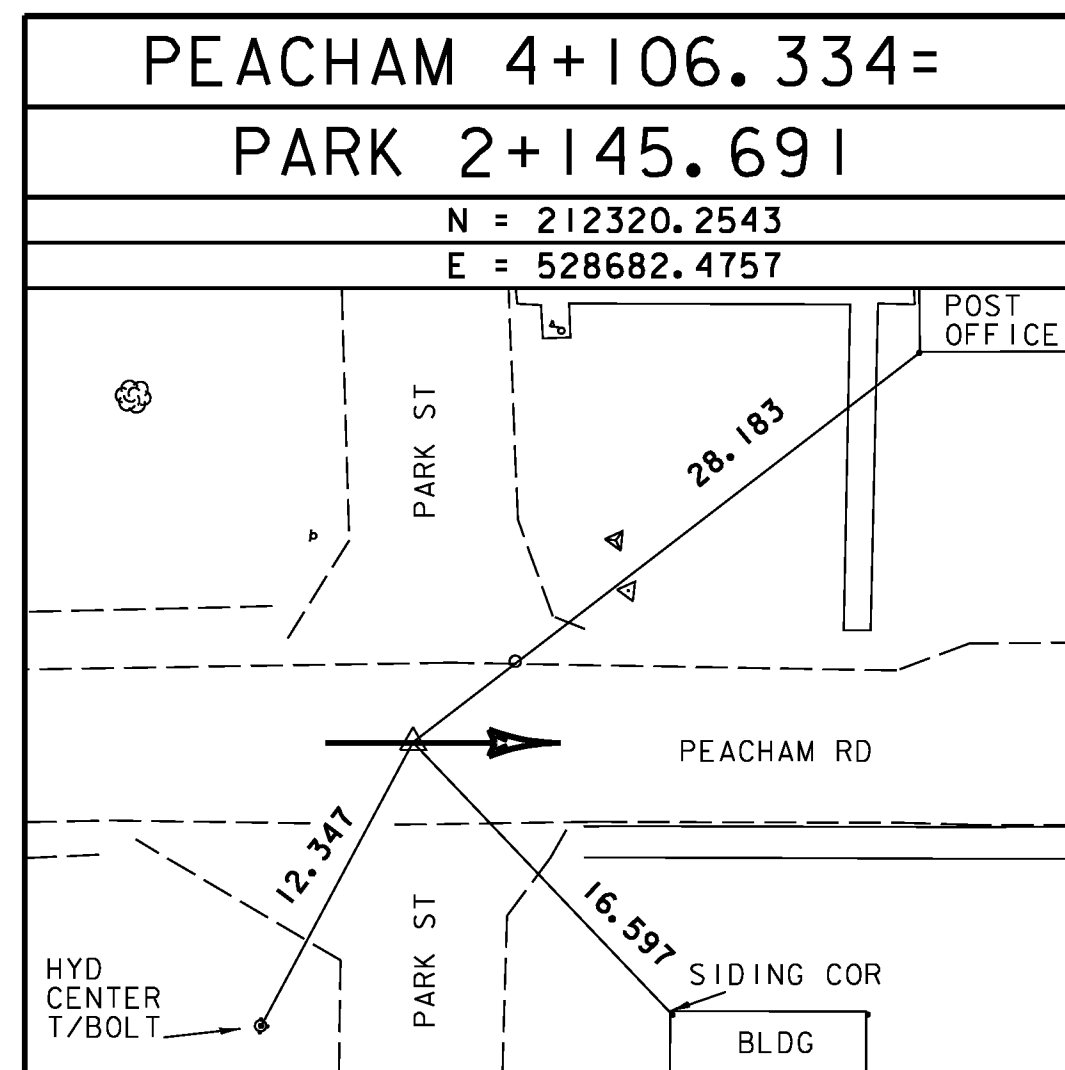






NOTE: ALIGNMENT WAS RUN ON DEC. 1, 2003 BY R.GILMAN PC, P.WINTERS, & D.BREER

ALIGNMENT TIES

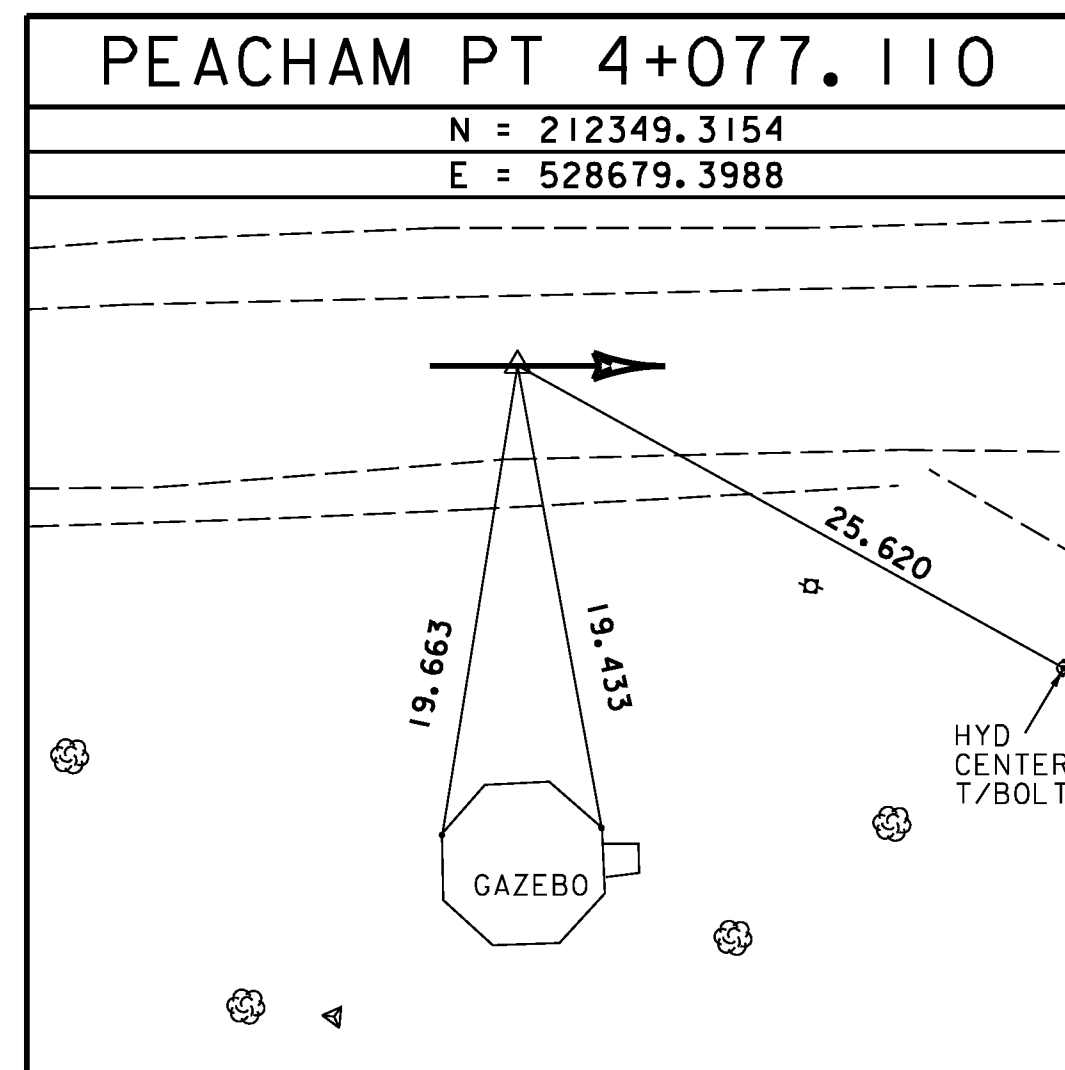

NOTE: ALIGNMENT WAS RUN ON DEC. 1, 2003 BY R.GILMAN PC, P.WINTERS, & D.BREER

ALIGNMENT TIES

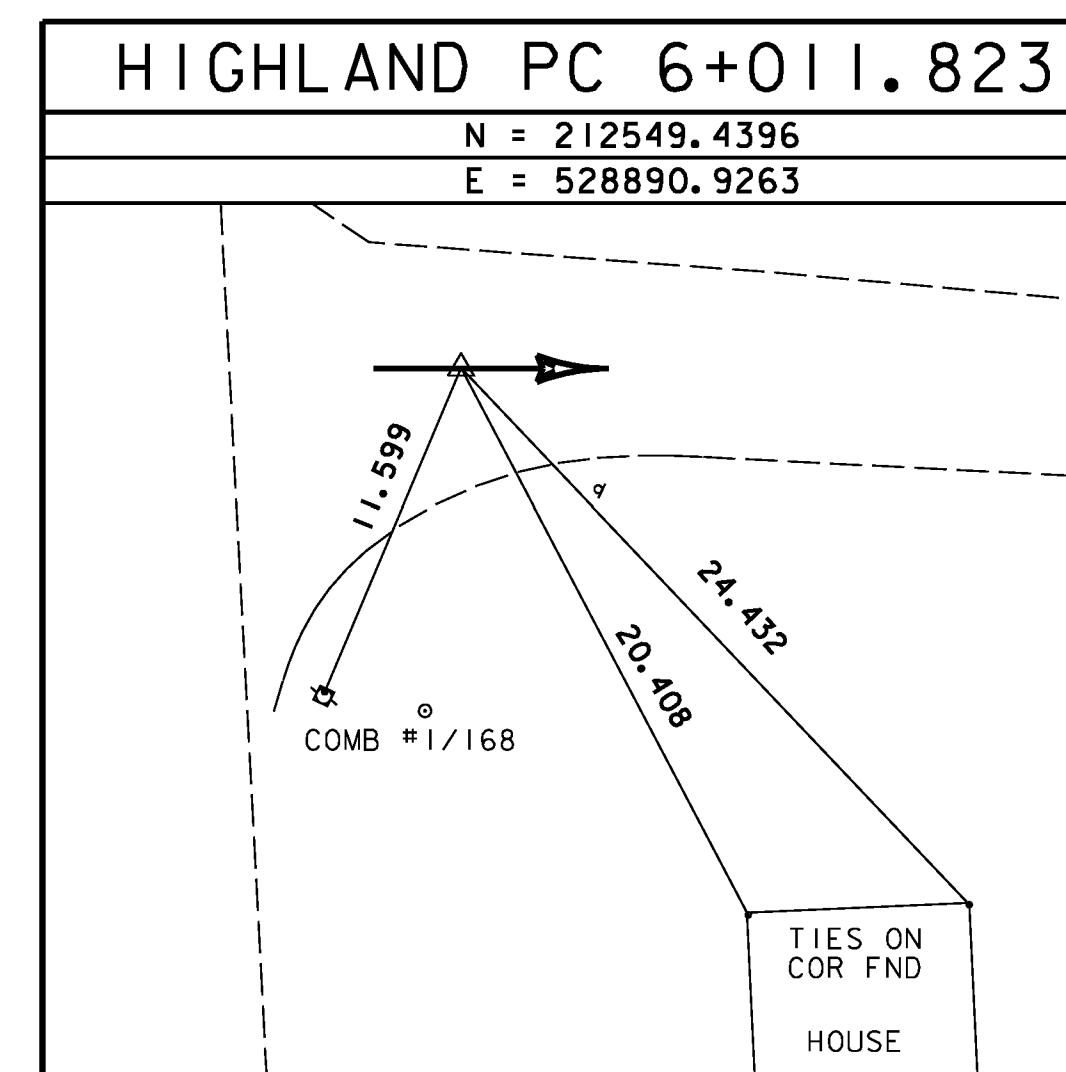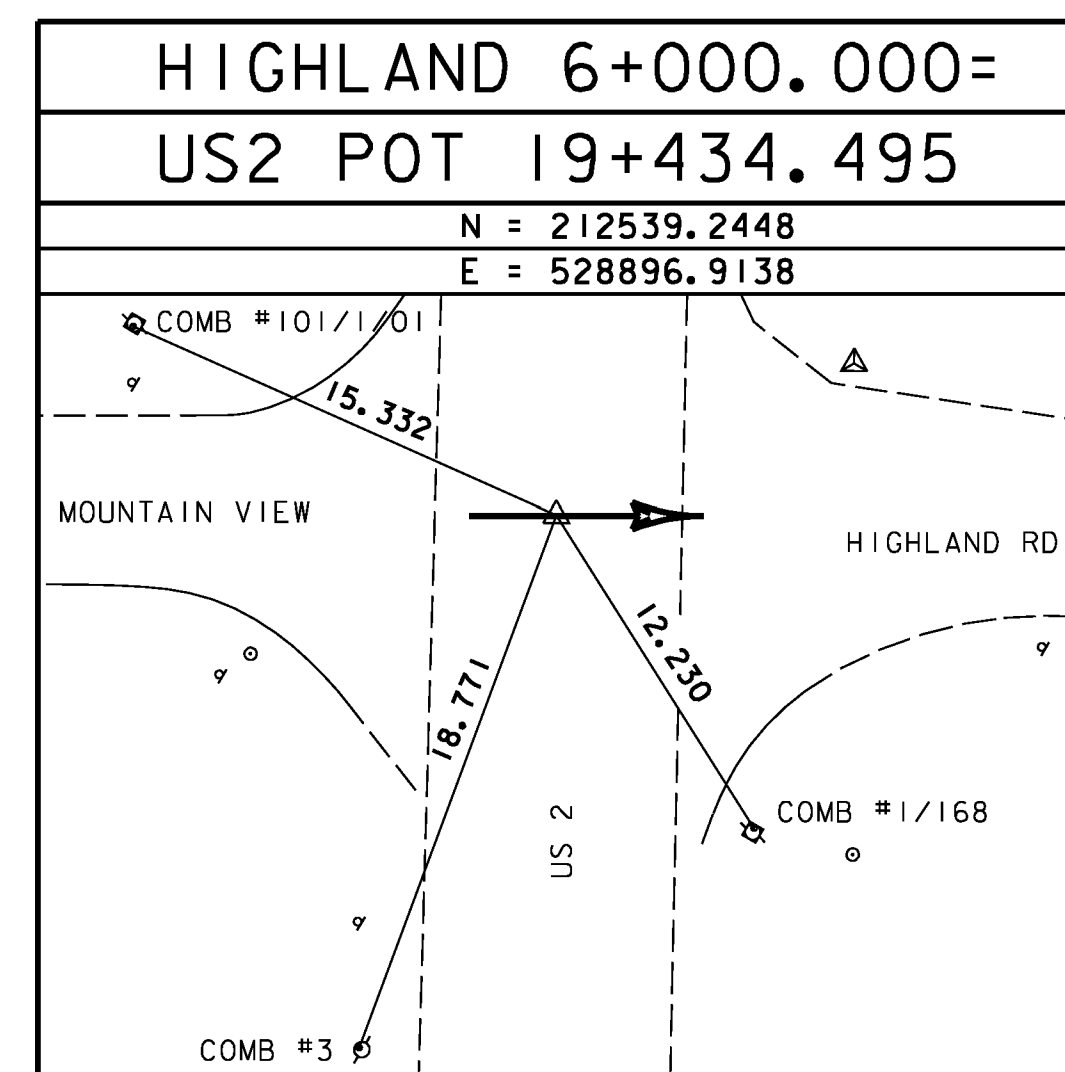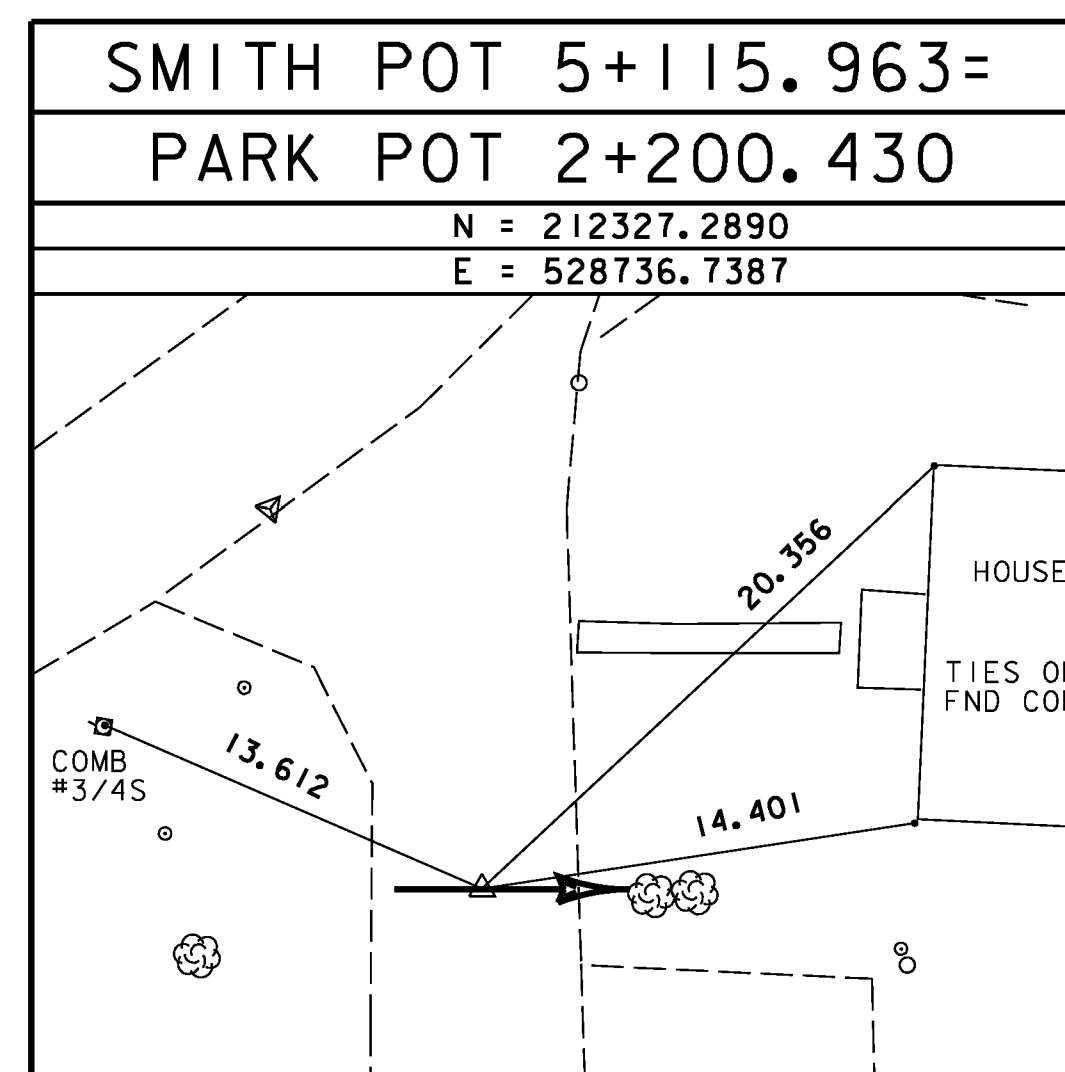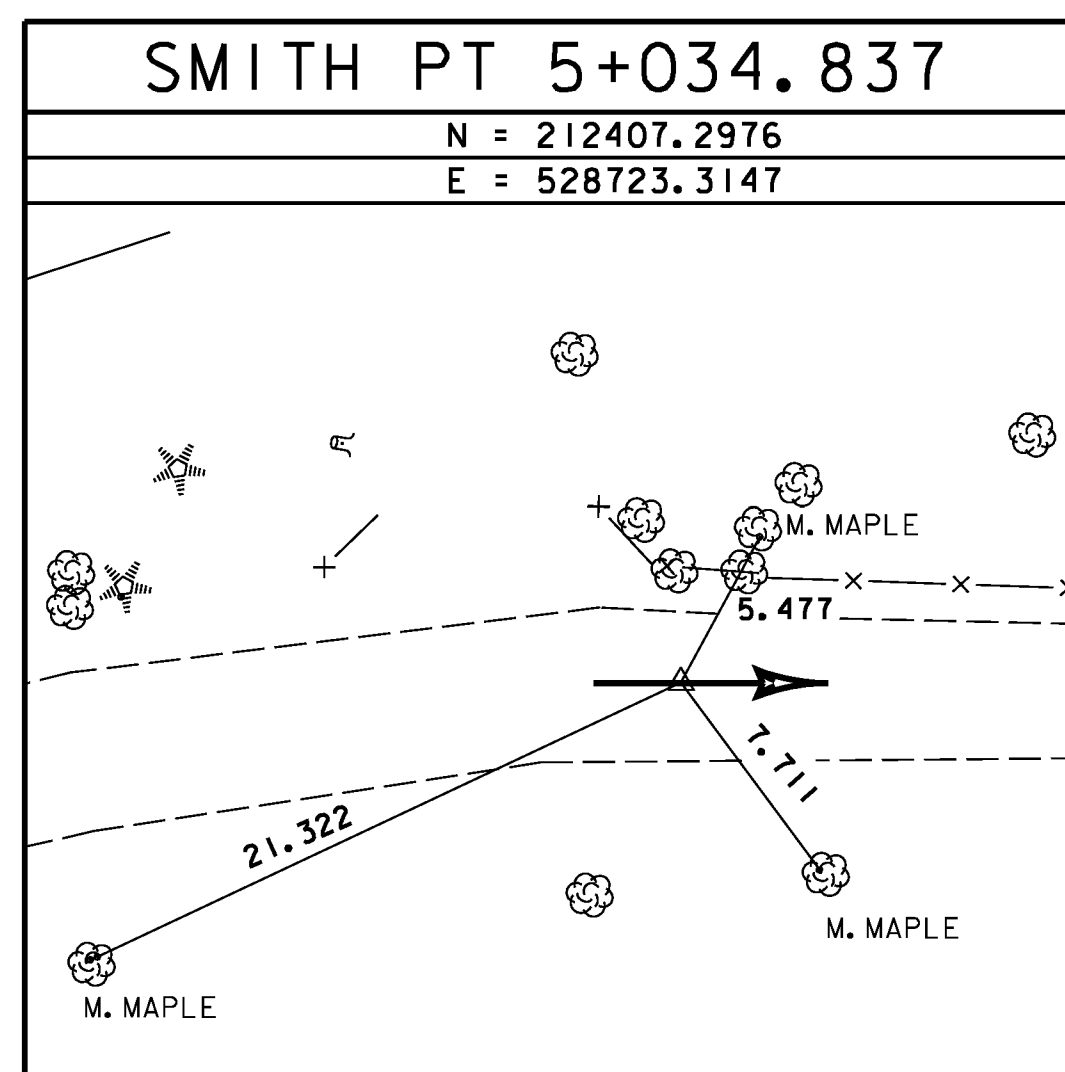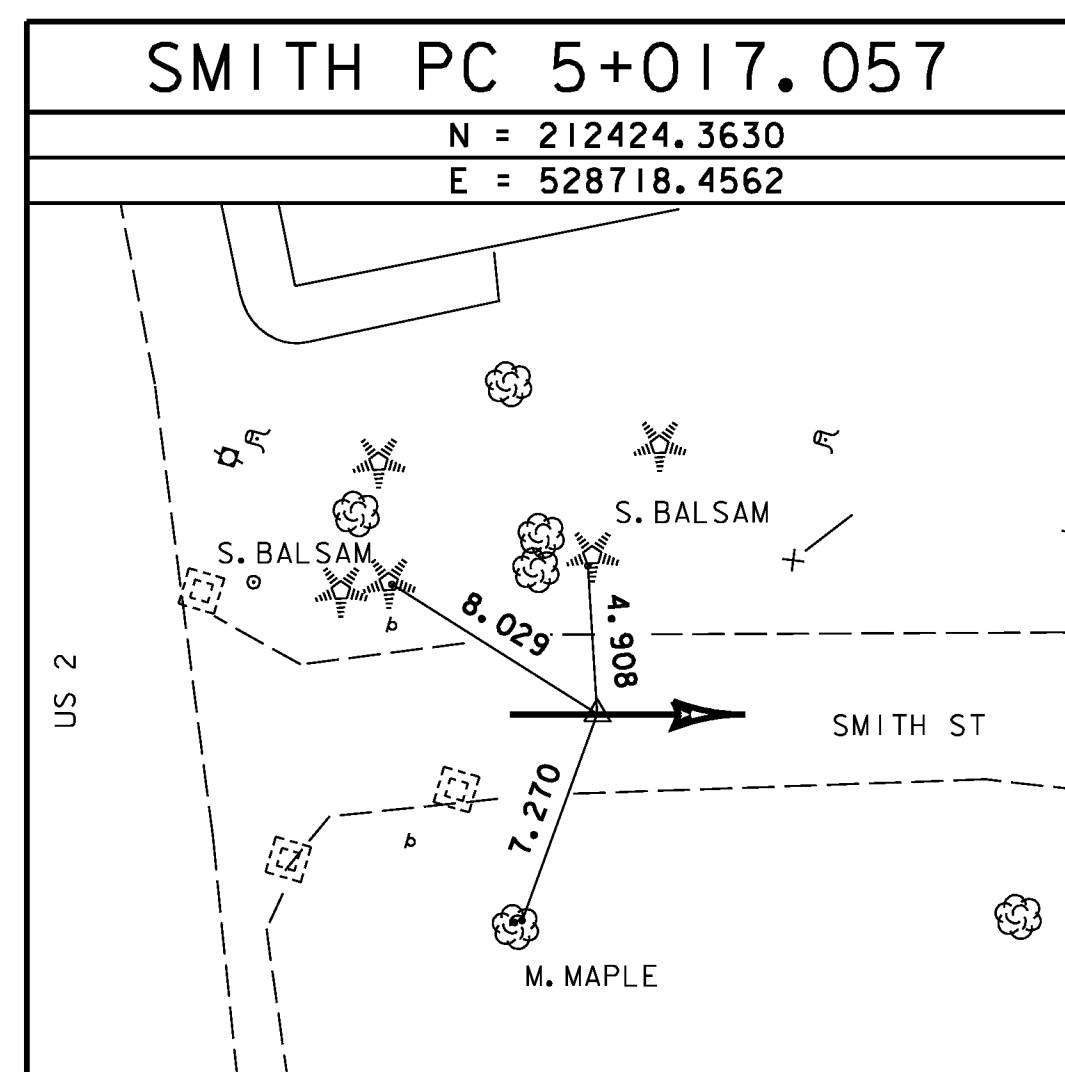

NOTE: ALIGNMENT WAS RUN ON DEC. 1, 2003 BY R.GILMAN PC, P.WINTERS, & D.BREER

PROJECT NAME: DANVILLE
PROJECT NUMBER: F EGC 028-3(32)
FILE NAME: ...\\highway\\PlotFiles\\007 ties.ptf PLOT DATE: 1/18/2011
DESIGN SUPERVISOR: VTRANS DRAWN BY: VTRANS
DESIGNED BY: VTRANS CHECKED BY: VTRANS
TIE SHEET TIE-4 SHEET 47 OF 306