
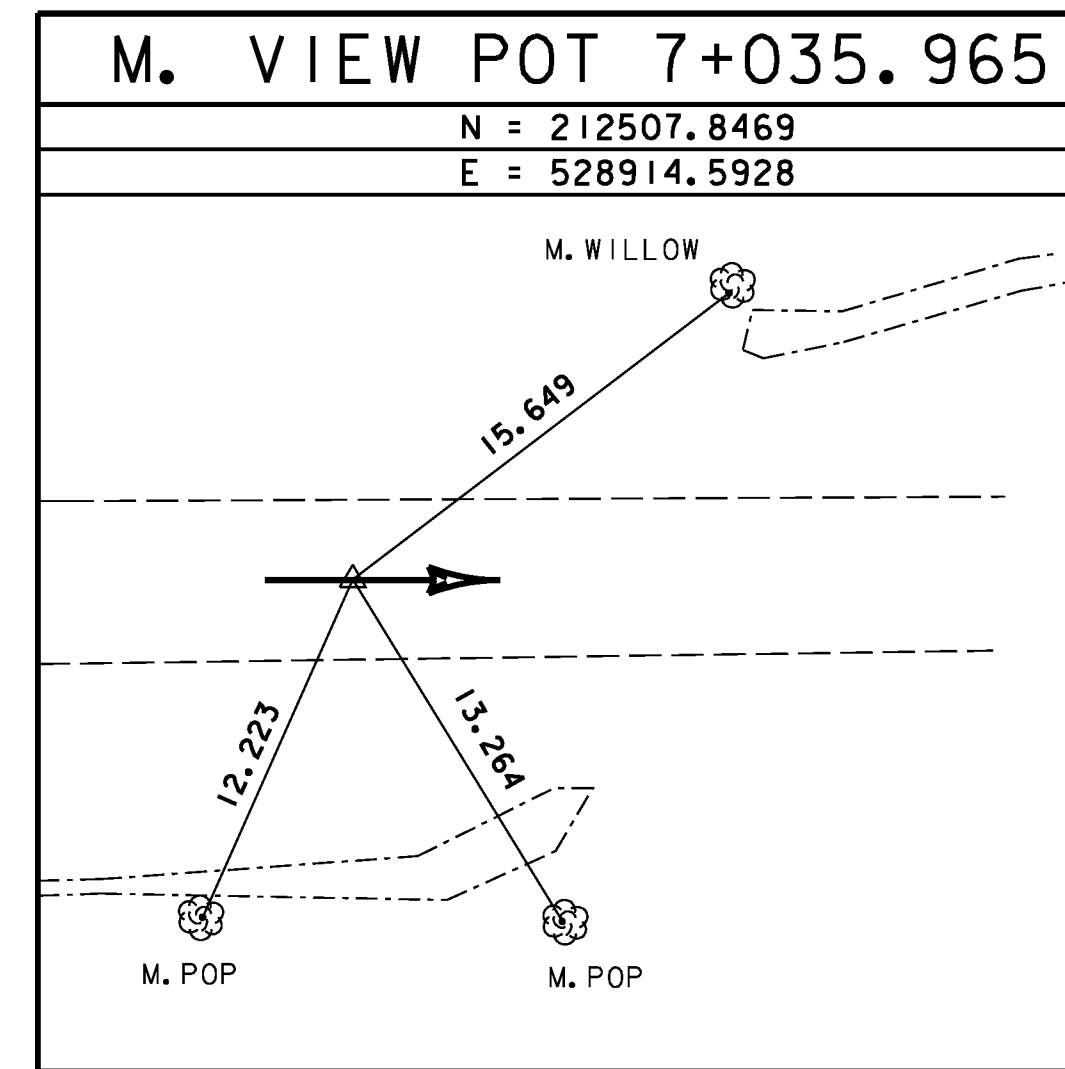
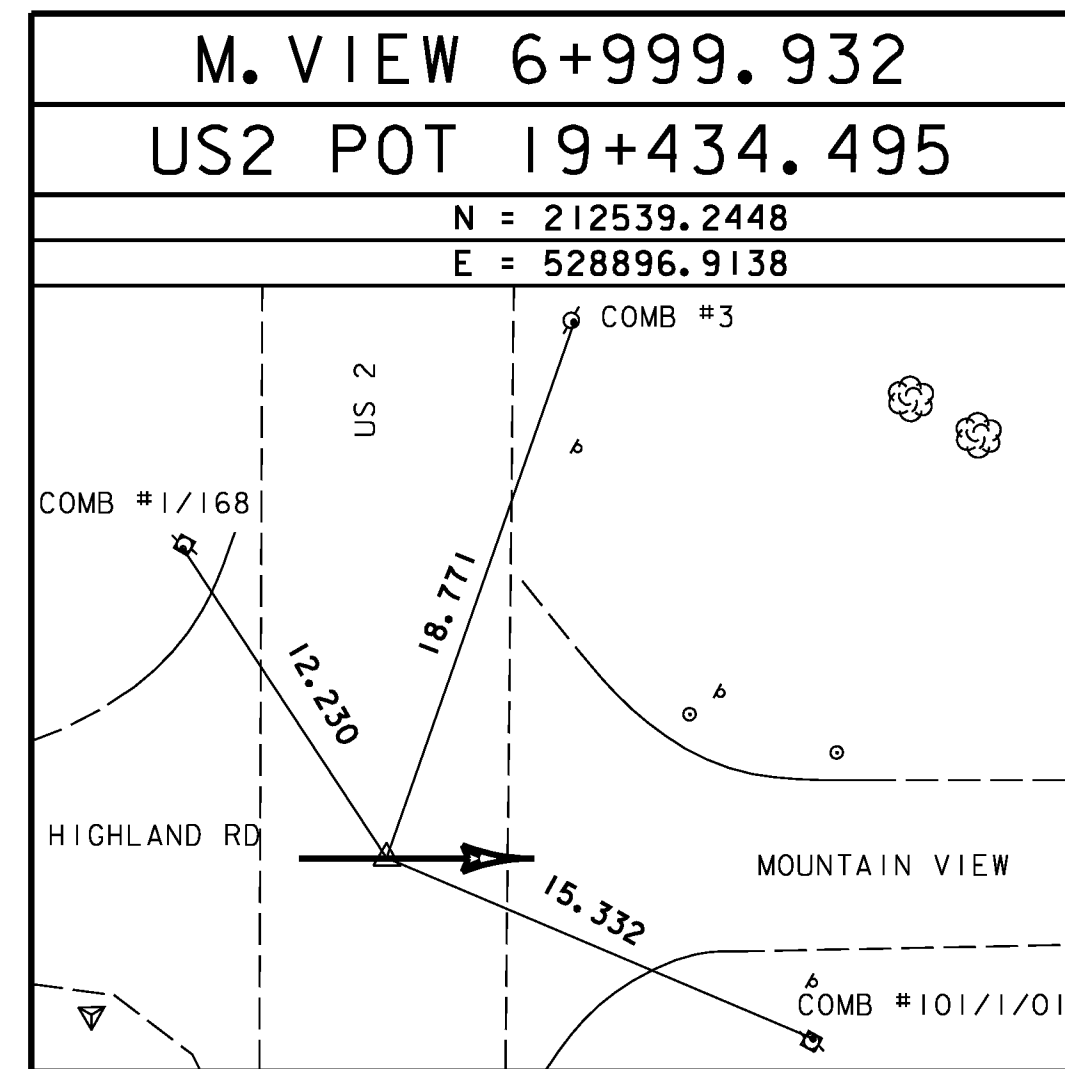
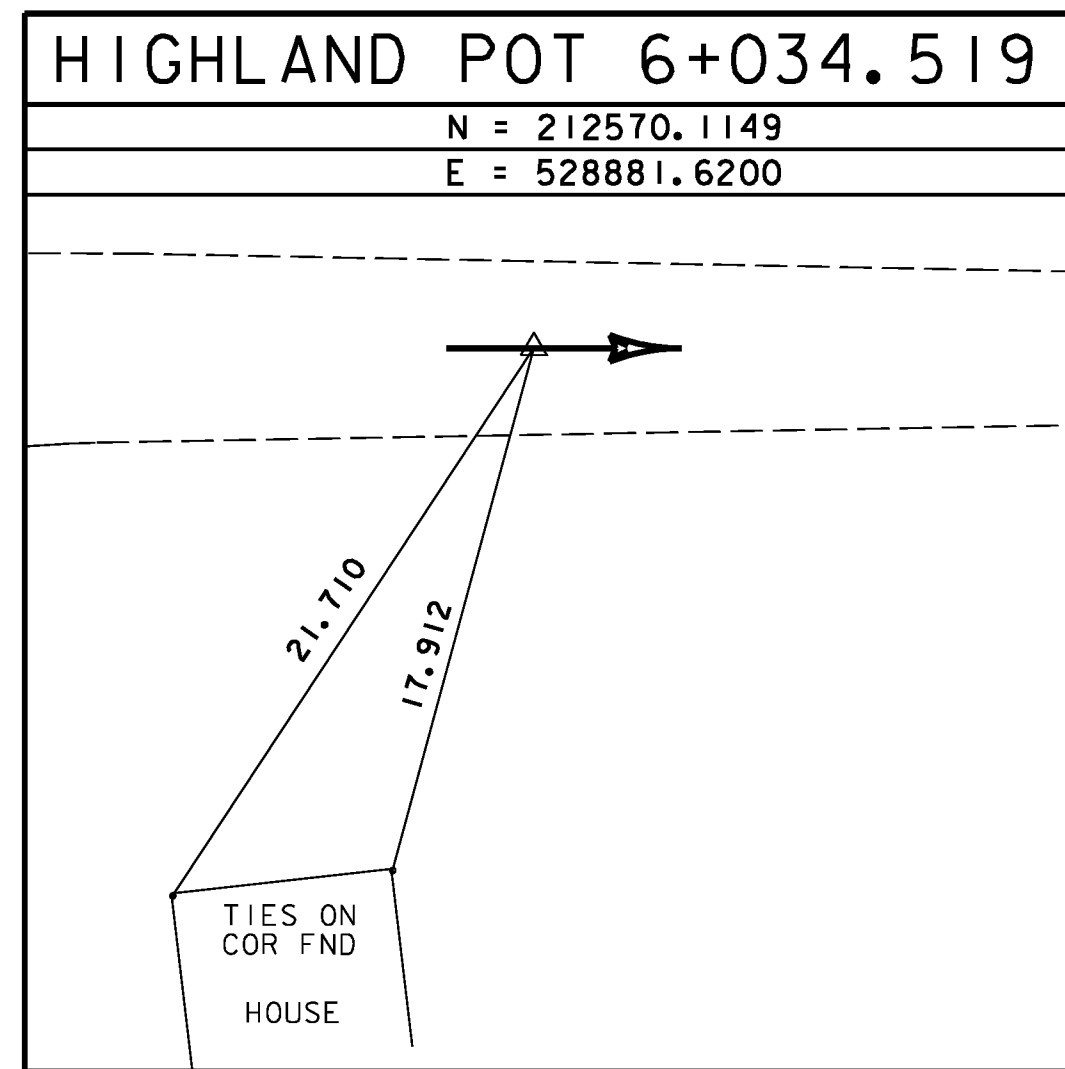


ALIGNMENT TIES

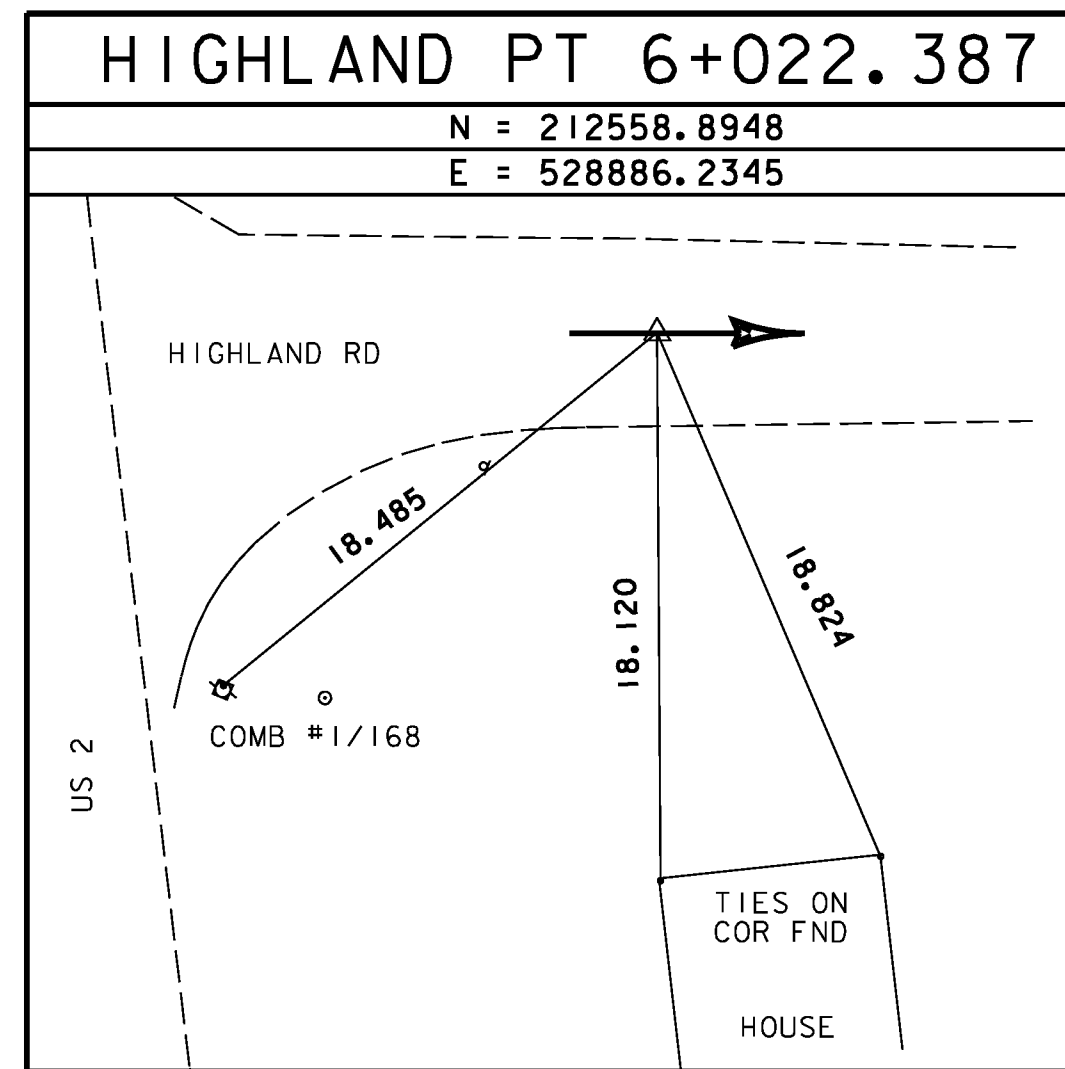

NOTE: ALIGNMENT WAS RUN ON DEC. 1, 2003 BY R.GILMAN PC, P.WINTERS, & D.BREER

ALIGNMENT TIES

ALIGNMENT TIES

PROJECT NAME: DANVILLE
 PROJECT NUMBER: F EGC 028-3(32)
 FILE NAME: ...\\highway\PlotFiles\007 ties.ptf PLOT DATE: 1/18/2011
 DESIGN SUPERVISOR: VTRANS DRAWN BY: VTRANS
 DESIGNED BY: VTRANS CHECKED BY: VTRANS
TIE SHEET TIE-5 SHEET 48 OF 306