

CURVE DATA


US ROUTE 2
 CURVE # 1 DATA
 $\Delta = 9^{\circ}27'44.438''$ RT
 $R = 1746.398$
 $T = 144.537$
 $L = 288.416$
 $E = 5.971$
 BANK = 2%

**DRIVE LAYOUT POINTS
 (TIE TO CONSTRUCTION ζ)**

POINT	STATION	OFFSET
D1	18+519.87	5.54 LT
D2	18+521.32	9.64 LT
D3	18+525.32	9.64 LT
D4	18+527.87	5.34 LT

STA 18+507.730 TO 18+600

DATUM	
VERTICAL	NAVD88
HORIZONTAL	NAD83(92)

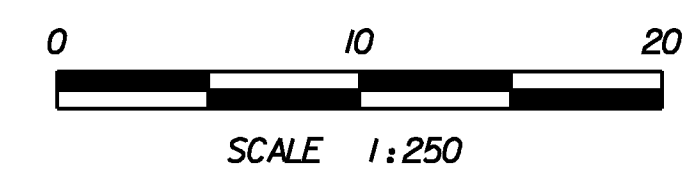

PROJECT NAME: DANVILLE	PLOT DATE: 1/18/2011
PROJECT NUMBER: F EGC 028-3(32)	DRAWN BY: STANTEC
FILE NAME: ...highway\plotfiles\alc-01.ppt	DESIGNED BY: STANTEC
DESIGN SUPERVISOR: GARY SANTY	CHECKED BY: STANTEC
ALIGNMENT/CURBLINE PLAN ALC-1	SHEET 49 OF 306

1/18/2011 11:50:04 PM v:\1853\active\18530033_0192\highway\plotfiles\alc-01.ppt