


US ROUTE 2 - 18+410 TO 18+600

LEFT	e = +0.020
CONST. ξ (PGL)	
RIGHT	e = -0.020

STA 18+600.000
LEFT e = 0.020
RIGHT e = -0.020

7/18/2011 11:40:00 PM v:\1953\active\1953\0033_0952\Highway\PlotFiles\us2prc.plt

DATUM
VERTICAL NAVD88
HORIZONTAL NAD83(92)

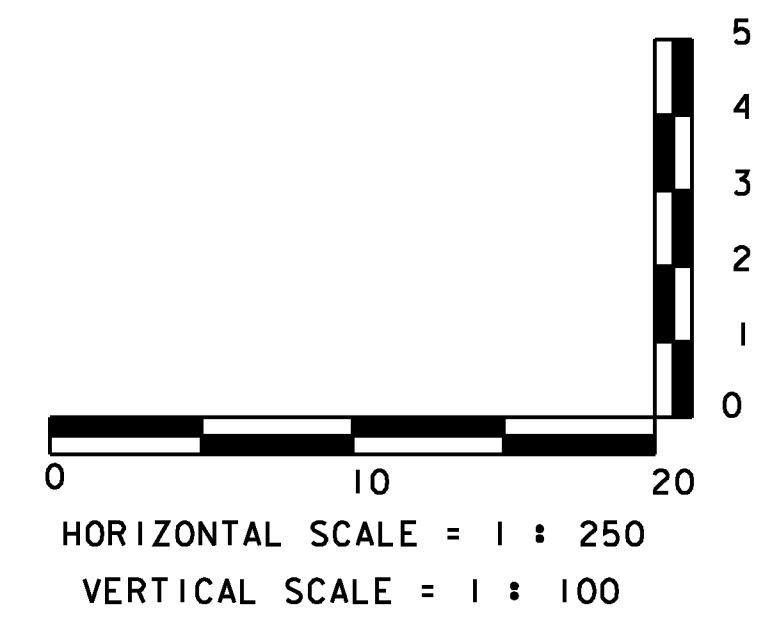

PROJECT NAME: DANVILLE
PROJECT NUMBER: F EGC 028-3(32)
FILE NAME: ...PlotFiles\us2pro.plt PLOT DATE: 1/18/2011
DESIGN SUPERVISOR: GARY SANTY DRAWN BY: STANTEC
DESIGNED BY: STANTEC CHECKED BY: STANTEC
PROFILE - US ROUTE 2 PRO-1 SHEET 74 OF 306

18+410 - 18+600