


US ROUTE 2 - 18+930 TO 19+070

DATUM	
VERTICAL	NAVD88
HORIZONTAL	NAD83(92)

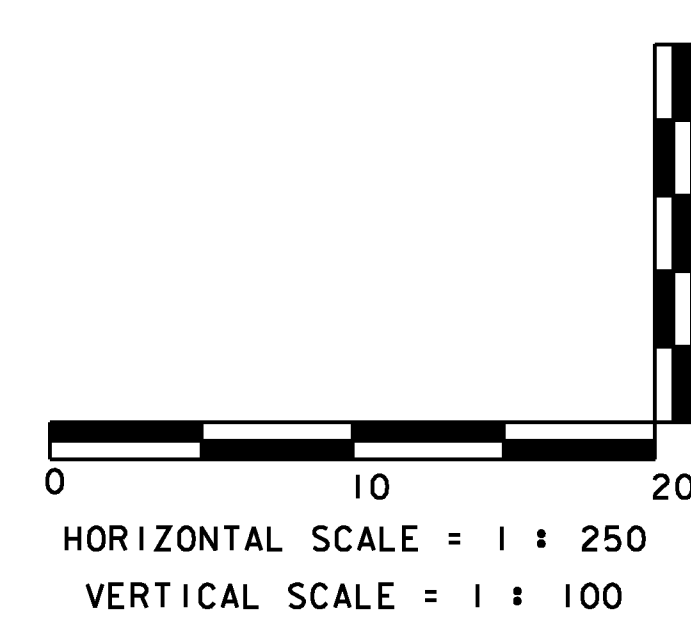

18+930 - 19+070	
PROJECT NAME:	DANVILLE
PROJECT NUMBER:	F EGC 028-3(32)
FILE NAME:	...\\PlotFiles\\us2pro.pr4.pptf
DESIGN SUPERVISOR:	GARY SANTY
DESIGNED BY:	STANTEC
PROFILE - US ROUTE 2	PRO-4
PLOT DATE:	1/18/2011
DRAWN BY:	STANTEC
CHECKED BY:	STANTEC
SHEET	77 OF 306