


US ROUTE 2 - 19+070 TO 19+260

DATUM
 VERTICAL: NAVD88
 HORIZONTAL: NAD83(92)



PROJECT NAME: DANVILLE
 PROJECT NUMBER: F EGC 028-3(32)
 FILE NAME: ...\\PlotFiles\us2pro.pr5.pptf
 DESIGN SUPERVISOR: GARY SANTY
 DESIGNED BY: STANTEC
 PROFILE - US ROUTE 2 PRO-5
 PLOT DATE: 1/18/2011
 DRAWN BY: STANTEC
 CHECKED BY: STANTEC
 SHEET 78 OF 306

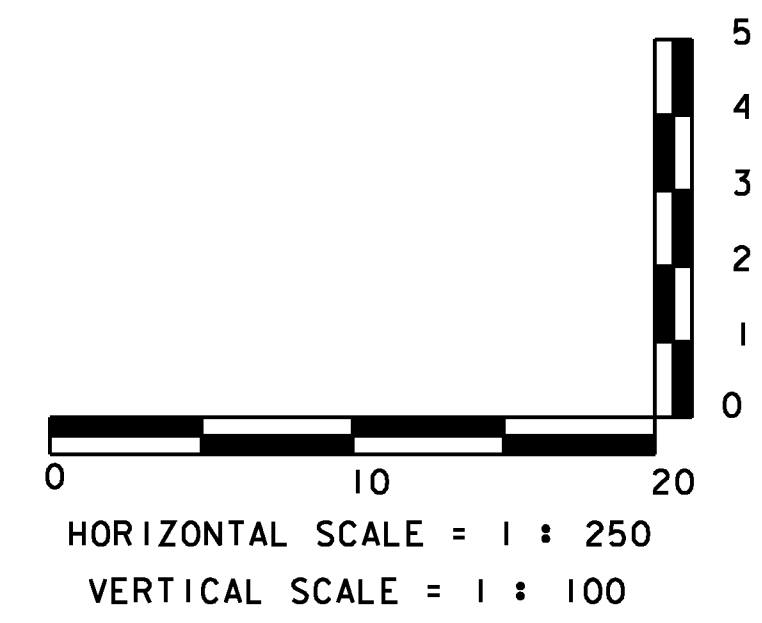

1/18/2011 10:40:33 PM v:\1953\active\1953\0033_0952\Highway\PlotFiles\us2pro.pr5.pptf