


US ROUTE 2 - 19+260 TO 19+450

DATUM	
VERTICAL	NAVD88
HORIZONTAL	NAD83(92)

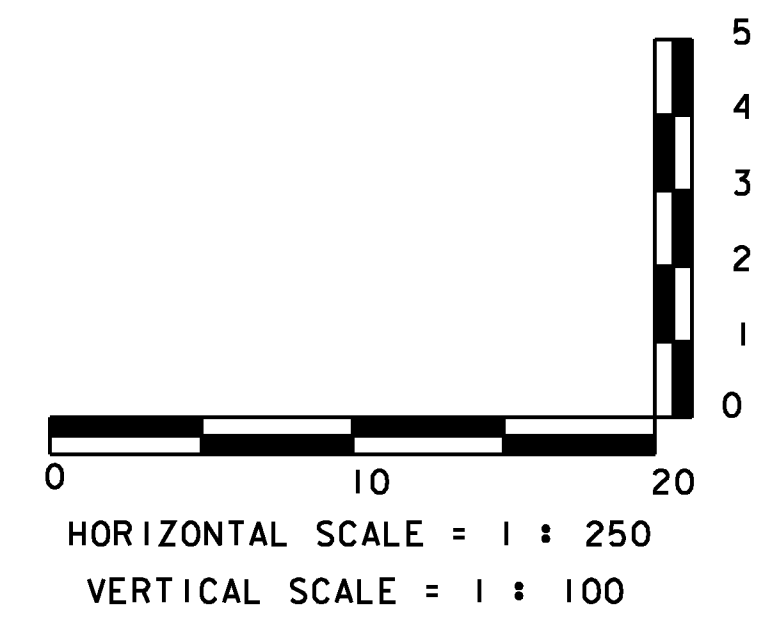

PROJECT NAME: DANVILLE	
PROJECT NUMBER: F EGC 028-3(32)	
FILE NAME: ...PlotFiles\us2pro.pr6.ptf	PLOT DATE: 1/18/2011
DESIGN SUPERVISOR: GARY SANTY	DRAWN BY: STANTEC
DESIGNED BY: STANTEC	CHECKED BY: STANTEC
PROFILE - US ROUTE 2 PRO-6	SHEET 79 OF 306

1/18/2011 10:50:04 PM v:\1953\active\1953\0033_0952\Highway\PlotFiles\us2pro.pr6.ptf

19 + 260 - 19 + 450