


**US ROUTE 2 - 19+450 TO 19+590**

<b>DATUM</b>	
VERTICAL	NAVD88
HORIZONTAL	NAD83(92)

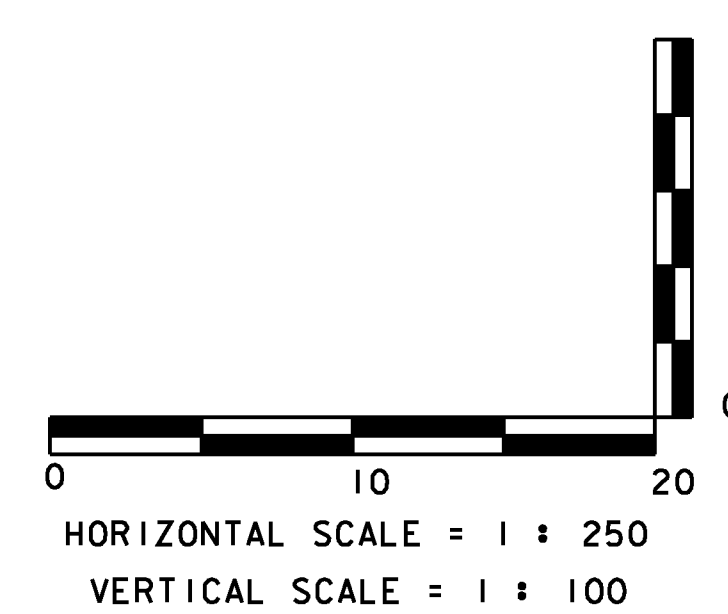

19+450 - 19+590	
PROJECT NAME:	DANVILLE
PROJECT NUMBER:	F EGC 028-3(32)
FILE NAME:	...\\PlotFiles\us2pro_pr7.pxf
DESIGN SUPERVISOR:	GARY SANTY
DESIGNED BY:	STANTEC
PROFILE - US ROUTE 2	PRO-7
PLOT DATE:	1/18/2011
DRAWN BY:	STANTEC
CHECKED BY:	STANTEC
SHEET	80 OF 306