


US ROUTE 2 - 19+590 TO 19+760

DATUM	
VERTICAL	NAVD88
HORIZONTAL	NAD83(92)

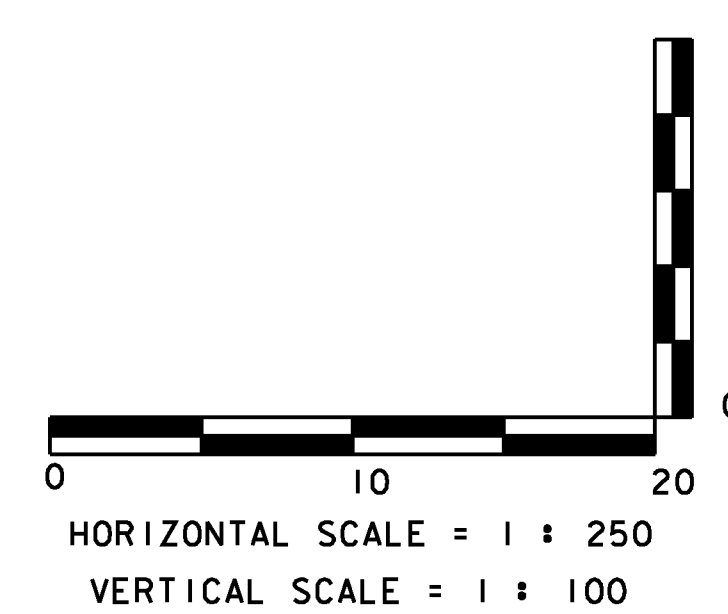

19+590 - 19+760	
PROJECT NAME:	DANVILLE
PROJECT NUMBER:	F EGC 028-3(32)
FILE NAME:	...\\PlotFiles\us2pro-pr8.prf
DESIGN SUPERVISOR:	GARY SANTY
DESIGNED BY:	STANTEC
PROFILE -	US ROUTE 2 PRO-8
PLOT DATE:	1/18/2011
DRAWN BY:	STANTEC
CHECKED BY:	STANTEC
SHEET	81 OF 306

1/18/2011 11:51:06 PM v:\1953\active\1953\0033_0952\Highway\PlotFiles\us2pro-pr8.prf