


**US ROUTE 2 - 19+760 TO 19+940**

<b>DATUM</b>	
VERTICAL	NAVD88
HORIZONTAL	NAD83(92)

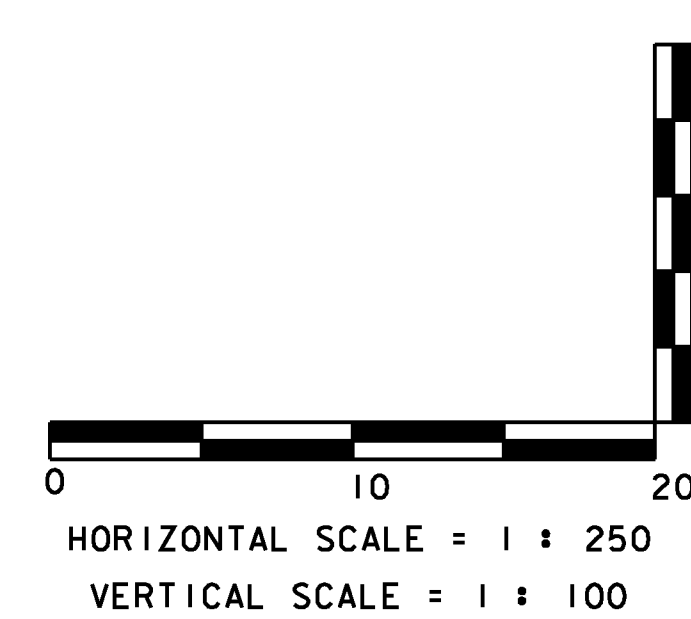

19+760 - 19+940	
PROJECT NAME:	DANVILLE
PROJECT NUMBER:	F EGC 028-3(32)
FILE NAME:	...\\PlotFiles\us2pro_pr9.pxf
DESIGN SUPERVISOR:	GARY SANTY
DESIGNED BY:	STANTEC
PROFILE - US ROUTE 2	PRO-9
PLOT DATE:	1/18/2011
DRAWN BY:	STANTEC
CHECKED BY:	STANTEC
SHEET	82 OF 306

1/18/2011 10:07 PM v:\1953\active\1953\0033\_0952\Highway\PlotFiles\us2pro\_pr9.pxf