


**WALDEN HILL ROAD - 1+000 TO 1+080**

<b>DATUM</b>	
VERTICAL	NAVD88
HORIZONTAL	NAD83(92)

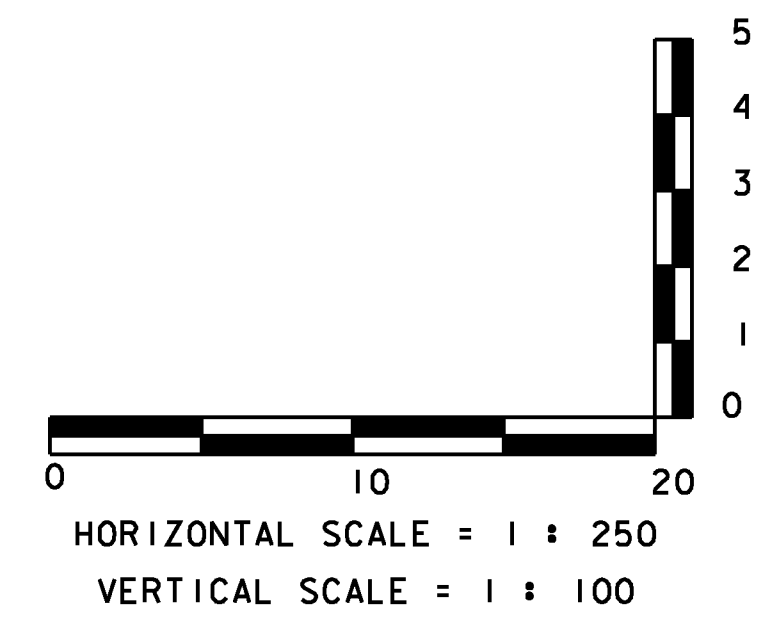

1+000 - 1+080	
PROJECT NAME:	DANVILLE
PROJECT NUMBER:	F EGC 028-3(32)
FILE NAME:	...\\PlotFiles\whrdpro_pr10.ptf
DESIGN SUPERVISOR:	GARY SANTY
DESIGNED BY:	STANTEC
PROFILE - WALDEN HILL ROAD	PRO-10
PLOT DATE:	1/18/2011
DRAWN BY:	STANTEC
CHECKED BY:	STANTEC
SHEET	83 OF 306

1/18/2011 11:51:08 PM v:\1953\active\1953\0033\_0952\Highway\PlotFiles\whrdpro\_pr10.ptf