


PARK STREET - 2+000 TO 2+130

DATUM	
VERTICAL	NAVD88
HORIZONTAL	NAD83(92)

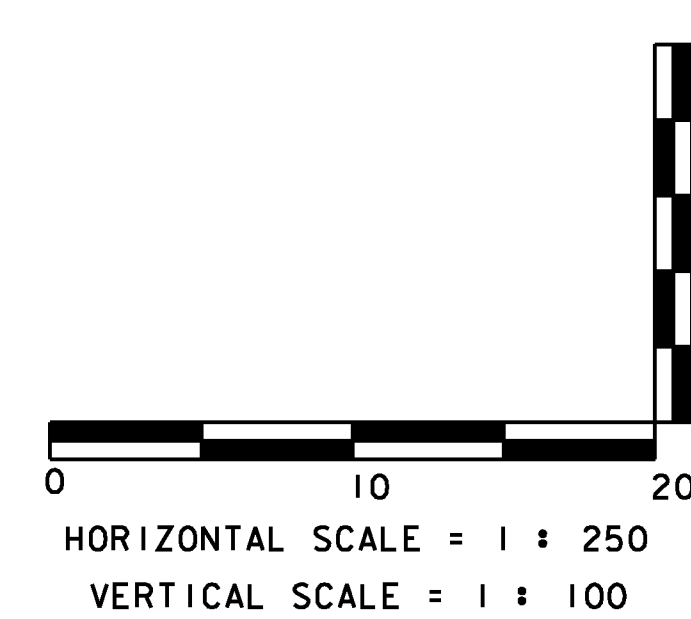

PROJECT NAME:	DANVILLE	2+000 - 2+130
PROJECT NUMBER:	F EGC 028-3(32)	
FILE NAME:	...\\PlotFiles\pkstpro_prll.ptf	PLOT DATE: 1/18/2011
DESIGN SUPERVISOR:	GARY SANTY	DRAWN BY: STANTEC
DESIGNED BY:	STANTEC	CHECKED BY: STANTEC
PROFILE - PARK STREET PRO-11		SHEET 84 OF 306

1/18/2011 11:03 PM v:\1953\active\9530033_0952\Highway\PlotFiles\pkstpro_prll.ptf