


**PARK STREET - 2+130 TO 2+260**

<b>DATUM</b>	
VERTICAL	NAVD88
HORIZONTAL	NAD83(92)

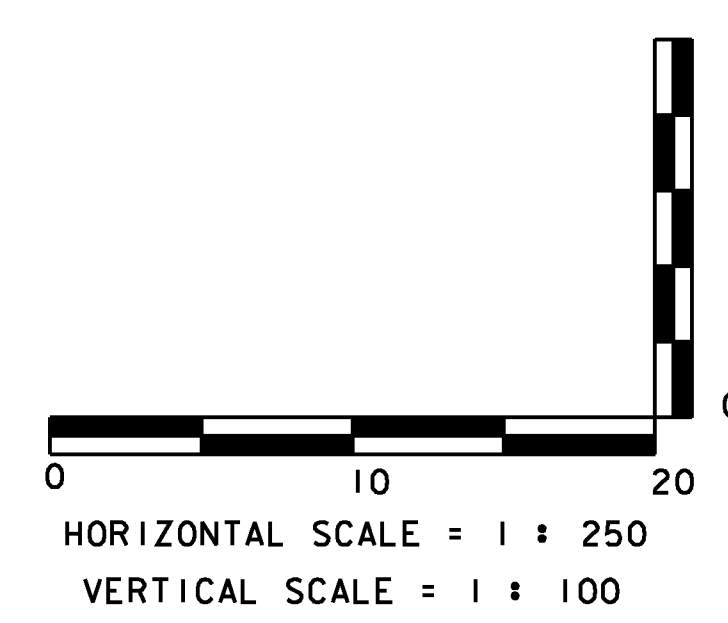

PROJECT NAME: DANVILLE	
PROJECT NUMBER: F EGC 028-3(32)	
FILE NAME: ...\\PlotFiles\pkstpro_pr12.ptf	PLOT DATE: 1/18/2011
DESIGN SUPERVISOR: GARY SANTY	DRAWN BY: STANTEC
DESIGNED BY: STANTEC	CHECKED BY: STANTEC
<b>PROFILE - PARK STREET PRO-12</b>	SHEET 85 OF 306

1/18/2011 10:51:00 PM v:\1953\active\1953\0033\_0052\Highway\PlotFiles\pkstpro\_pr12.ptf

2+130 - 2+260