


PEACHAM RD - 4+000 TO 4+170

DATUM	
VERTICAL	NAVD88
HORIZONTAL	NAD83(92)



PROJECT NAME:	DANVILLE
PROJECT NUMBER:	F EGC 028-3(32)
FILE NAME:	...\\PlotFiles\pchr_d.pr13.ptf
DESIGN SUPERVISOR:	GARY SANTY
DESIGNED BY:	STANTEC
PROFILE - PEACHAM ROAD	PRO-13
PLOT DATE:	1/18/2011
DRAWN BY:	STANTEC
CHECKED BY:	STANTEC
SHEET	86 OF 306

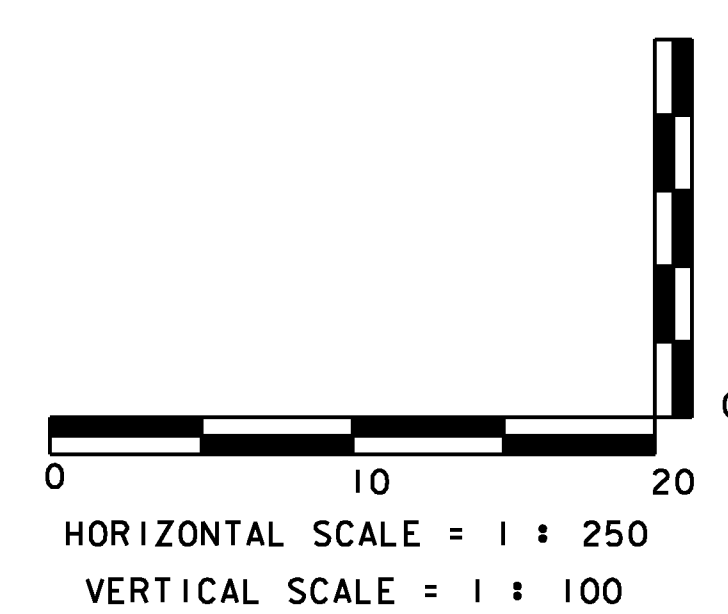

1/18/2011 10:51:11 PM v:\1953\active\1953\0033_0092\Highway\PlotFiles\pchr_d.pr13.ptf