


SMITH STREET - 5+000 TO 5+120

|              |           |
|--------------|-----------|
| <b>DATUM</b> |           |
| VERTICAL     | NAVD88    |
| HORIZONTAL   | NAD83(92) |

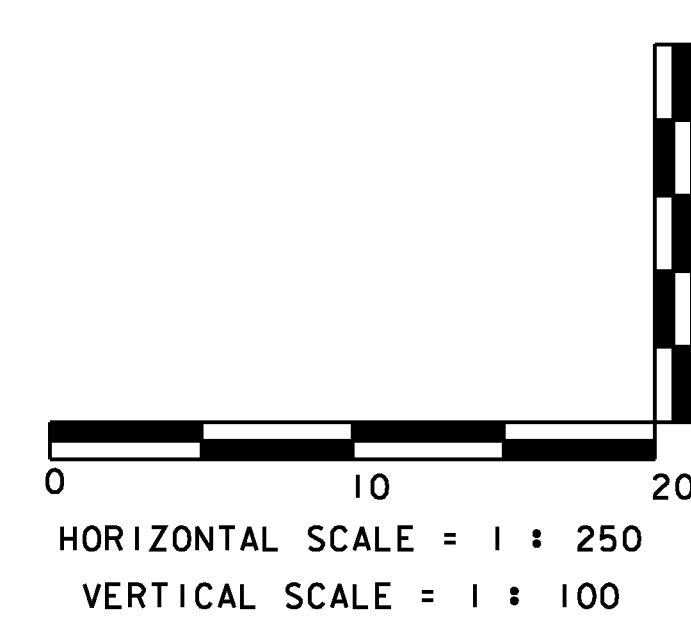

|  |                      |
|--|----------------------|
| PROJECT NAME: DANVILLE                 | 5+000 - 5+120        |
| PROJECT NUMBER: F EGC 028-3(32)        |                      |
| FILE NAME: ...\plotfiles\smst_pr14.ptf | PLOT DATE: 1/18/2011 |
| DESIGN SUPERVISOR: GARY SANTY          | DRAWN BY: STANTEC    |
| DESIGNED BY: STANTEC                   | CHECKED BY: STANTEC  |
| PROFILE - SMITH STREET PRO-14          | SHEET 87 OF 306      |

1/18/2011 10:51:42 PM v:\1953\active\9530033\_0952\highway\plotfiles\smst\_pr14.ptf