




**CONST PLAN 4  
CB244-CB243  
US RT 2 18+989 LT - 18+989 RT**

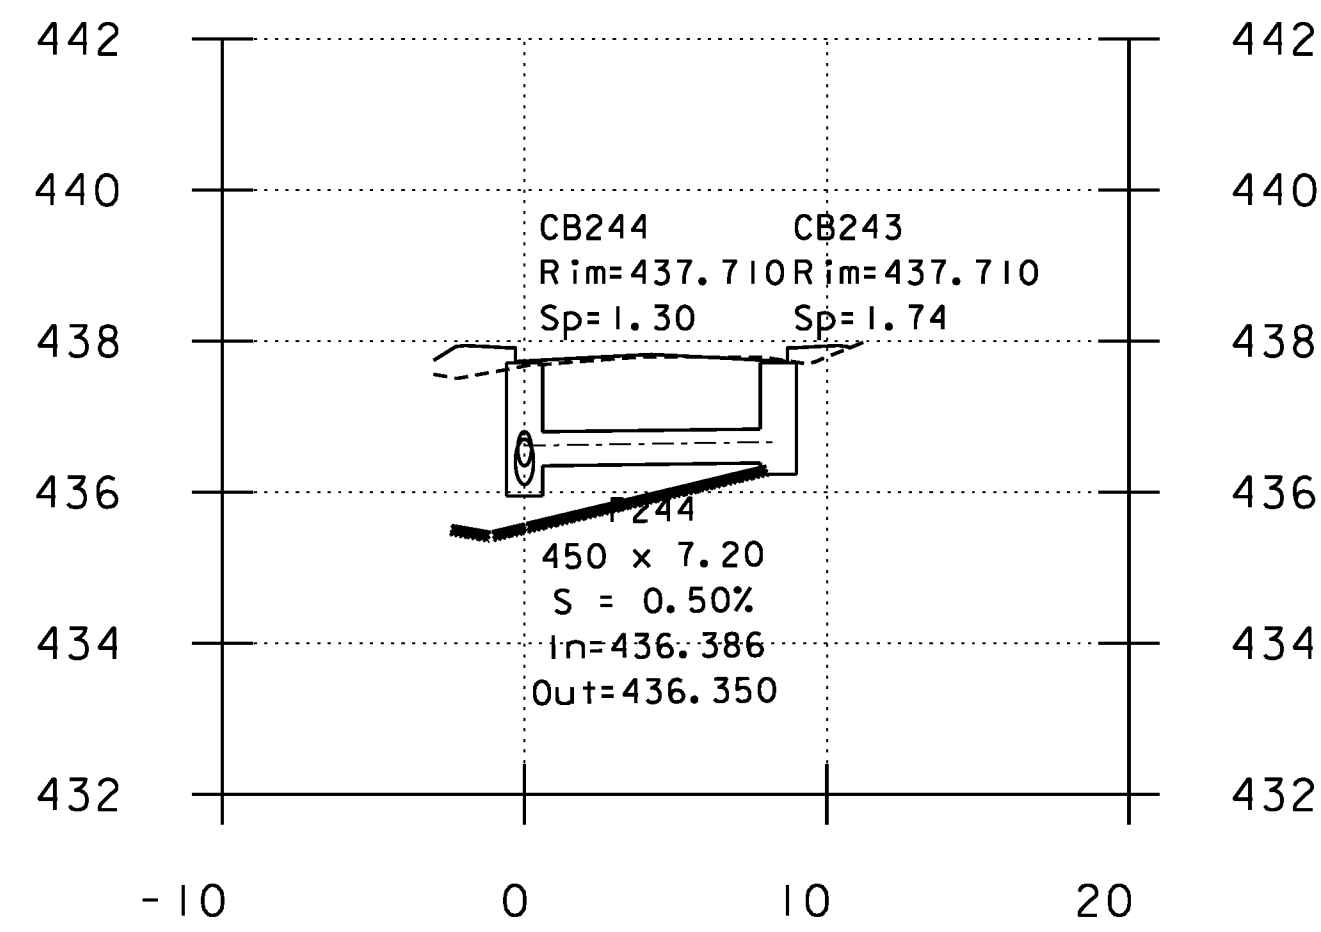


**CONST PLAN 4  
CB242-CB240  
US RT 2 19+027 LT - 19+037 RT**

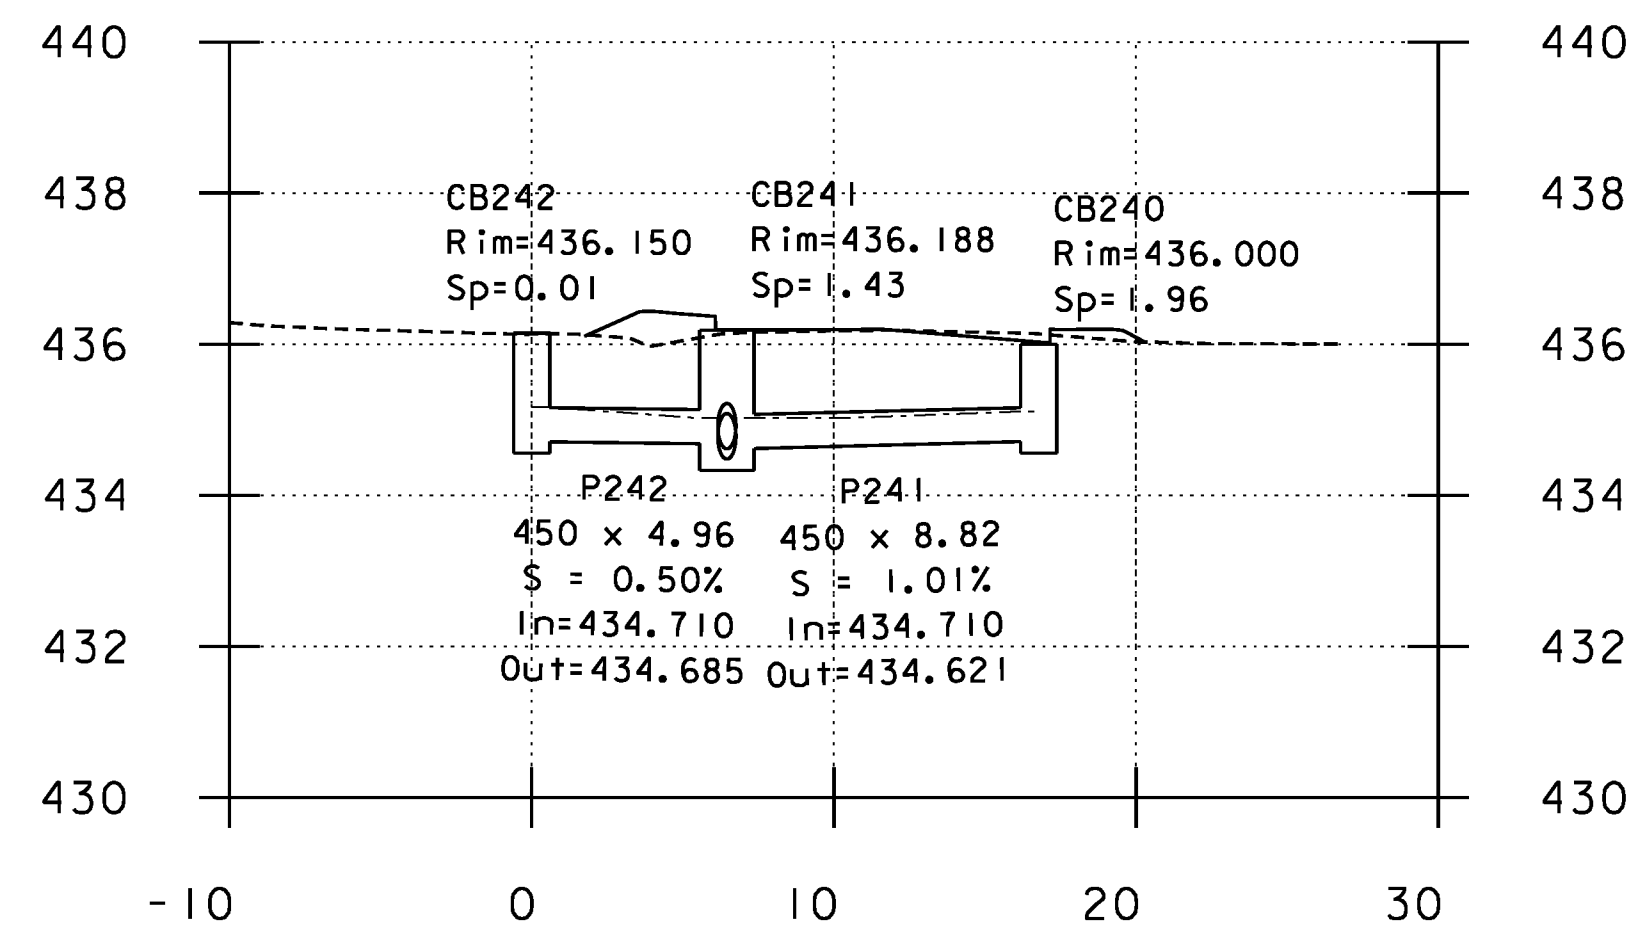

**CB240A - CB240B**

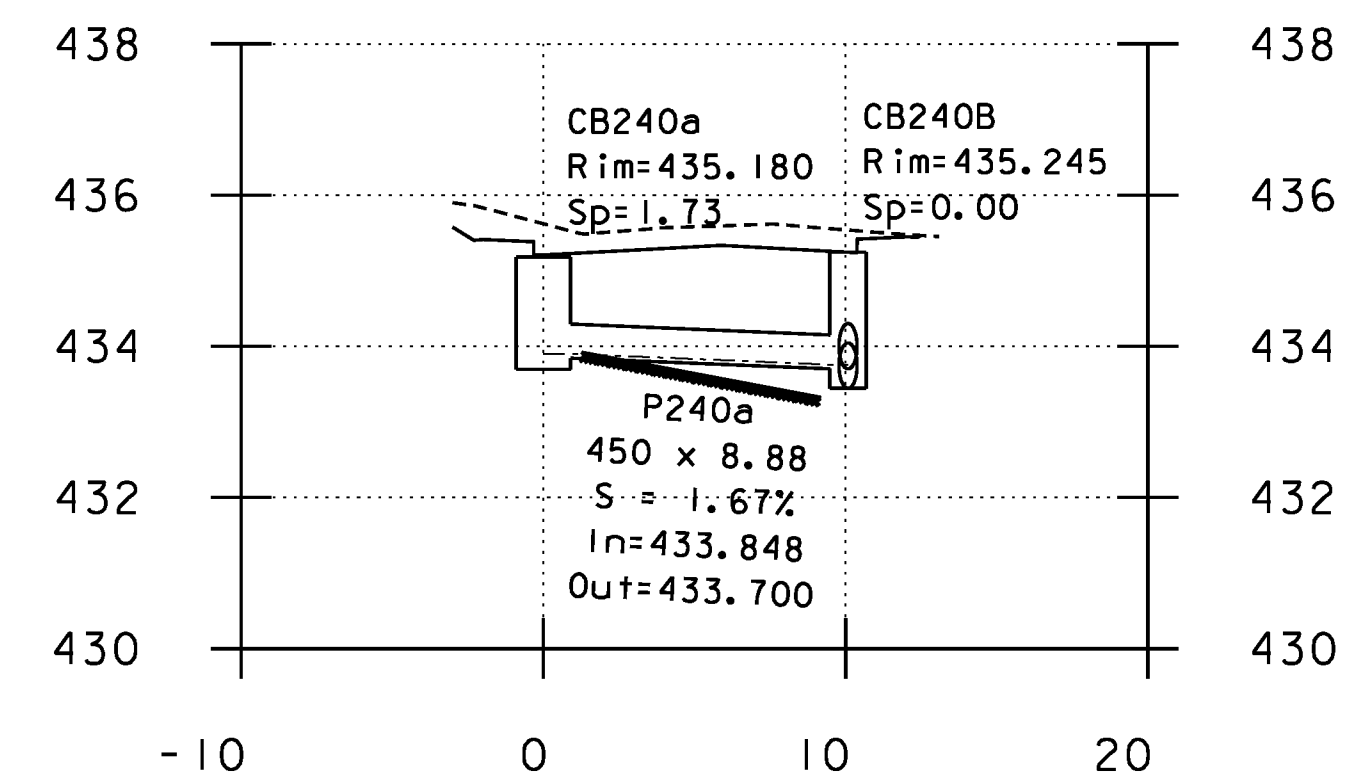


**CB245 - CB240B**

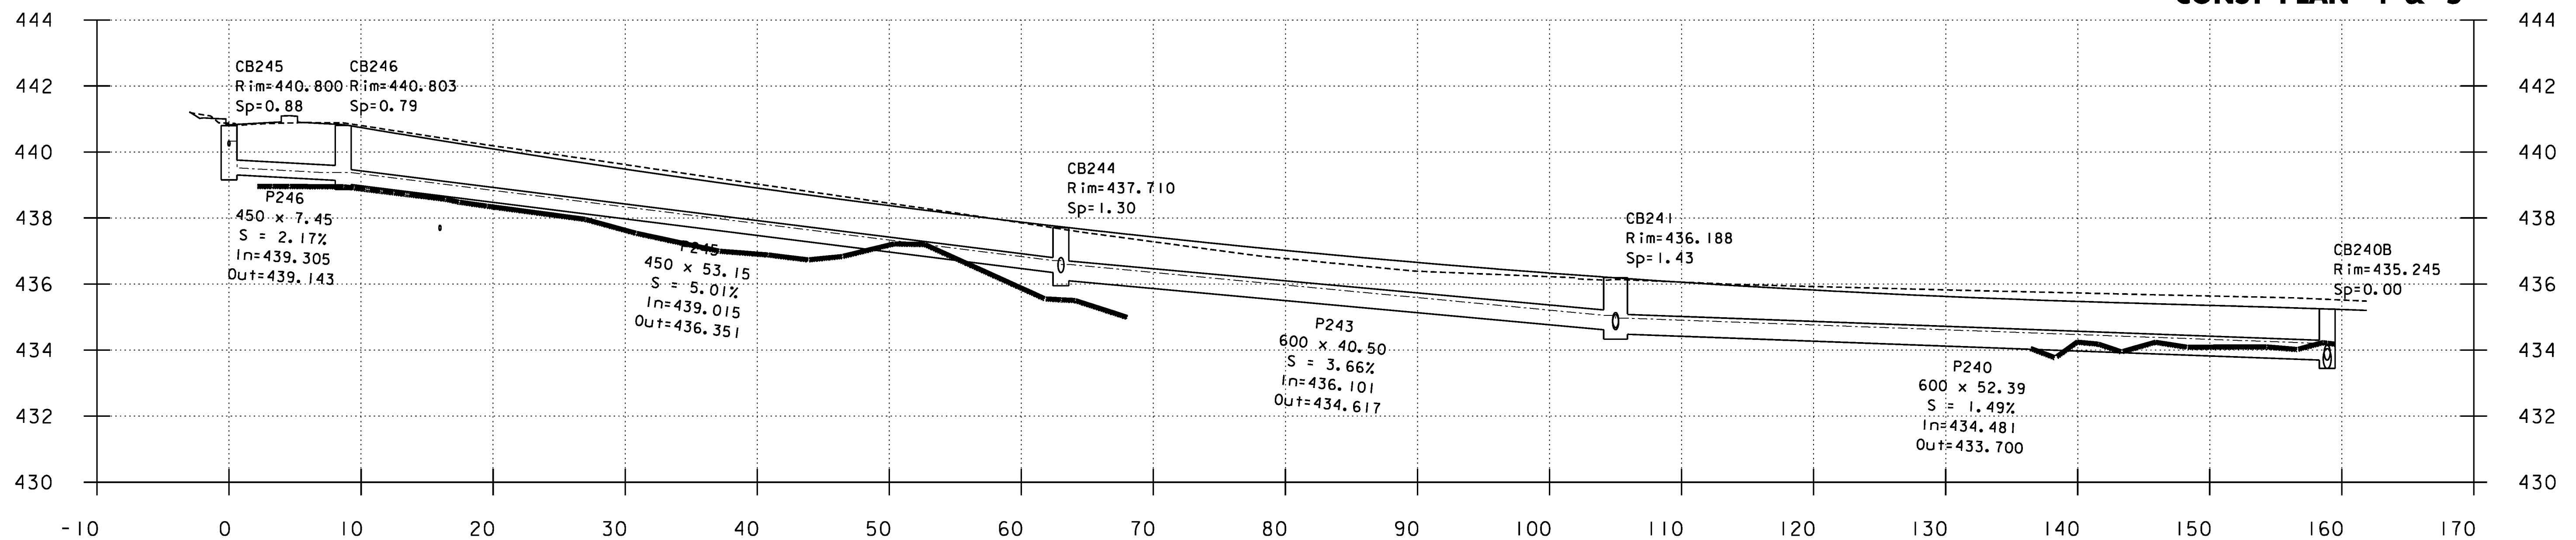

**CONST PLAN 4 & 5**

**REPLACEMENT SHEETS  
ISSUED 10/5/11**

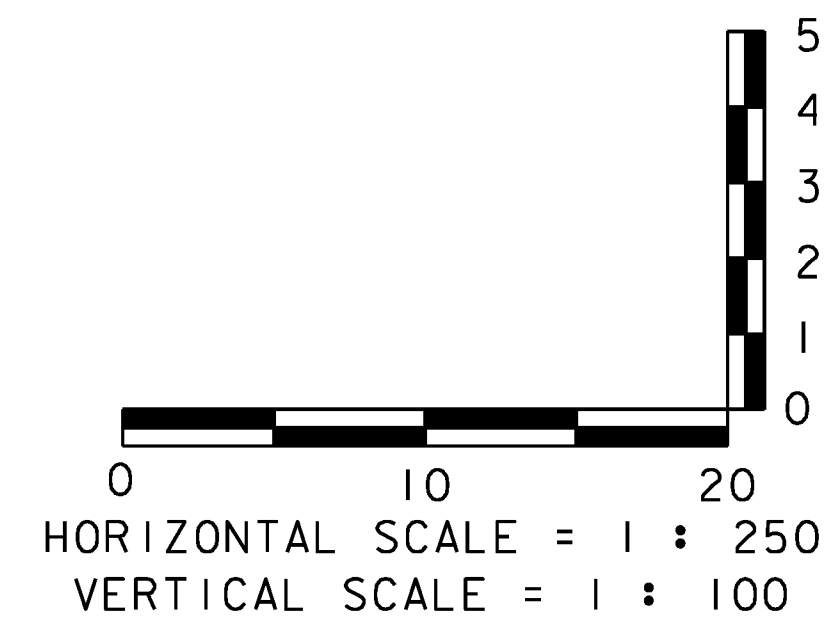

**NOTES:**

- FOR PLAN VIEW LOCATION OF DRAINAGE PIPE AND STRUCTURES, SEE CONSTRUCTION PLANS.



PROJECT NAME: DANVILLE  
PROJECT NUMBER: F EGC 028-3(32)

FILE NAME: ...\\PlotFiles\drn-pro-1-8.ptf PLOT DATE: 10/4/2011  
DESIGN SUPERVISOR: GARY SANTY DRAWN BY: STANTEC  
DESIGNED BY: STANTEC CHECKED BY: STANTEC  
**DRAINAGE PROFILE SHEET DPRO-3** SHEET 94 OF 306