



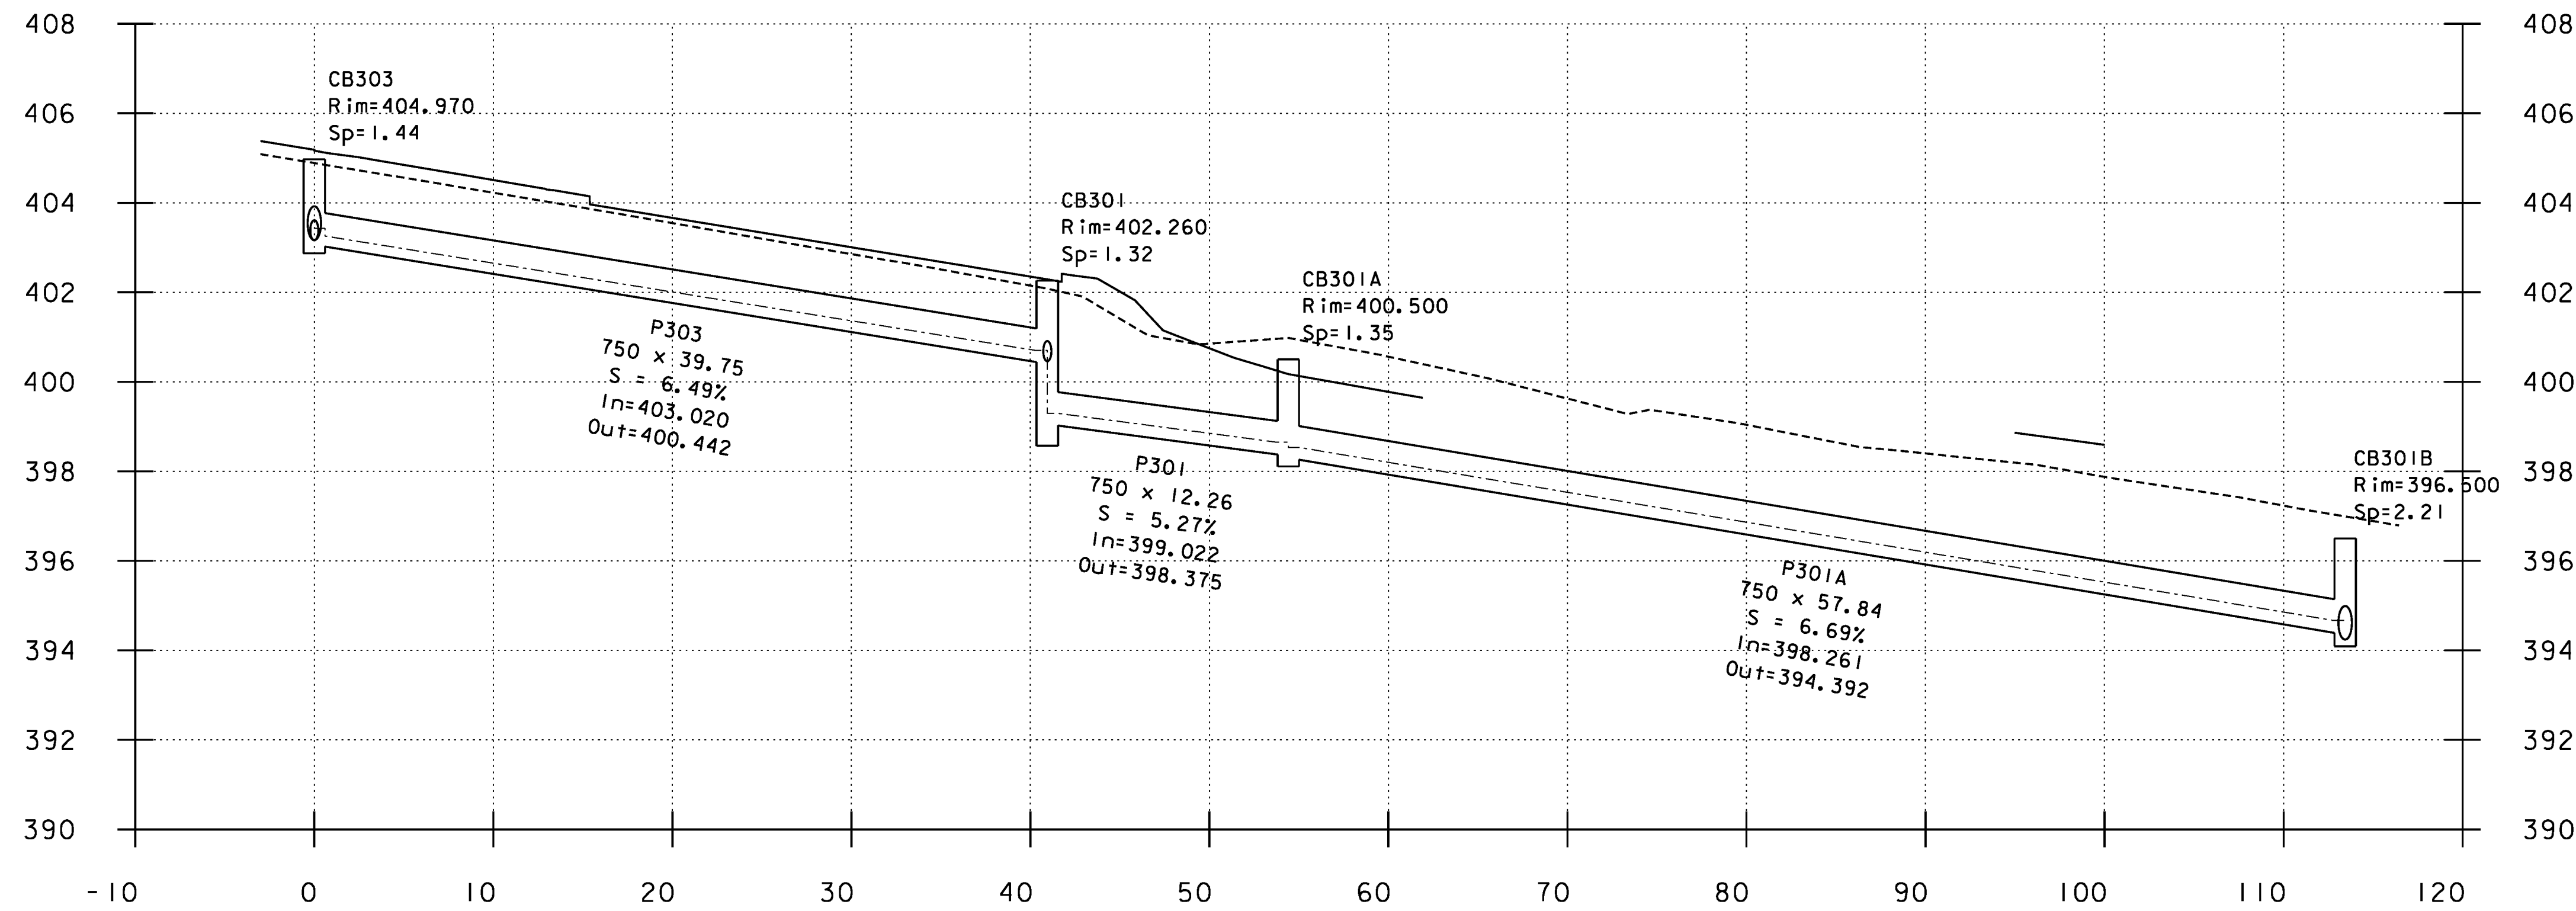


CB303 - CB301B

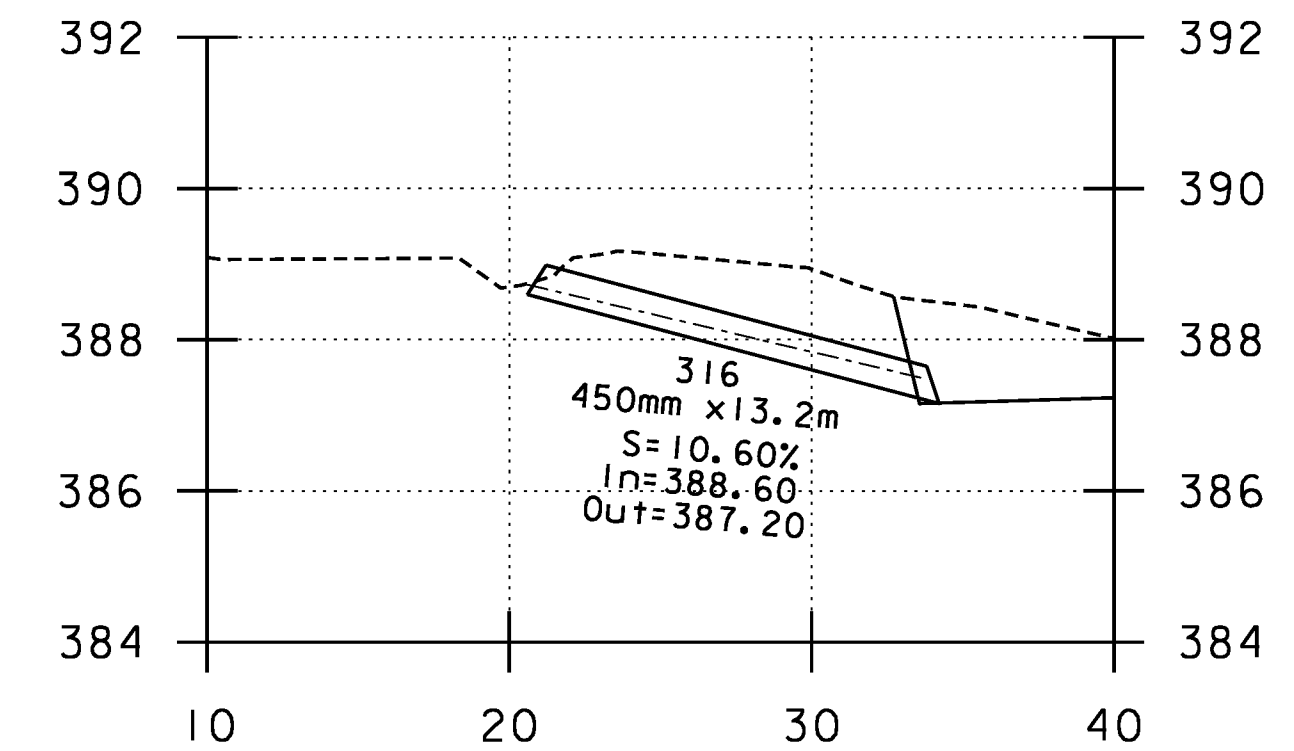


**CONST PLAN 10
P316
US RT 2 19+844.1 RT - 19+858 RT**




CB301B - P315

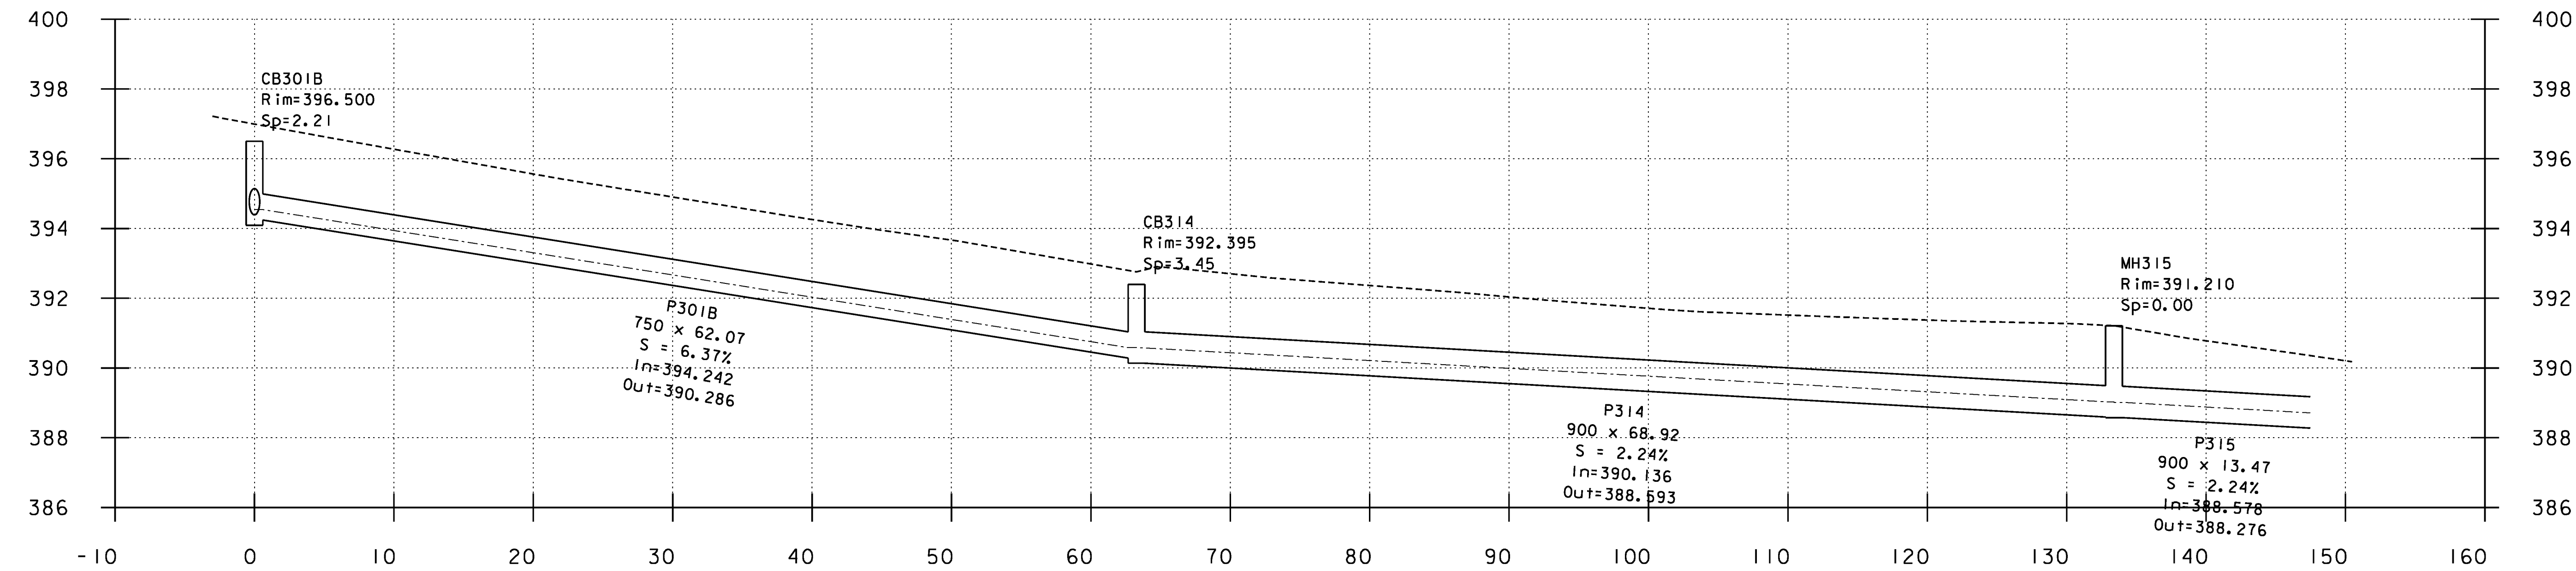


**CONST PLAN 10
MH311
US RT 2 19+835 RT - 19+865.9 RT**

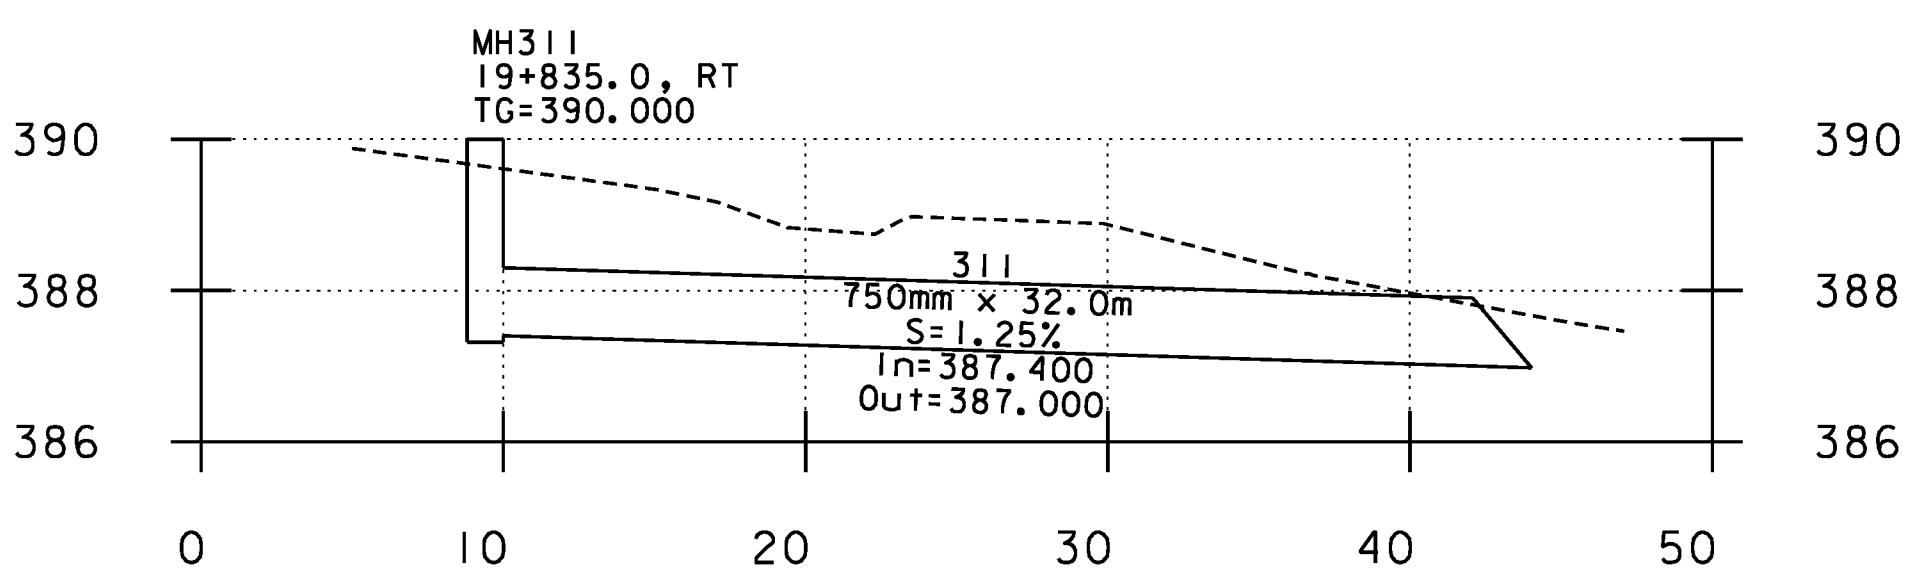

**CONST PLAN 10
P313
US RT 2 19+846 RT - 19+866 RT**

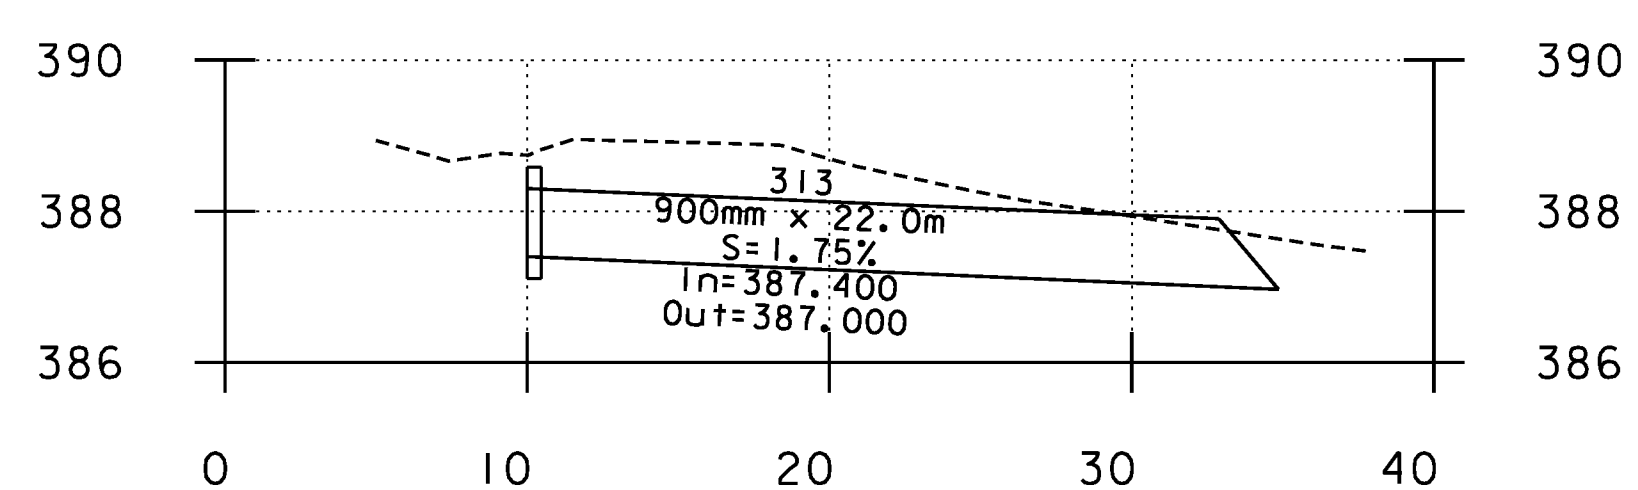

**REPLACEMENT SHEETS
ISSUED 10/5/11**

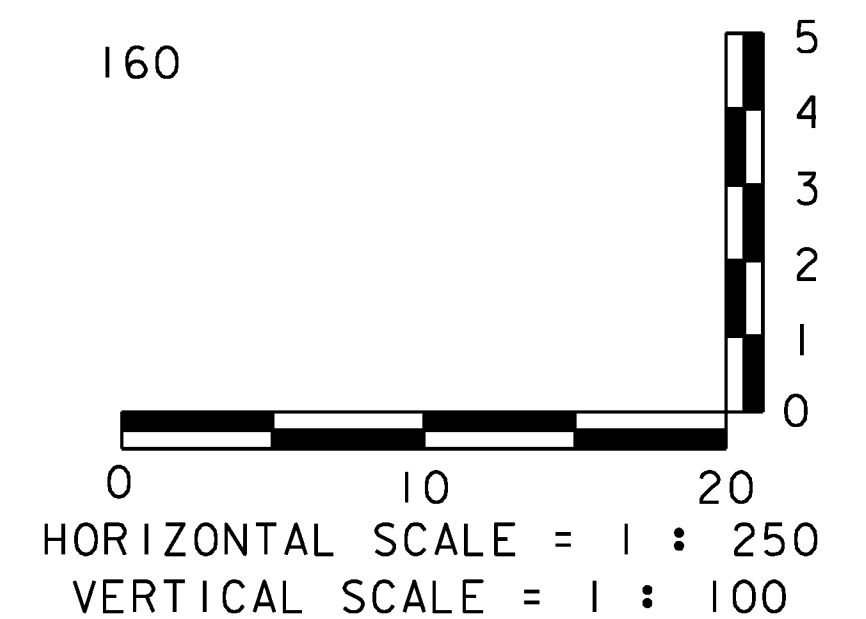

PROJECT NAME: DANVILLE
 PROJECT NUMBER: F EGC 028-3(32)
 FILE NAME: ...PlotFiles\drn-pro-1-8.ptf
 DESIGN SUPERVISOR: GARY SANTY
 DESIGNED BY: STANTEC
 PLOT DATE: 10/4/2011
 DRAWN BY: STANTEC
 CHECKED BY: STANTEC
 SHEET 99 OF 306



10/4/2011 14:23:32 PM V:\953\ocFive\9530033_1095\Revised Plans\PlotFiles\drn-pro-1-8.ptf