

SOIL CLASSIFICATION A
VERSHIRE-LOMBARD COMPLEX
8-15% SLOPES, ROCKY
"K" FACTOR = 0.37
CLASSIFIED HIGHLY ERODIBLE

SOIL CLASSIFICATION A
VERSHIRE-LOMBARD COMPLEX
8-15% SLOPES, ROCKY
"K" FACTOR = 0.37
CLASSIFIED HIGHLY ERODIBLE

MATCH TO EPSC PRE-CONSTRUCTION SITE PLAN 3


MATCH TO EPSC PRE-CONSTRUCTION SITE PLAN 5

653.55 - PROJECT DEMARCATION FENCE
 STA. 18+930.0 TO 18+958.2, RT
 STA. 18+930.0 TO 18+951.8, LT
 STA. 18+960.8 TO 18+990.8, LT
 STA. 18+998.5 TO 19+045.6, LT

653.41 - INLET PROTECTION DEVICE, TYPE II
 STA. 18+937.7, LT (FILTER FIBER)
 STA. 18+914.5, LT (FILTER FIBER)

NOTE:
 1. SEE EPSC PRE-CONSTRUCTION SITE PLAN EPR-1 FOR GENERAL NOTES AND LEGEND

DATUM
 VERTICAL NAVD88
 HORIZONTAL

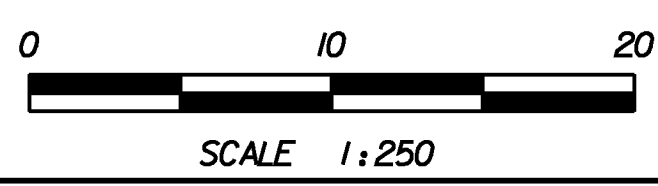

PROJECT NAME: DANVILLE
 PROJECT NUMBER: F EGC 028-3(32)
 FILE NAME: ...\\plotfiles\Epsc EPR-04.ptf PLOT DATE: 1/18/2011
 DESIGN SUPERVISOR: GARY SANTY DRAWN BY: STANTEC
 DESIGNED BY: STANTEC CHECKED BY: STANTEC
EPSC PRE-CONSTRUCTION PLAN EPR-4 SHEET 110 OF 306

STA 18+930 TO 19+070

1/18/2011 11:54:52 PM v:\1953\active\9530033_1092\highway\plotfiles\Epsc EPR-04.ptf