

MATCH TO EPSC CONSTRUCTION SITE PLAN 5

MATCH TO EPSC CONSTRUCTION SITE PLAN 5

MATCH TO EPSC CONSTRUCTION SITE PLAN 5

649.51 - GEOTEXTILE FOR SILT FENCE
 STA. 2+223.5 TO 2+227.2, LT
 STA. 2+226.7 TO 2+233.8, LT
 STA. 5+055.2 TO 5+058.7, RT
 STA. 5+087.7 TO 5+105.0, LT
 STA. 5+101.2 TO 5+106.1, LT

653.35 - VEHICLE TRACKING PAD
 STA. 2+242.1, LT
 STA. 4+127.3, RT


AREA NUMBER	651.17 - SEED, WINTER RYE 651.25 - HAY MULCH	651.17 - SEED, WINTER RYE 653.20 - TEMPORARY EROSION MATTING
	AREAS (SM)	
43	20.4	
44	9.8	
45	27.8	
46	13.9	
47	6.7	
48	40.6	
49	34.9	
50	4.1	
51	10.6	
52	2.8	
53	29.8	
54	11.6	
55		114.0
56	12.9	
57	7.8	
58	37.8	
59	6.9	

653.41 - INLET PROTECTION DEVICE, TYPE II
 STA. 2+105.0, LT (FILTER FIBER)
 STA. 2+105.0, RT (FILTER FIBER)
 STA. 2+134.9, LT (FILTER FIBER)
 STA. 2+134.9, RT (FILTER FIBER)
 STA. 2+157.0, LT (FILTER FIBER)
 STA. 2+190.1, LT (FILTER FIBER)
 STA. 2+205.5, LT (FILTER FIBER)
 STA. 2+207.8, RT (FILTER FIBER)
 STA. 2+224.9, LT (FILTER FIBER)
 STA. 5+070.1, LT (FILTER FIBER)
 STA. 5+070.1, RT (FILTER FIBER)
 STA. 5+089.0, LT (FILTER FIBER)

NOTE:
 1. SEE EPSC CONSTRUCTION SITE PLAN ECN-1 FOR GENERAL NOTES AND LEGEND

DATUM

VERTICAL	NAVD88
HORIZONTAL	NAD83(92)

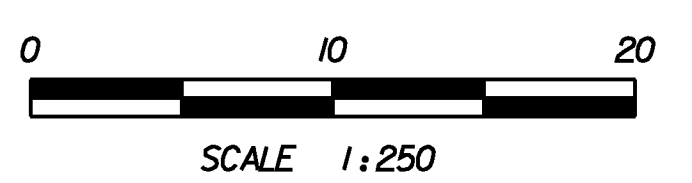

PROJECT NAME: DANVILLE
 PROJECT NUMBER: F EGC 028-3(32)
 FILE NAME: ...\\plotfiles\EPSC ECN-06.prf PLOT DATE: 1/18/2011
 DESIGN SUPERVISOR: GARY SANTY DRAWN BY: STANTEC
 DESIGNED BY: STANTEC CHECKED BY: STANTEC
EPSC CONSTRUCTION PLAN ECN-6 SHEET 123 OF 306

1/18/2011 10:52:48 PM v:\1953\active\1953\0033_1092\highway\plotfiles\EPSC ECN-06.prf