



MATCH TO EPSC CONSTRUCTION SITE PLAN 3

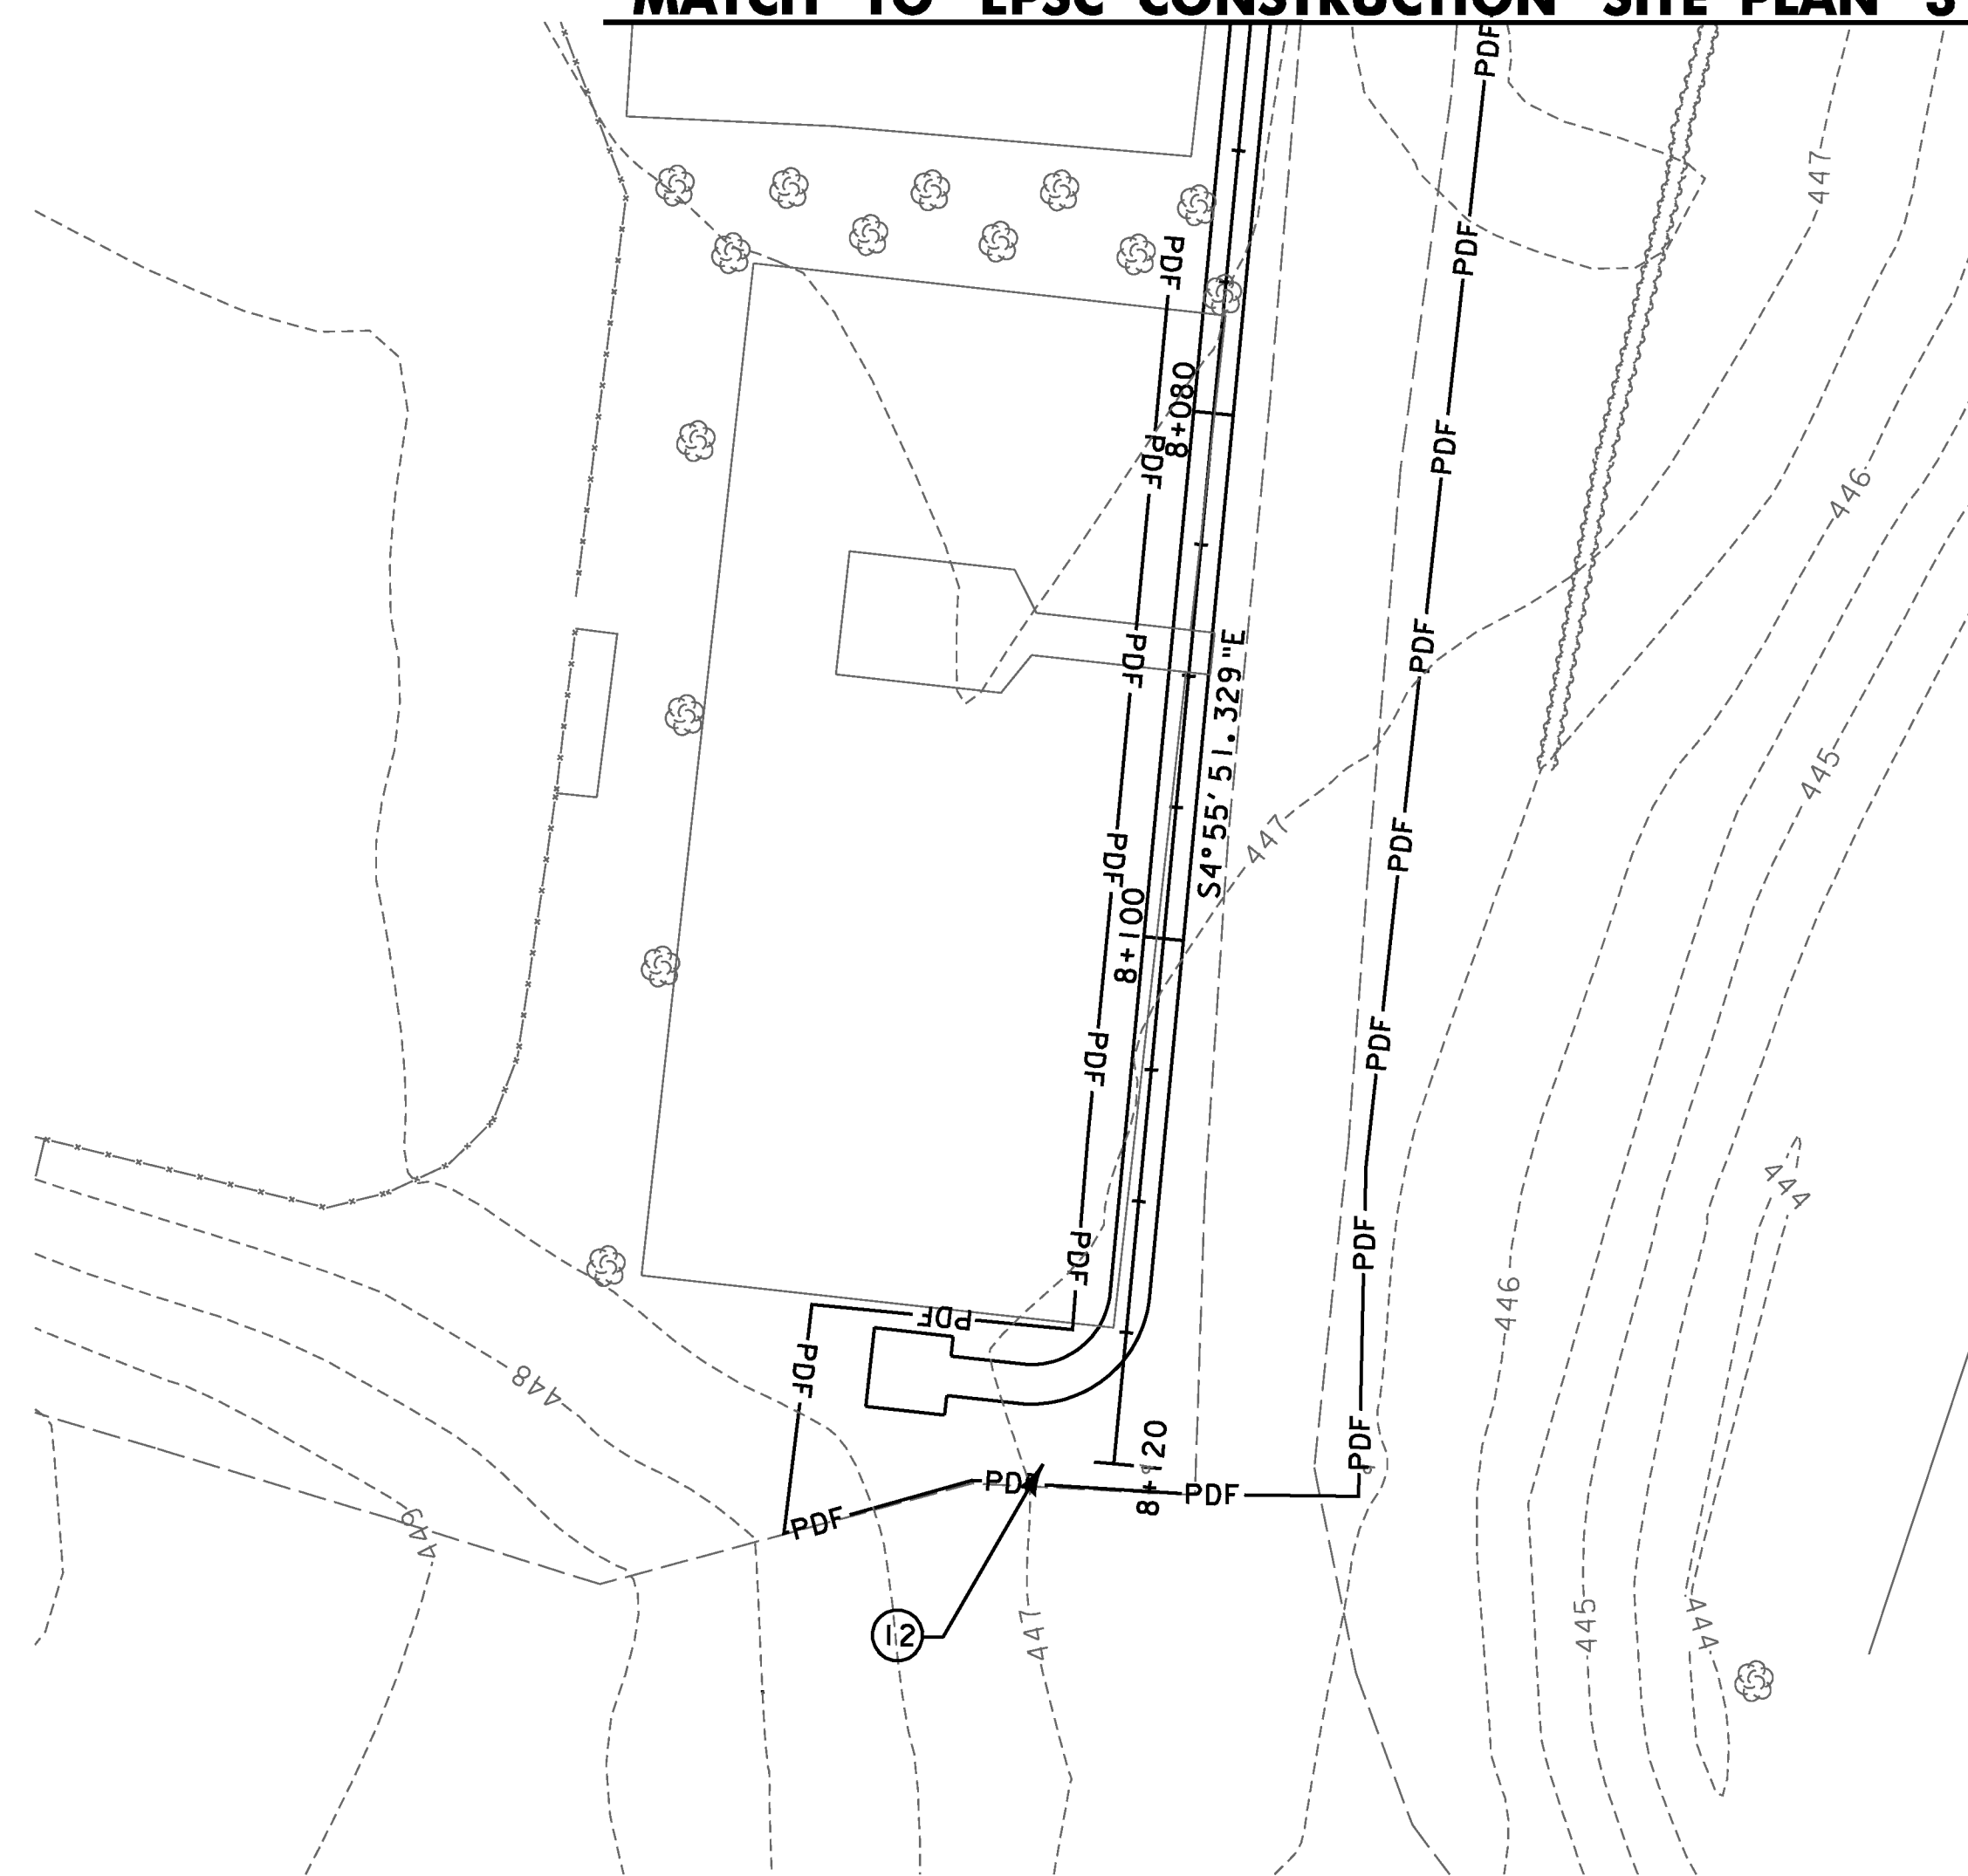

NOTE:

1. SEE EPSC CONSTRUCTION SITE PLAN ECN-1 FOR GENERAL NOTES AND LEGEND

DATUM	
VERTICAL	NAVD88
HORIZONTAL	NAD83(92)

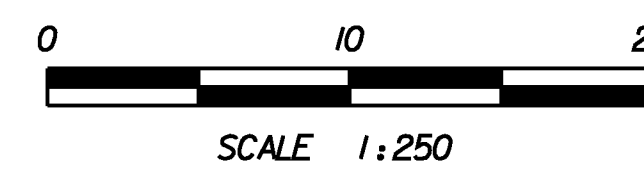

PROJECT NAME: DANVILLE
 PROJECT NUMBER: F EGC 028-3(32)

FILE NAME: ...\\plotfiles\EPSC ECN-11.ptf	PLOT DATE: 1/18/2011
DESIGN SUPERVISOR: GARY SANTY	DRAWN BY: STANTEC
DESIGNED BY: STANTEC	CHECKED BY: STANTEC
EPSC CONSTRUCTION PLAN ECN-11	SHEET 128 OF 306