

AREA NUMBER	651.15 - SEED	651.15 - SEED
	651.25 - HAY MULCH	653.20 - TEMPORARY EROSION MATTING
	AREAS (SM)	AREAS (SM)
29	34.9	
30	3.5	
31	329.9	
32	42.0	
33	25.5	
34	23.2	
35	40.5	
36	1137.3	
37	15.1	
38	3192.3	
39	44.2	
40	76.1	
41	197.3	

TEMPORARY CONSTRUCTION LIMITS


MATCH TO EPSC STABILIZATION SITE PLAN 6

MATCH TO EPSC STABILIZATION SITE PLAN 6

NOTE:
1. SEE EPSC STABILIZATION SITE PLAN EST-1 FOR GENERAL NOTES AND LEGEND

STA 19+070 TO 19+260

DATUM
VERTICAL NAVD88
HORIZONTAL NAD83(92)

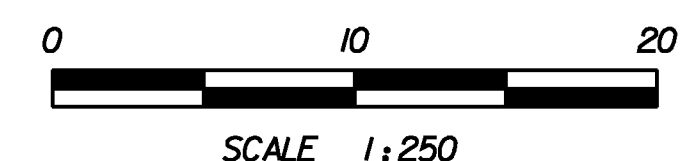

PROJECT NAME: DANVILLE
PROJECT NUMBER: F EGC 028-3(32)
FILE NAME: ...\\plotfiles\EPSC EST-05.prf PLOT DATE: 1/18/2011
DESIGN SUPERVISOR: GARY SANTY DRAWN BY: STANTEC
DESIGNED BY: STANTEC CHECKED BY: STANTEC
EPSC STABILIZATION PLAN EST-5 SHEET 133 OF 306

1/18/2011 10:52:38 PM v:\1953\active\1953\0033_1092\highway\plotfiles\EPSC EST-05.prf