


MATCH TO EPSC STABILIZATION SITE PLAN 8

MATCH TO EPSC STABILIZATION SITE PLAN 10

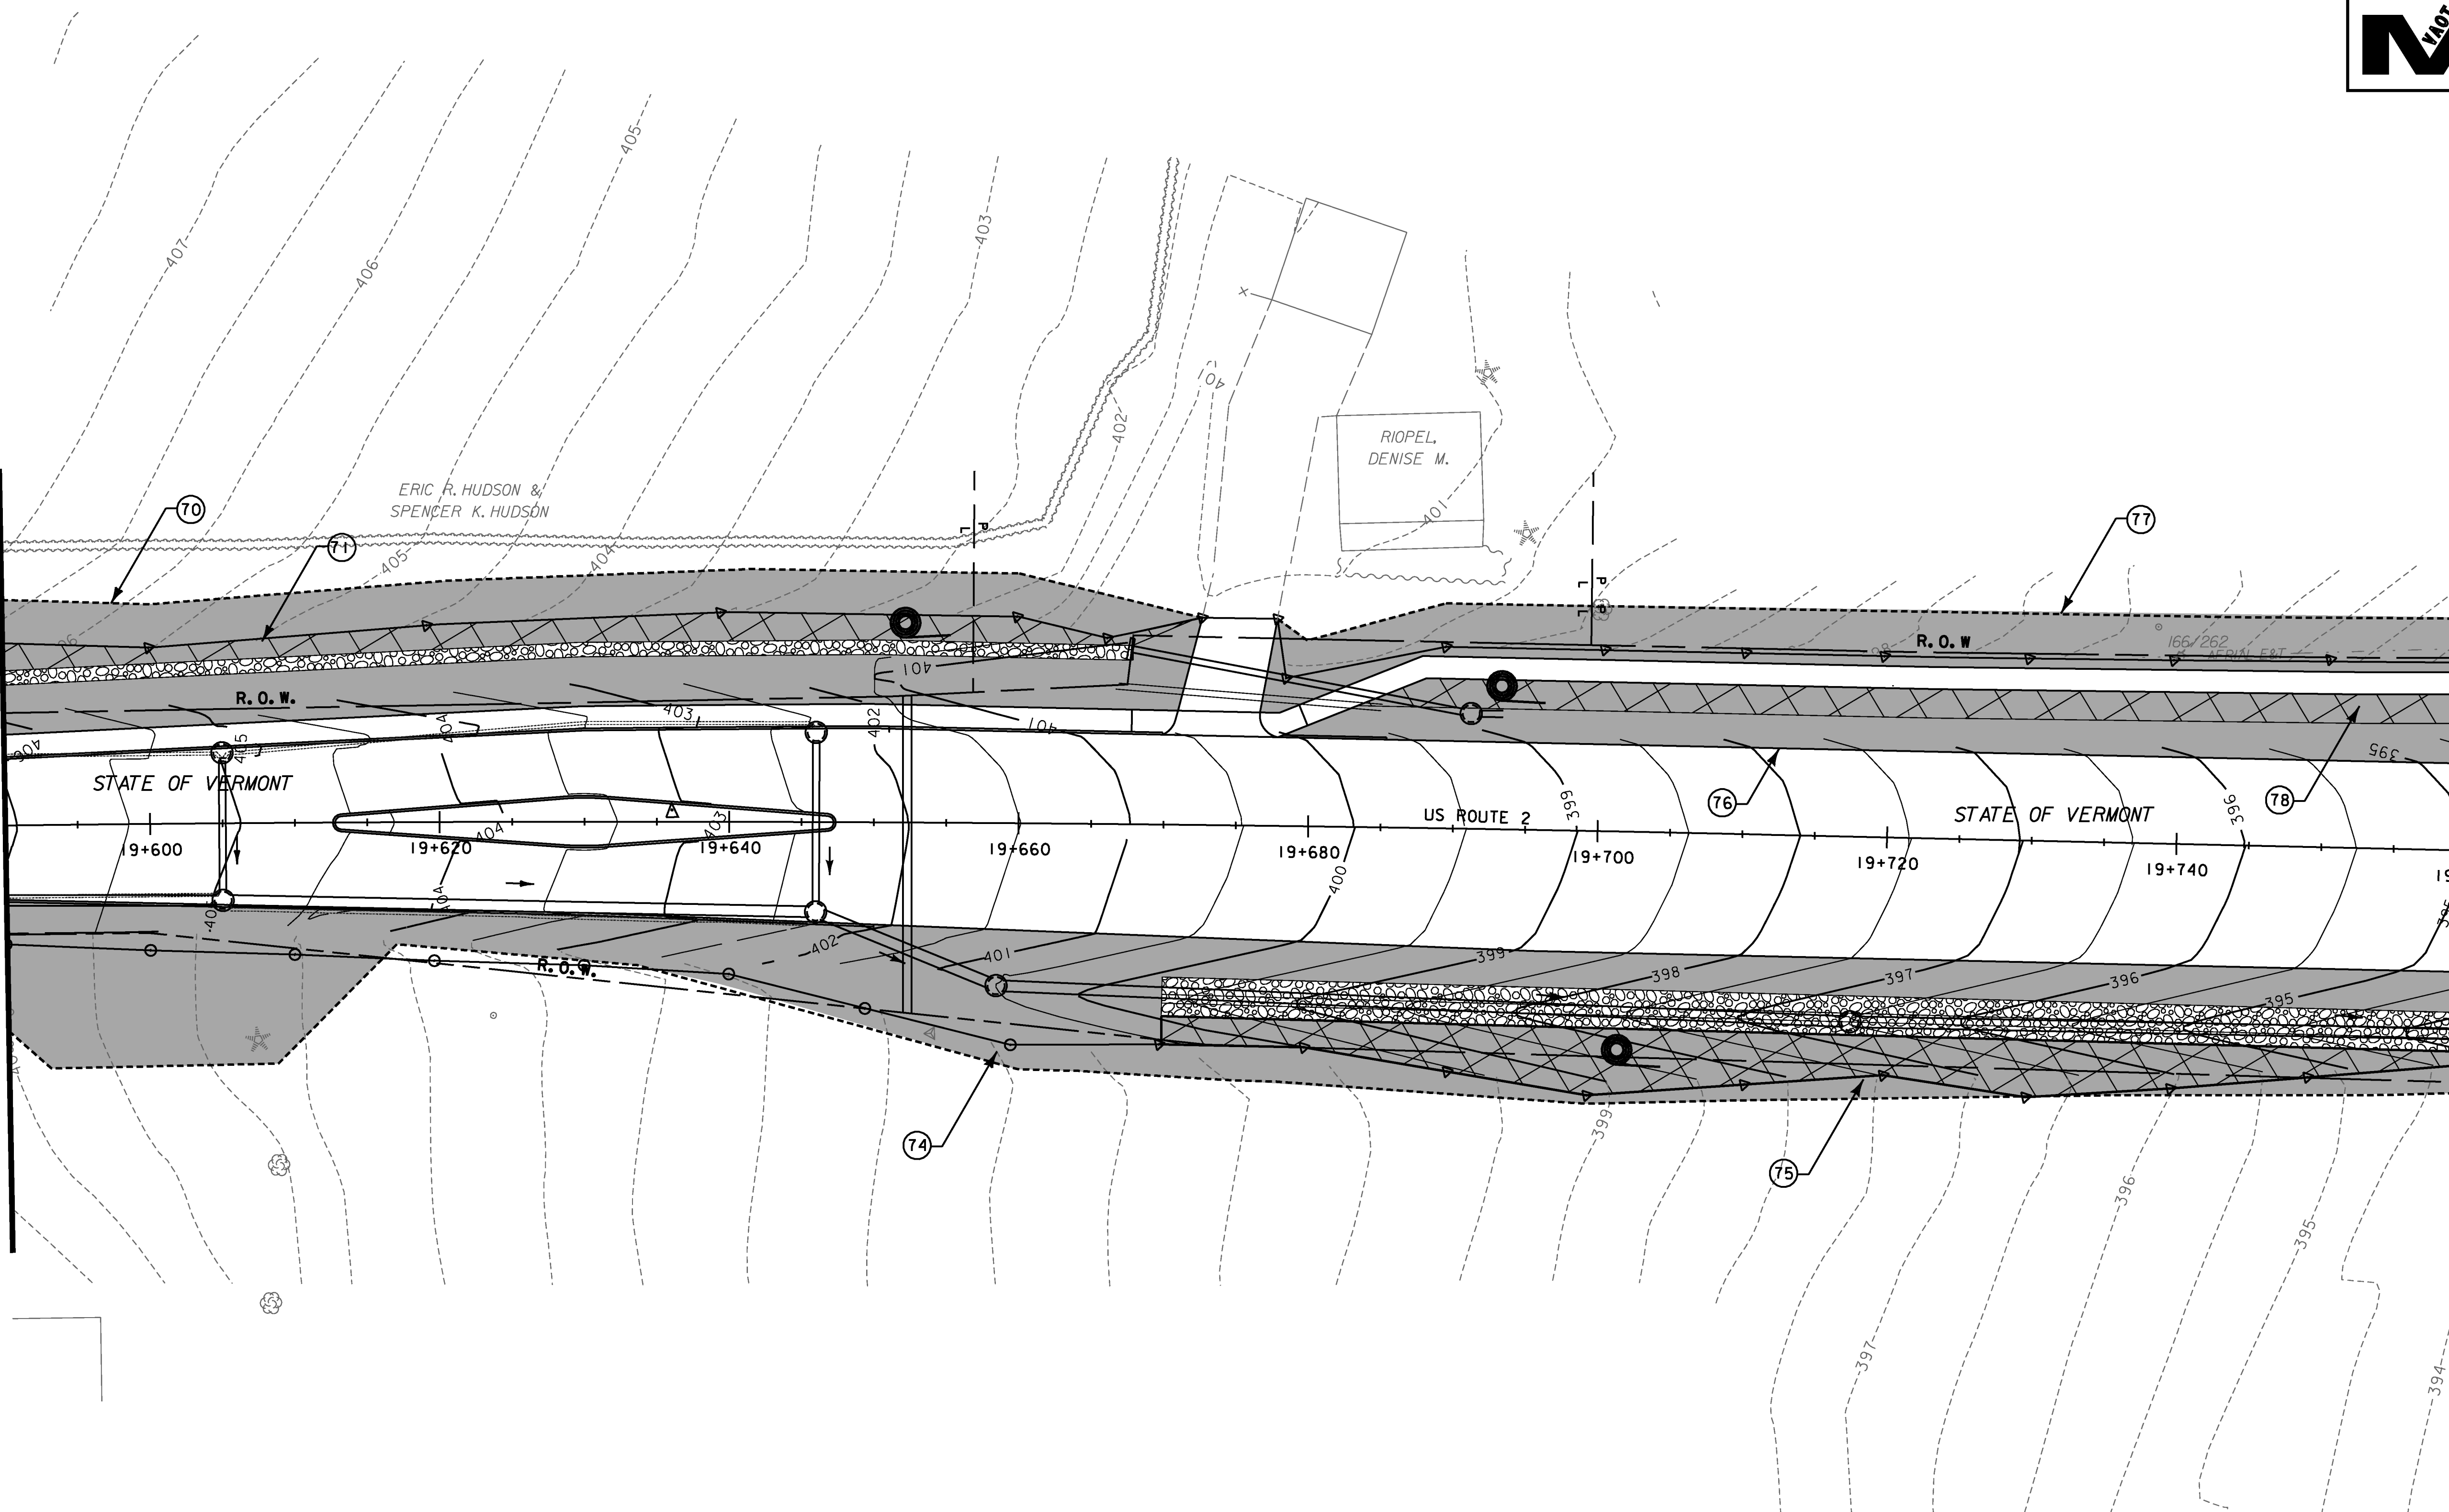


AREA NUMBER	651.15 - SEED 651.25 - HAY MULCH	651.15 - SEED 653.20 - TEMPORARY EROSION MATTING
	AREAS (SM)	AREAS (SM)
75		281.1
76	211.1	
77	348.1	
78		163.7

NOTE:
1. SEE EPSC STABILIZATION SITE PLAN EST-1 FOR GENERAL NOTES AND LEGEND

STA 19+590 TO 19+760

DATUM

VERTICAL	NAVD88
HORIZONTAL	NAD83(92)

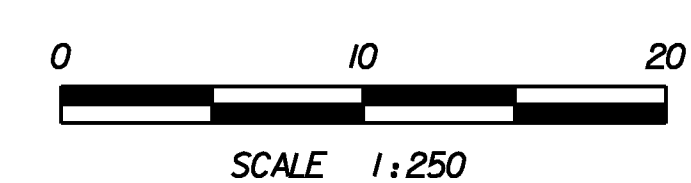

PROJECT NAME:	DANVILLE
PROJECT NUMBER:	F EGC 028-3(32)
FILE NAME:	...\\plotfiles\EPSC EST-09.prf
DESIGN SUPERVISOR:	GARY SANTY
DESIGNED BY:	STANTEC
EPSC STABILIZATION PLAN EST-9	
PLOT DATE:	1/18/2011
DRAWN BY:	STANTEC
CHECKED BY:	STANTEC
SHEET	137 OF 306

1/18/2011 11:52:46 PM v:\1953\active\1953\0033_0052\highway\plotfiles\EPSC EST-09.prf