

646.406 DURABLE 100 MM WHITE LINE,  
RECESSED POLYUREA  
646.600 TEMPORARY 100 MM WHITE LINE  
STA. 18+507.7 TO 18+600.0, LT.  
STA. 18+507.7 TO 18+600.0, RT.

646.456 DURABLE 200 MM YELLOW LINE,  
RECESSED POLYUREA  
646.650 TEMPORARY 200 MM YELLOW LINE  
STA. 18+520.0 TO 18+570.0 (DIAGONALS)  
STA. 18+590.0 TO 18+600.0 (DIAGONALS)


675.50 REMOVING SIGNS  
AS SHOWN - 10

675.60 ERECTING SALVAGED SIGNS  
AS SHOWN - 3

646.416 DURABLE 100 MM YELLOW LINE,  
RECESSED POLYUREA  
646.610 TEMPORARY 100 MM YELLOW LINE  
STA. 18+507.7 TO 18+520.0, C (DOUBLE)  
STA. 18+520.0 TO 18+570.0, LT (DOUBLE)  
STA. 18+520.0 TO 18+570.0, RT (DOUBLE)  
STA. 18+590.0 TO 18+600.0, LT (DOUBLE)  
STA. 18+590.0 TO 18+600.0, RT (DOUBLE)  
STA. 18+570.0 TO 18+590.0, LT (SINGLE)  
STA. 18+570.0 TO 18+590.0, RT (SINGLE)

646.81 PAINTED CURB  
STA. 18+569.8 TO 18+590.2, ISLAND

646.494 DURABLE LETTER OR SYMBOL, POLYUREA  
STA. 18+509.0, RT - "SCHOOL"

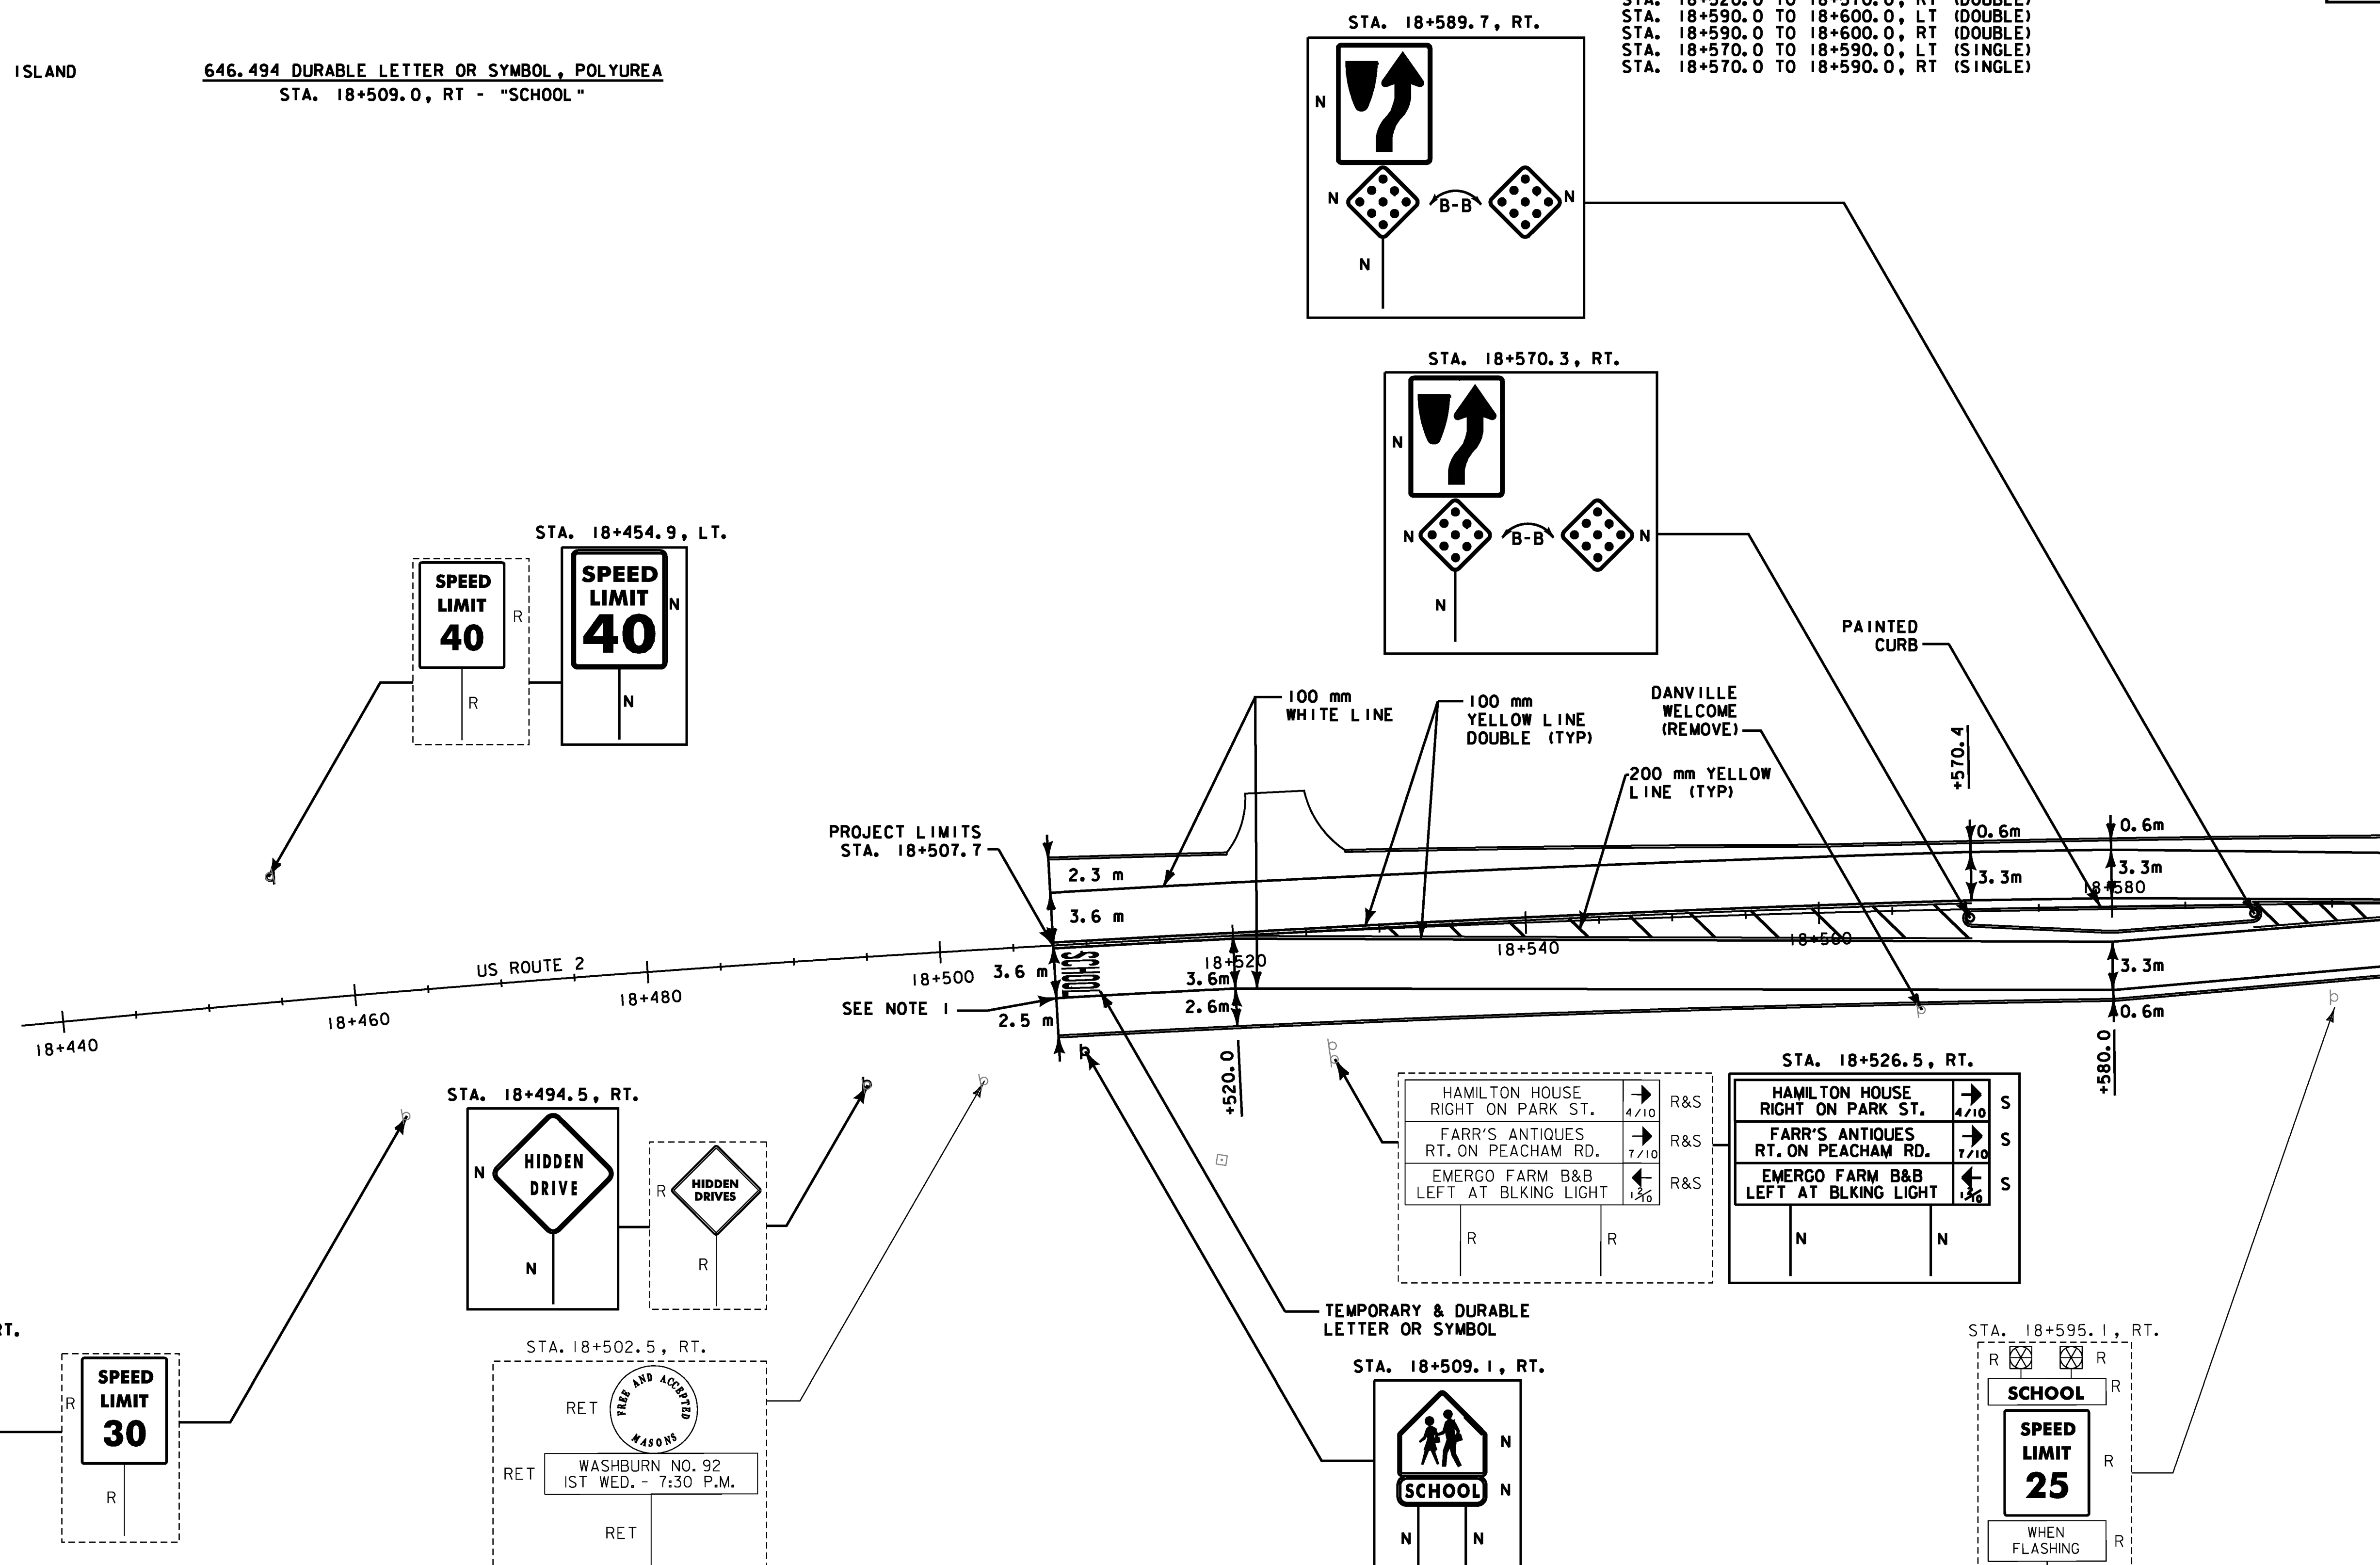


MATCH LINE - STA. 18 + 600 SEE SHEET SP-2

- NOTES:**
1. MATCH EXISTING STRIPING CONFIGURATION.
  2. REMOVE EXISTING FLASHING BEACON SHALL BE PAID INCIDENTAL TO ALL OTHER SIGN ITEMS.

**SIGN LEGEND**

N	= NEW
R	= REMOVE
R&S	= REMOVE & SALVAGE
S	= SALVAGE SIGN
RET	= RETAIN
-B-B-	= BACK TO BACK
- - -	= EXISTING
— — —	= PROPOSED

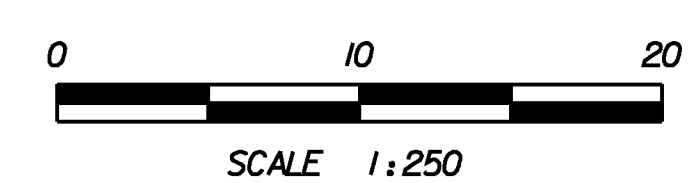

PROJECT NAME: DANVILLE  
 PROJECT NUMBER: F EGC 028-3(32)  
 FILE NAME: ...Highway\PlotFiles\101ps0l.ppf PLOT DATE: 1/18/2011  
 DESIGN SUPERVISOR: GARY SANTY DRAWN BY: STANTEC  
 DESIGNED BY: STANTEC CHECKED BY: STANTEC  
**SIGNING & PAVEMENT PLAN SHEET SP-1** SHEET 145 OF 306

1/18/2011 11:53:00 PM v:\1953\vac\five\9530033\_0192\Highway\PlotFiles\101ps0l.ppf