

646.406 DURABLE 100 MM WHITE LINE,  
RECESSED POLYUREA  
646.600 TEMPORARY 100 MM WHITE LINE  
STA. 19+260.0, LT TO 06+009.3, LT  
STA. 06+009.3, RT TO 19+450.0, LT  
STA. 19+260.0, RT TO 07+011.3, RT  
STA. 07+011.7, LT TO 19+450.0, RT

646.416 DURABLE 100 MM YELLOW LINE,  
RECESSED POLYUREA  
646.610 TEMPORARY 100 MM YELLOW LINE  
STA. 19+260.0 TO 19+428.4, (DOUBLE)  
STA. 06+012.3 TO 06+027.5, (DOUBLE)  
STA. 07+012.3 TO 07+027.5, (DOUBLE)  
STA. 19+440.5 TO 19+450.0, (DOUBLE)

646.486 DURABLE 600 MM STOP BAR,  
RECESSED POLYUREA  
646.680 TEMPORARY 600 MM STOP BAR  
STA. 06+012.3, LT (HIGHLAND AVE.)  
STA. 07+012.3, LT (MOUNTAIN VIEW RD.)

646.494 DURABLE LETTER OR SYMBOL, POLYUREA  
646.690 TEMPORARY LETTER OR SYMBOL  
STA. 06+015.1, LT. - "STOP"  
STA. 07+015.1, LT. - "STOP"  
STA. 19+283.0, LT. - "SCHOOL"




STA. 6+016.3, RT.




675.50 REMOVING SIGNS  
AS SHOWN - 15

675.60 ERECTING SALVAGED SIGNS  
AS SHOWN - 1


STA. 19+383.4, LT.

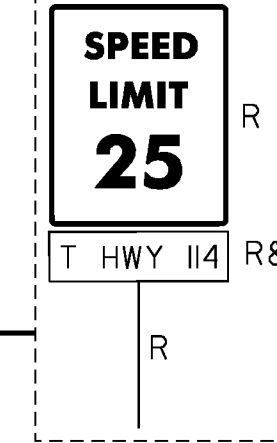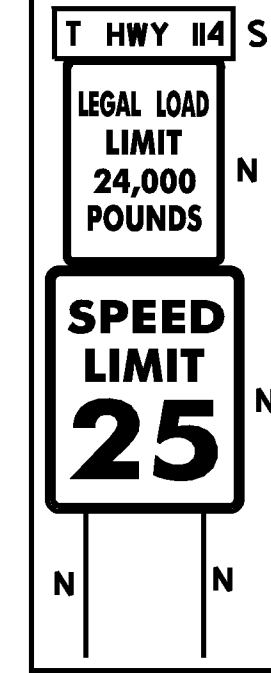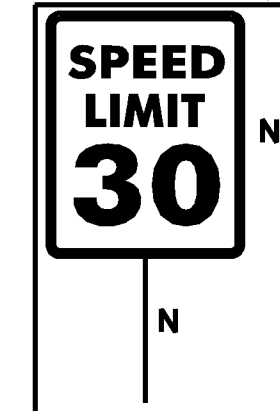


STA. 19+282.6, LT.

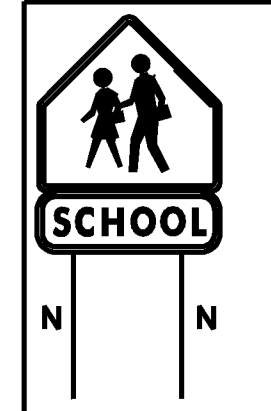


STA. 19+327.0, LT.

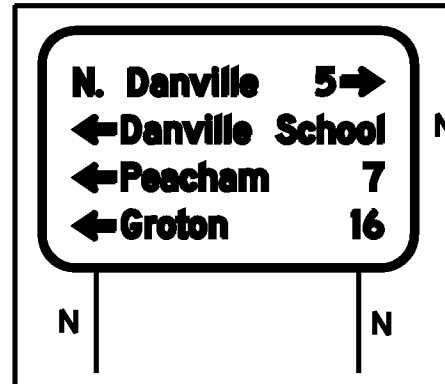



STA. 19+376.3, LT.

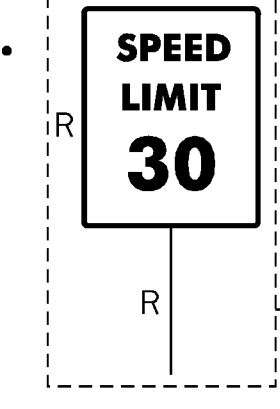

STA. 19+363.3, LT.

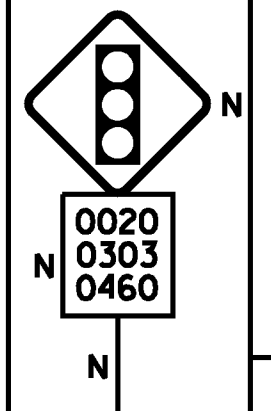


STA. 19+363.2, LT.

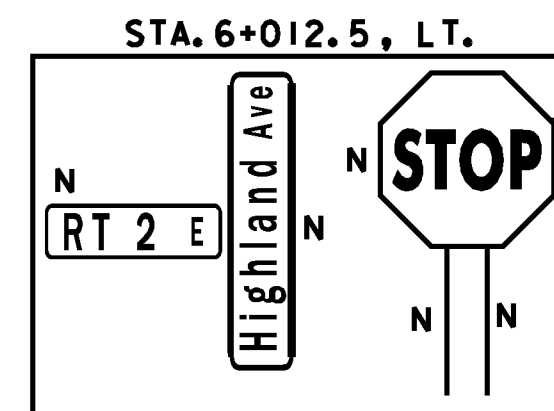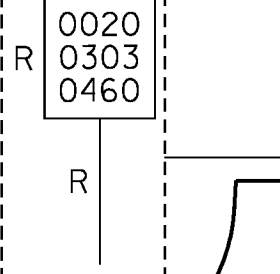

TEMPORARY & DURABLE LETTER OR SYMBOL (TYP)  
TEMPORARY & DURABLE 600 mm STOP BAR (TYP)


STA. 6+012.5, LT.

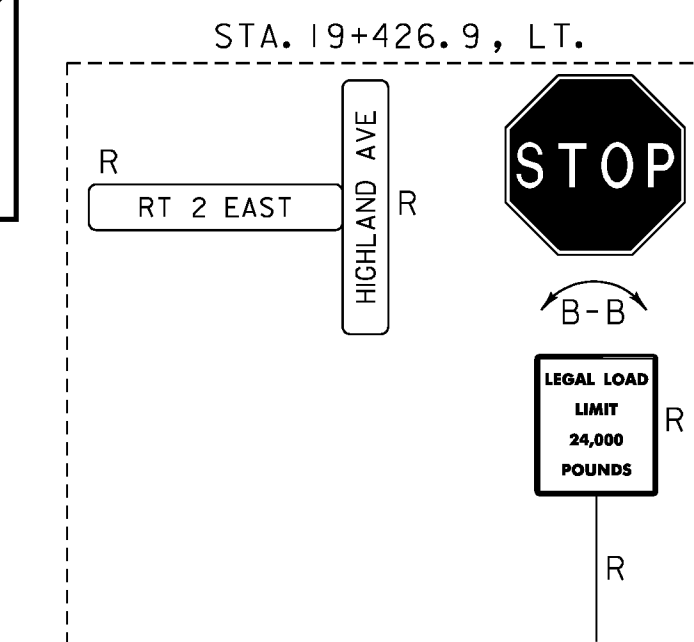

STA. 19+426.9, LT.


MATCH LINE - STA. 19+260 SEE SHEET SP-5

STA. 19+281.0, LT.

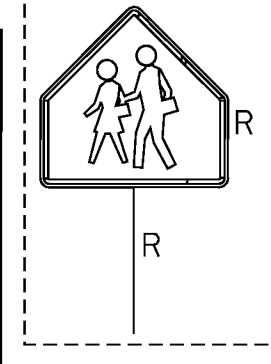


100 mm WHITE LINE (TYP)  
100 mm YELLOW LINES (TYP)  
TEMPORARY & DURABLE LETTER OR SYMBOL


STA. 19+279.2, RT.

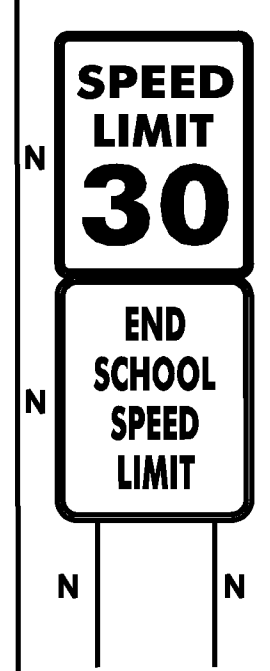



STA. 19+398.1, RT.

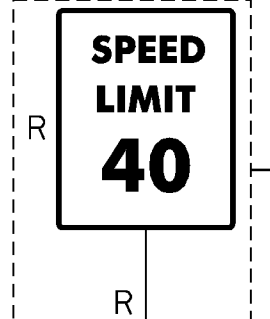


STA. 19+439.5, RT.

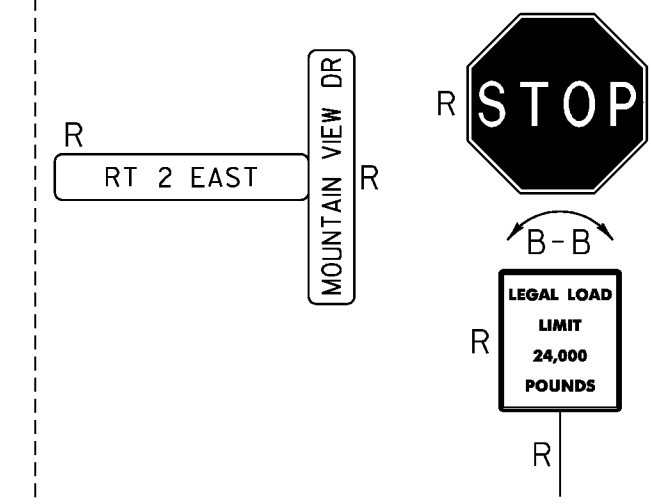

STA. 7+012.3, RT.

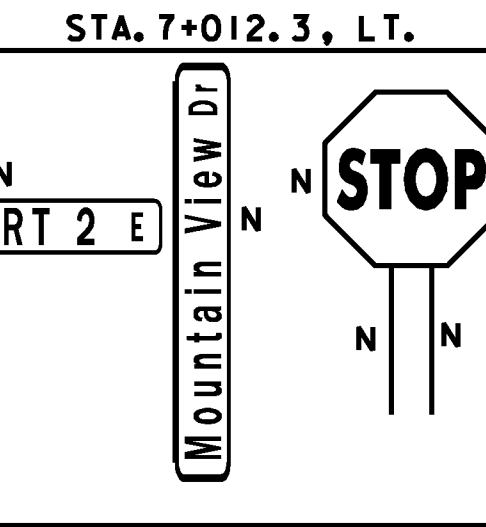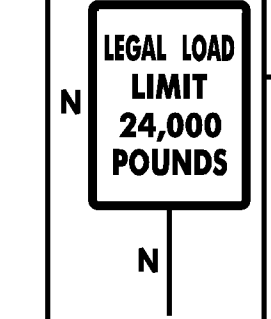


STA. 19+448.1, RT.

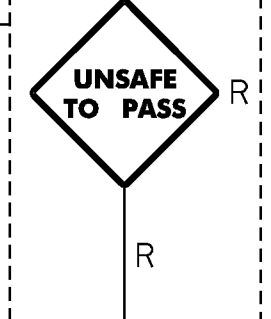

MATCH LINE - STA. 19+450 SEE SHEET SP-8

NOTE:  
SEE SHEET SP-1 FOR LEGEND.

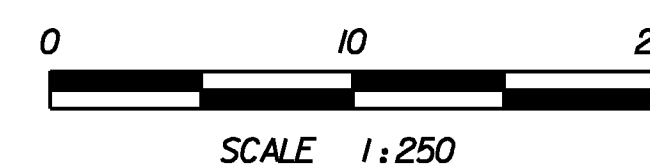

PROJECT NAME: DANVILLE  
PROJECT NUMBER: F EGC 028-3(32)

FILE NAME: ...Highway\PlotFiles\I08 ps07.pff PLOT DATE: 1/18/2011  
DESIGN SUPERVISOR: GARY SANTY DRAWN BY: STANTEC  
DESIGNED BY: STANTEC CHECKED BY: STANTEC  
SIGNING & PAVEMENT PLAN SHEET SP-7 SHEET 152 OF 306