

POWER SOURCE FOR TRAFFIC SIGNAL EQUIPMENT


678.23 WIRED CONDUIT

	NO.	DIA.	REMARKS
MA-3 TO JB-1	1	50mm	SIGNAL & VIDEO
JB-1 - JB-3	2	50mm	SIGNAL & VIDEO
JB-3 - CONTROLLER	2	50mm	SIGNAL & VIDEO
PP-2 - JB-3	1	50mm	SIGNAL
MA-2 - CONTROLLER	2	50mm	SIGNAL & VIDEO
CONTROLLER - JB-7	1	50mm	POWER
JB-7 - JB-8	1	50mm	POWER
JB-8 - JB-9	1	50mm	POWER
JB-9 - JB-10	1	50mm	POWER
JB-10 - POWER SOURCE	1	50mm	POWER
CONTROLLER - JB2	2	50mm	SIGNAL & VIDEO
JB-2 - PP-1	1	50mm	SIGNAL
JB-2 - JB-4	2	50mm	SIGNAL & VIDEO & LIGHTING
JB-4 - SL-51	2	50mm	SIGNAL
JB-4 - JB-5	2	50mm	SIGNAL & VIDEO & LIGHTING
JB-5 - SL49	2	50mm	SIGNAL & VIDEO & LIGHTING
JB-5 - JB-6	2	50mm	SIGNAL & VIDEO
JB-6 - MA-1	2	50mm	SIGNAL & VIDEO

VEHICLE DETECTORS

CAMERA DETECTION AREA	LANE	CALL Ø	SIZE (M)	TYPE	PULSE OR PRESENCE	DELAY	LOCKING MEMORY
2	US 2 EASTBOUND	2	1.8x12.0	OPTICAL	PRESENCE		NO
4	HILL STREET	4	1.8x12.0	OPTICAL	PRESENCE	5 SEC	NO
6	US 2 WESTBOUND	6	4.5x12.0	OPTICAL	PRESENCE		NO
8	PEACHAM RD.	8	1.8x12.0	OPTICAL	PRESENCE	5 SEC	NO

NEMA PHASING CHART

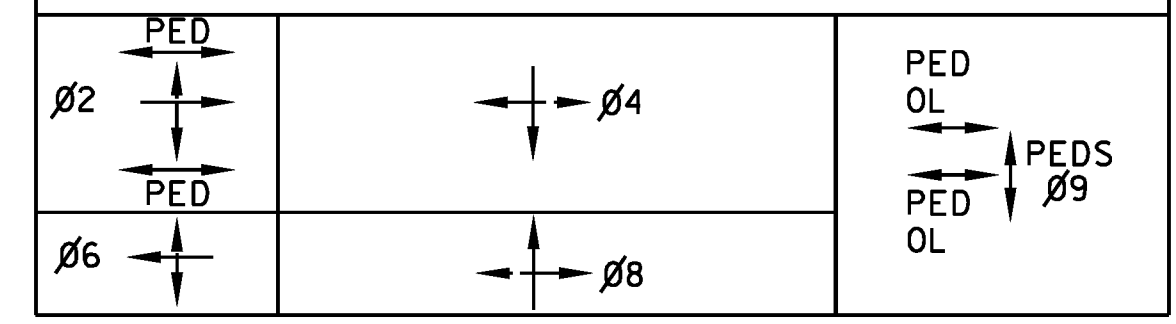

TIME OF DAY PROGRAMMING

TIME OF DAY	DAY	MODE / PROGRAM	FREE	COORD	FLASH	MAX I	MAX II	MAX III
0000 - 0600	M-F, S-S	ON				ON		
0600 - 0900	M-F, S-S	ON				ON		
0900 - 1500	M-F, S-S	ON				ON		
1500 - 1800	M-F, S-S	ON				ON		
1800 - 2200	M-F, S-S	ON				ON		
2200 - 0000	M-F, S-S	ON				ON		

CONTROLLER TIMINGS (SECONDS)

PHASES	MIN GREEN	EXTENSION	YELLOW	RED	MAX I	WALK	FDW	DW
Ø2+Ø6	15	2	4	2	30	9	10	2
Ø4+Ø8	5	2	4	2	20	-	-	-
Ø9	-	-	-	-	-	7	16	2

LEGEND


EXISTING	NEW	DISCRIPTION
		UTILITY POLE
		LUMINAIRE
		LIGHT OR WOOD POLE
		STRAIN POLE/CANTILEVER
		CONTROLLER CABINET
		PULLBOX/JUNCTION BOX
		SIGNAL HEAD
		CONDUIT
		CONDUIT SLEEVE
		PEDESTAL POST
		VIDEO DETECTION AREA
		VIDEO DETECTION CAMERA

678.25 PULL BOX, STANDARD

LOCATION AND DESCRIPTION
4+022.02, 6.04m RT JB-1
4+022.44, 8.67m LT JB-3
19+190.55, 5.36m LT JB-4
19+180.66, 10.86m LT JB-5
19+165.08, 11.17m LT JB-6
19+193.10, 14.36m RT JB-7
19+219.68, 17.73m RT JB-8
19+231.87, 17.85m RT JB-9
19+233.67, 8.02m RT JB-10


678.30 ELECTRICAL CONDUIT SLEEVE

LOCATION	DIAM.
HILL STREET 3+011.21, 6.59m LT - 3+011.19, 6.91m RT	200 mm
US ROUTE 2 19+190.45, 4.70m LT - 19+189.02, 17.19m RT	200 mm
PEACHAM ROAD 4+021.87, 5.42m RT - 4+021.94, 7.13m LT	200 mm
SMITH STREET 5+017.69, 4.80m LT - 5+017.78, 3.60m RT	N/A
USE STREET LIGHT SLEEVE	

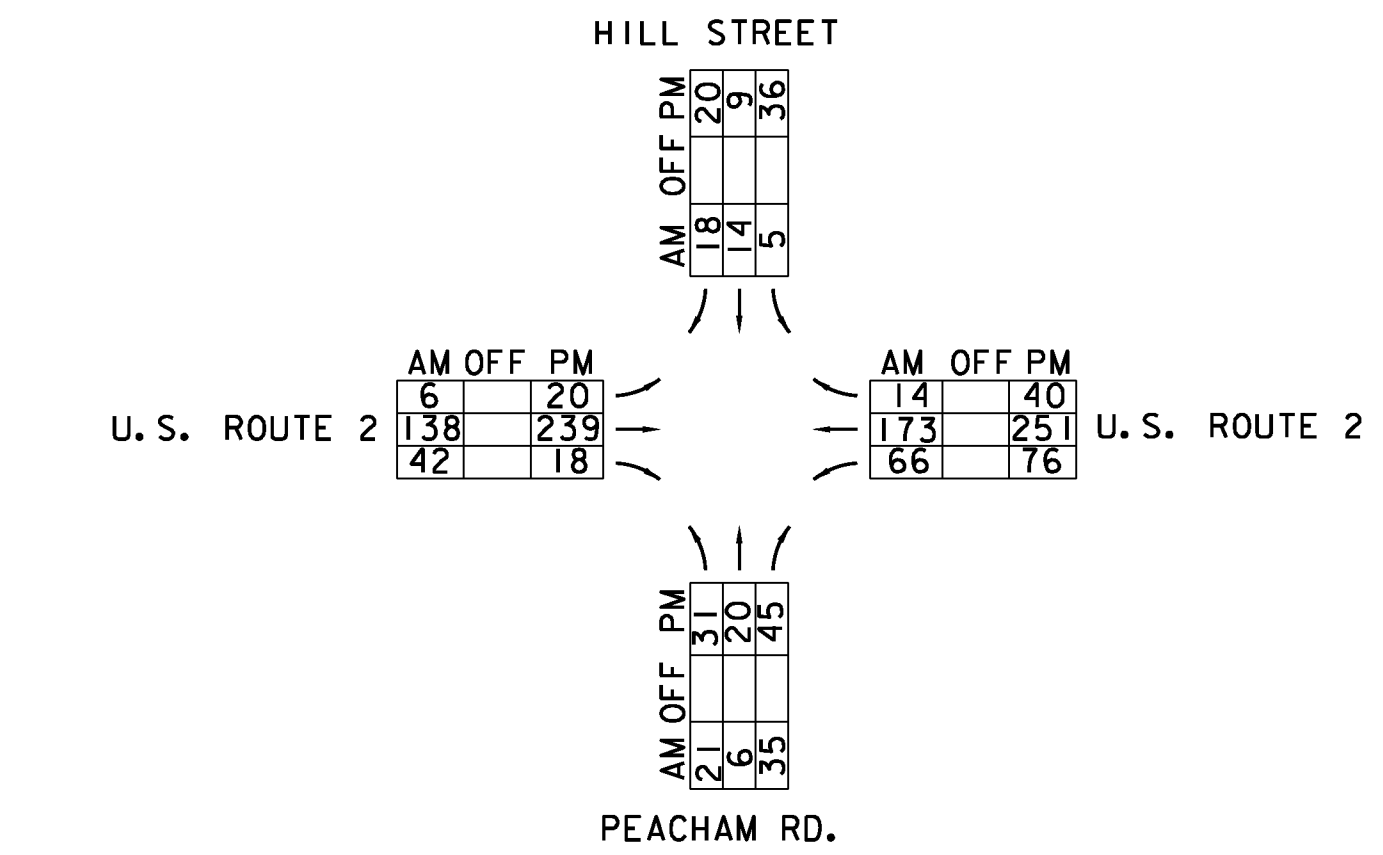


SIGNAL NO. 2,4,6,8 WITH 125mm BACK PLATES PEDESTRIAN P2, P9

SIGNAL FACE ARRANGEMENT

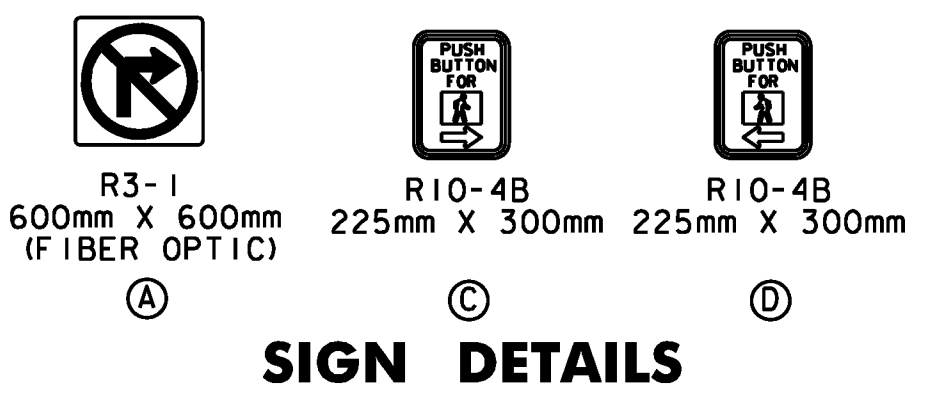

REPLACEMENT SHEETS
ISSUED 02/24/2012

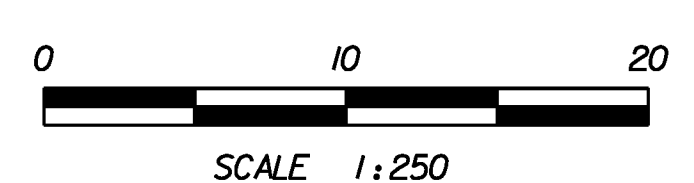

PROJECT NAME: DANVILLE
PROJECT NUMBER: F EGC 028-3(32)

FILE NAME: ...\\PlotFiles\TsigPlan-01.ptf
DESIGN SUPERVISOR: GARY SANTY
DESIGNED BY: DAVID DEBAIE
TRAFFIC SIGNAL DETAIL TSD-1

PLAT DATE: 2/24/2012
DRAWN BY: STANTEC
CHECKED BY: STANTEC
SHEET 167 OF 306

2/24/2012 4:30:02 PM V:\953\ccr\Five\9530033_0092\Highway\PlotFiles\TsigPlan-01.ptf

- NOTES:**
- MAST ARM AND PEDESTRIAN SIGNAL FOUNDATIONS ARE TO BE PLACED WITHIN 1.5m OF ACCESS RAMP AND WITHIN A 600 mm REACH FROM A LEVEL AREA TO POSITION PEDESTRIAN SIGNAL CALL BUTTONS STATIONING, AND OFFSET OF MAST ARM POLES/ FOUNDATIONS MAY CHANGE SLIGHTLY FROM PLANS TO ALLOW THIS. CHANGES FROM LOCATIONS SHOWN ON PLANS MUST BE APPROVED BY THE ENGINEER.
 - VIDEO DETECTION SYSTEM SHALL BE PAID UNDER ITEM 678.15
 - ACCESSIBLE PEDESTRIAN ACCESS SHALL BE PROVIDED TO PUSH BUTTON FOR PEDESTRIAN HEAD.