


MAST ARM #1 - US ROUTE #2  
19+164 (LOOKING BACKSTATION - WESTERLY)



MAST ARM #3 - PEACHAM ROAD  
4+022.26 (LOOKING UPSTATION - SOUTHERLY)

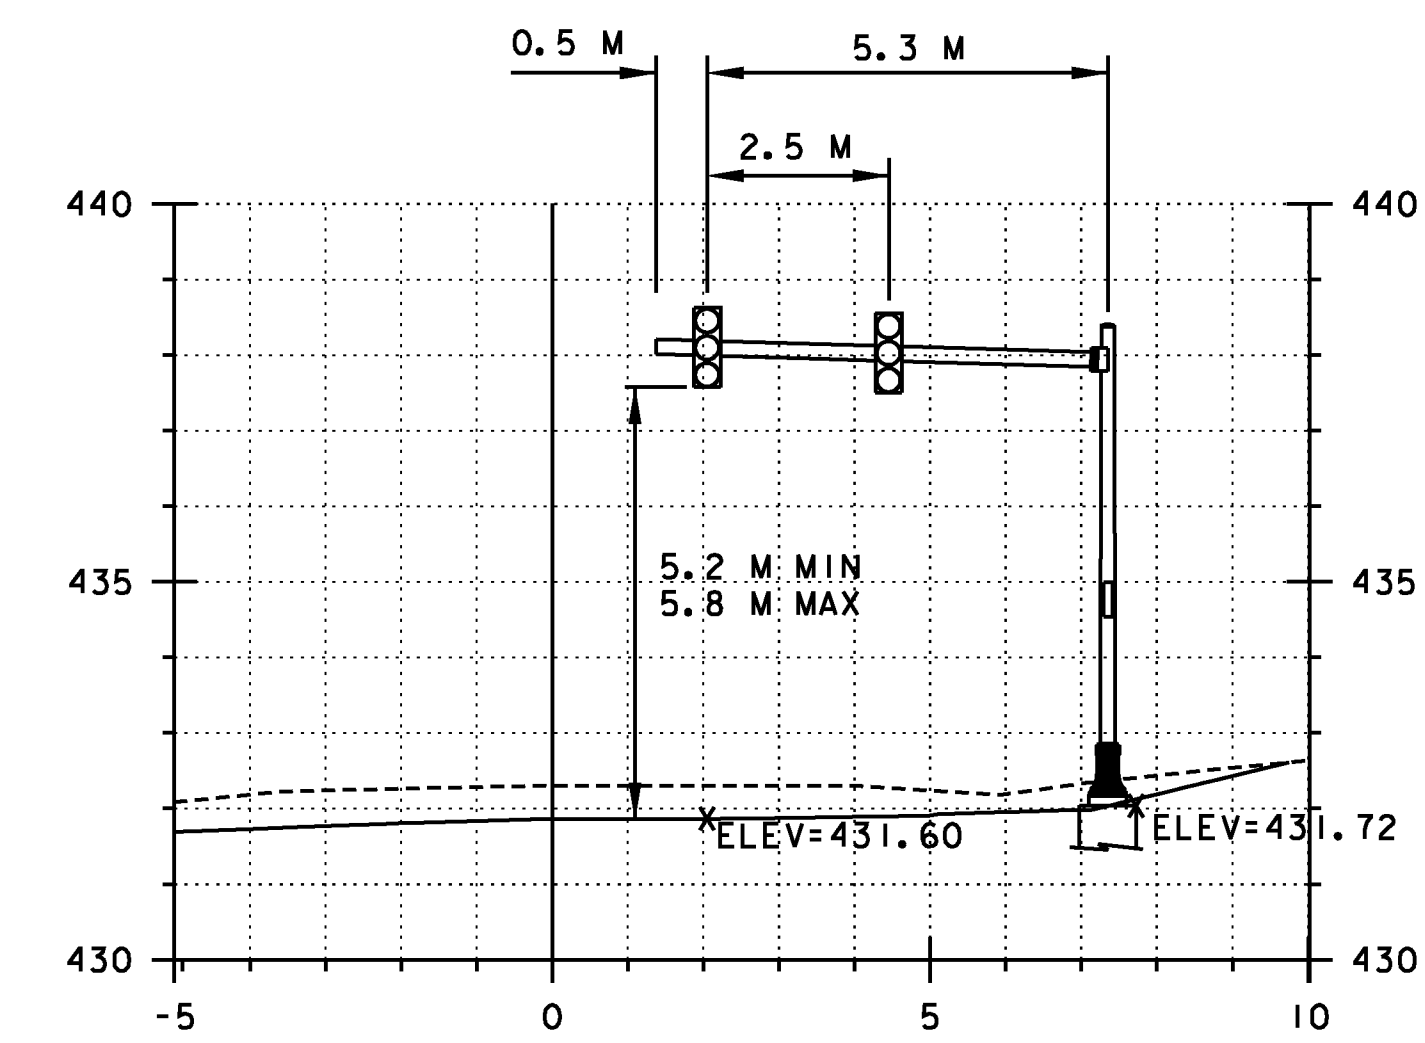

MAST ARM #2 - PEACHAM ROAD  
4+008.48, 1.30m LT - 4+018.24, 11.04m LT  
ARM ON BEARING N 56° 55' 56" W

PROJECT NAME: DANVILLE  
PROJECT NUMBER: F EGC 028-3(32)

FILE NAME: ...\\PlotFiles\MastArms.pxf PLOT DATE: 1/18/2011  
DESIGN SUPERVISOR: GARY SANTY DRAWN BY: STANTEC  
DESIGNED BY: STANTEC CHECKED BY: STANTEC  
MAST ARM DETAIL MAD-3 SHEET 173 OF 306

