




TYPICAL DUCT 1

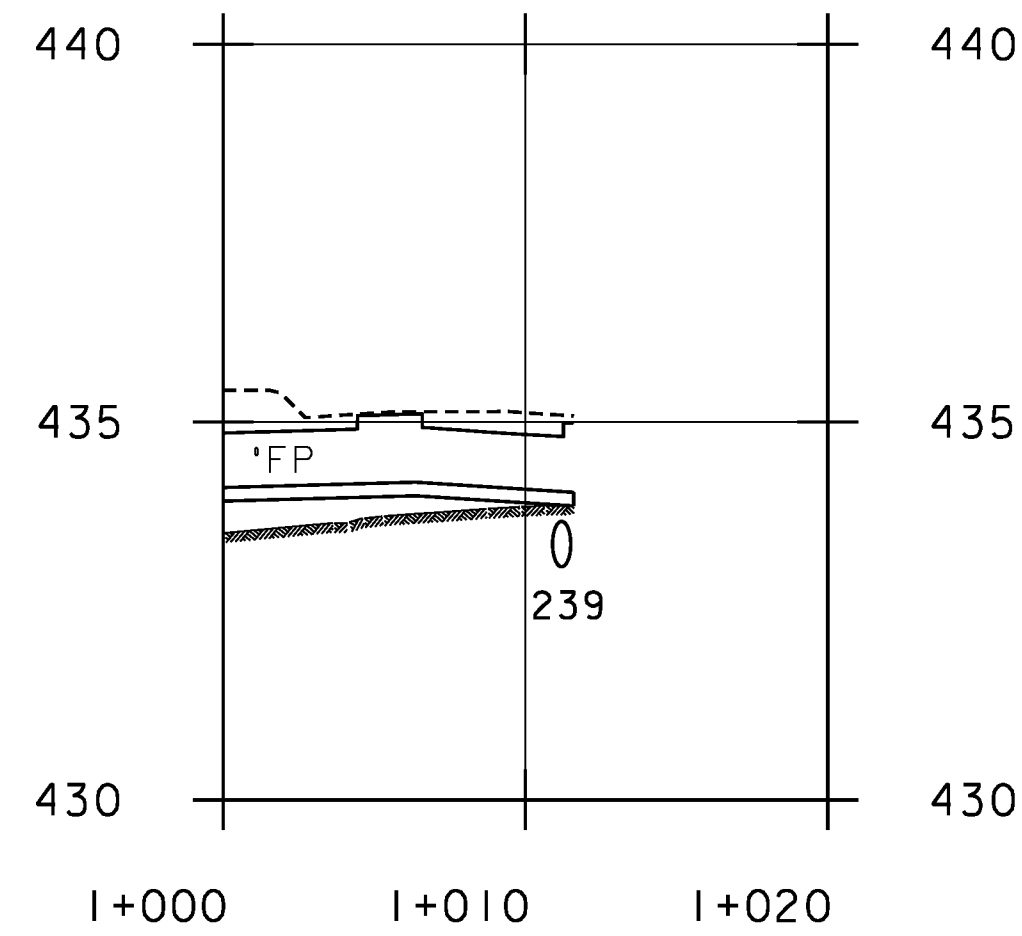


TYPICAL DUCT 2

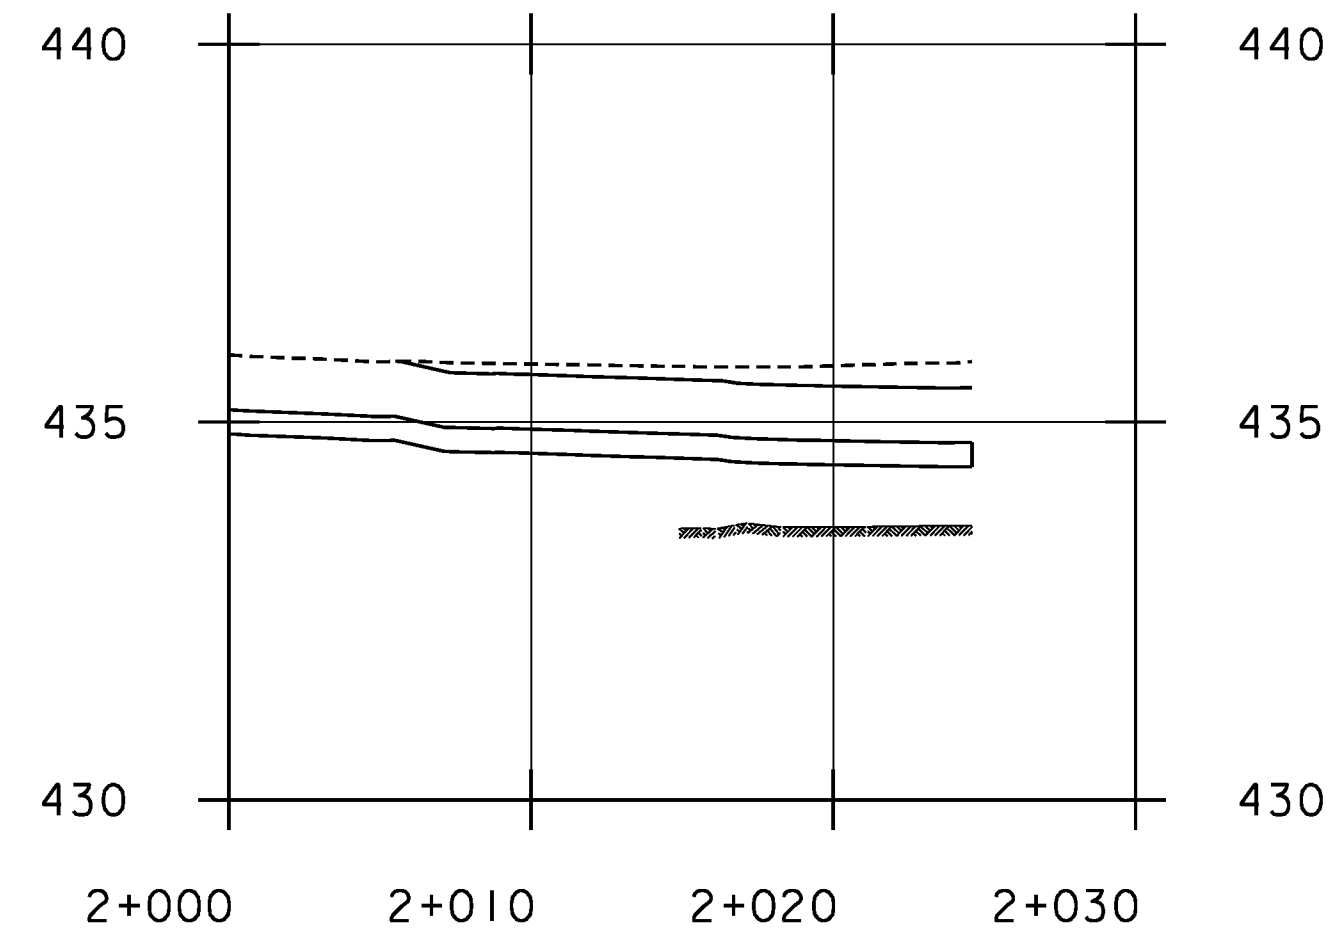

TYPICAL DUCT 3

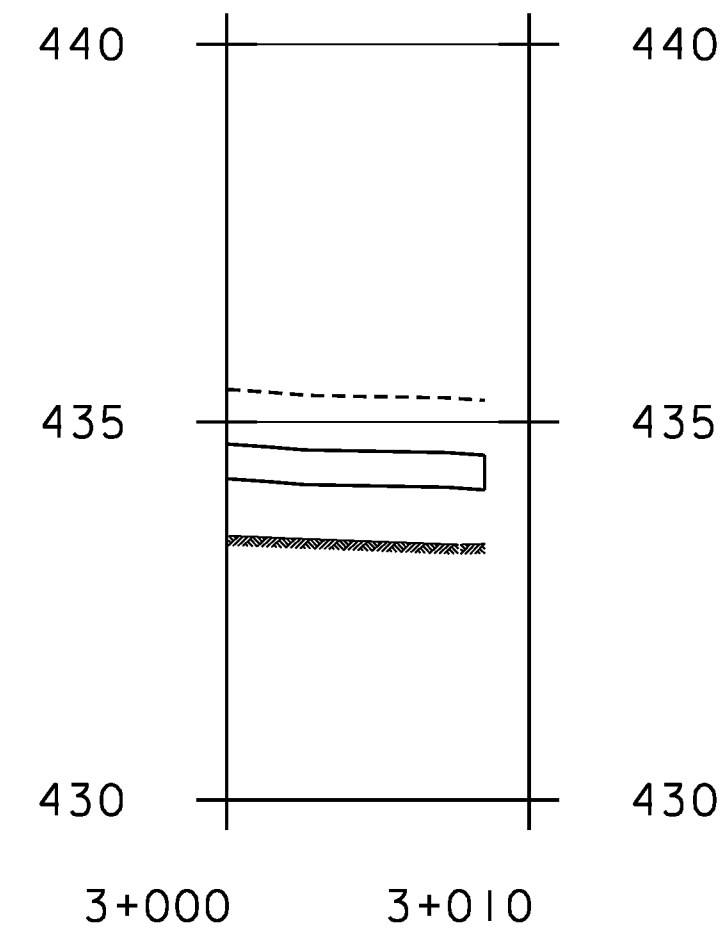




TYPICAL DUCT 4

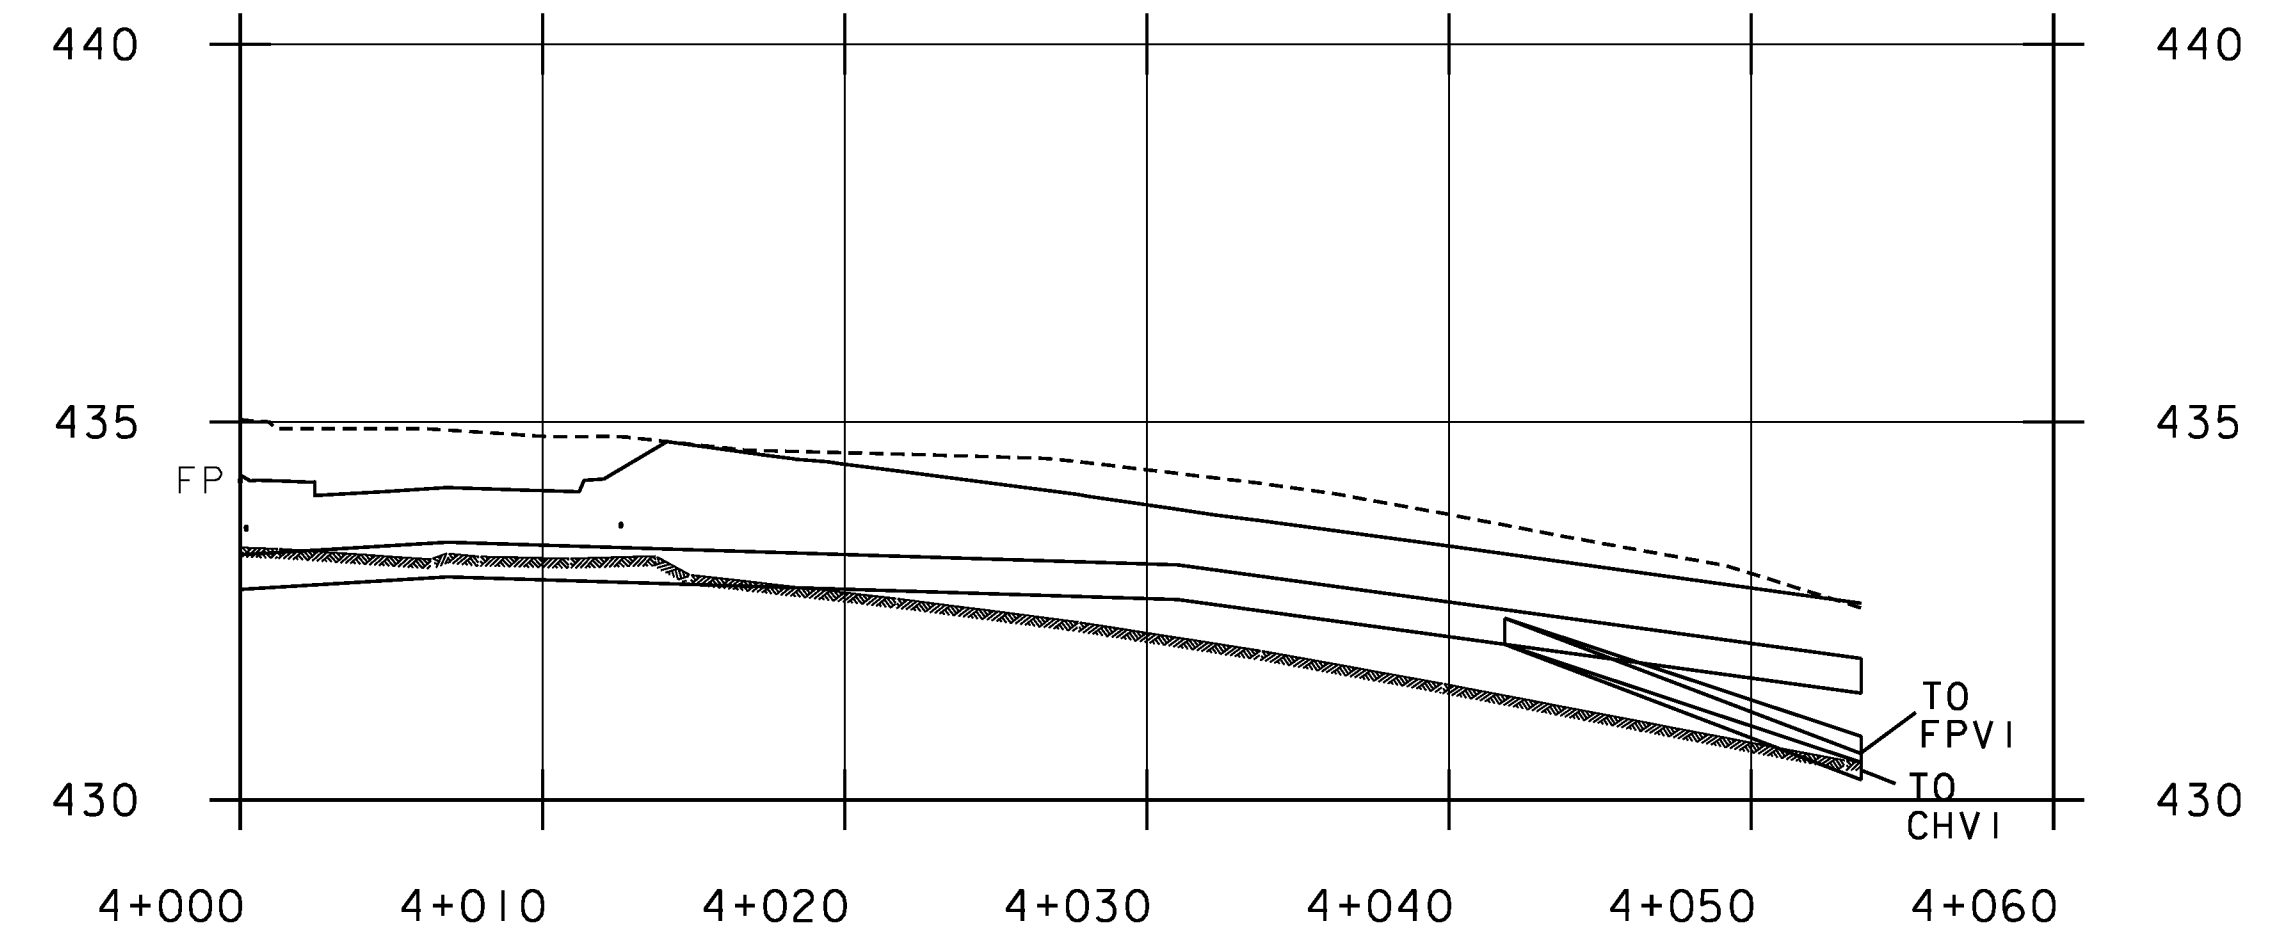

TYPICAL DUCT 5

TYPICAL DUCT 7

TYPICAL DUCT 6

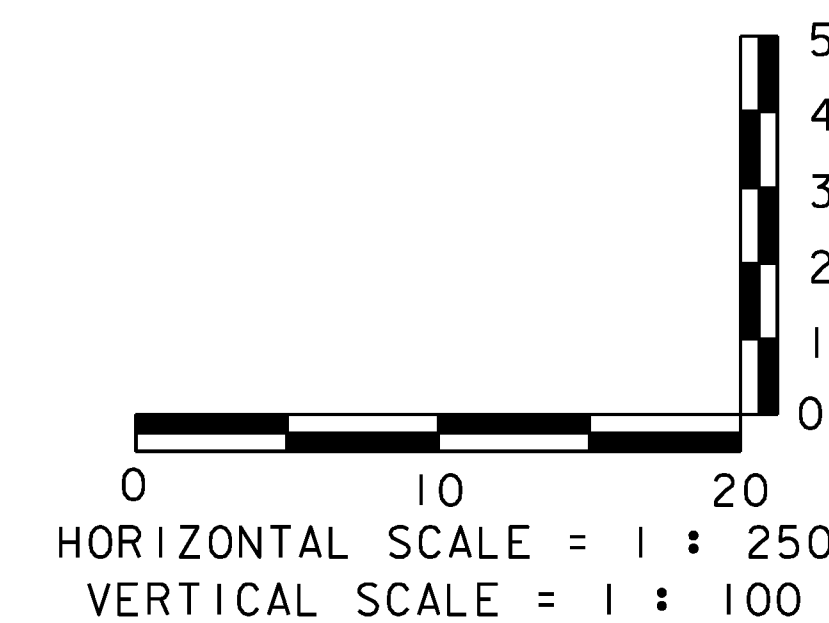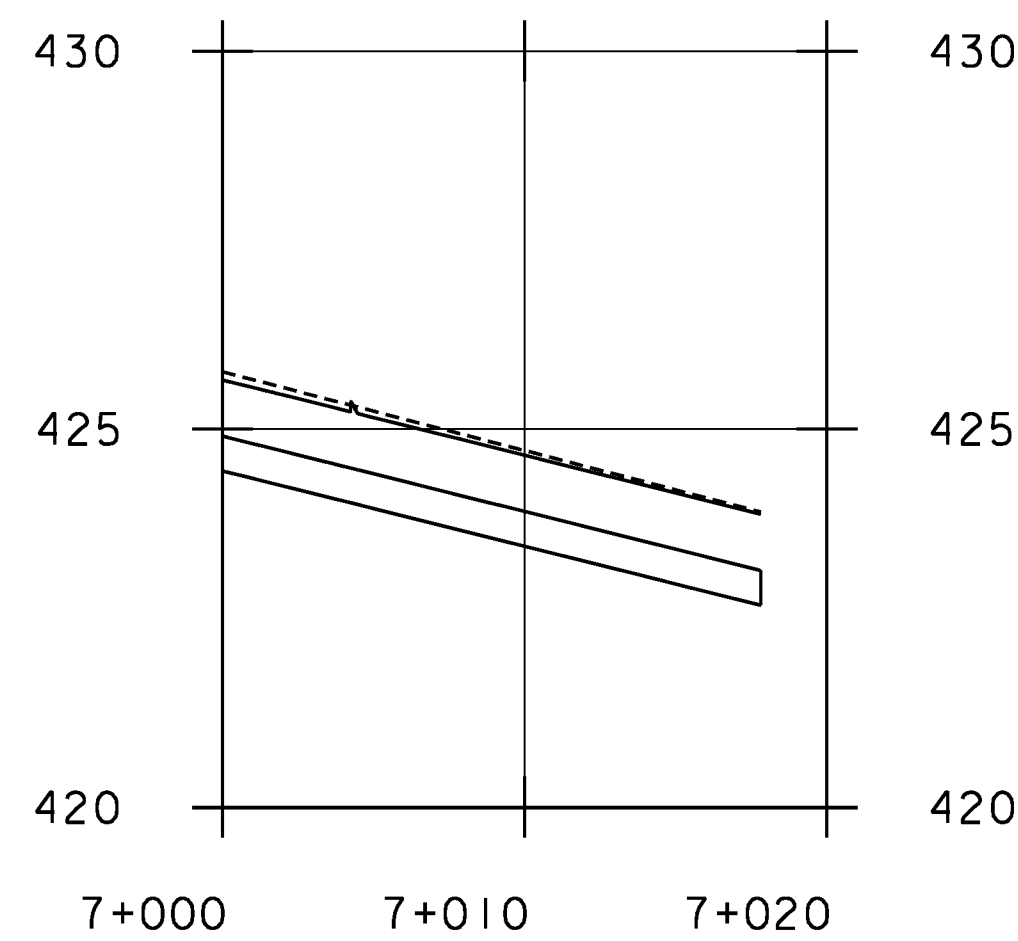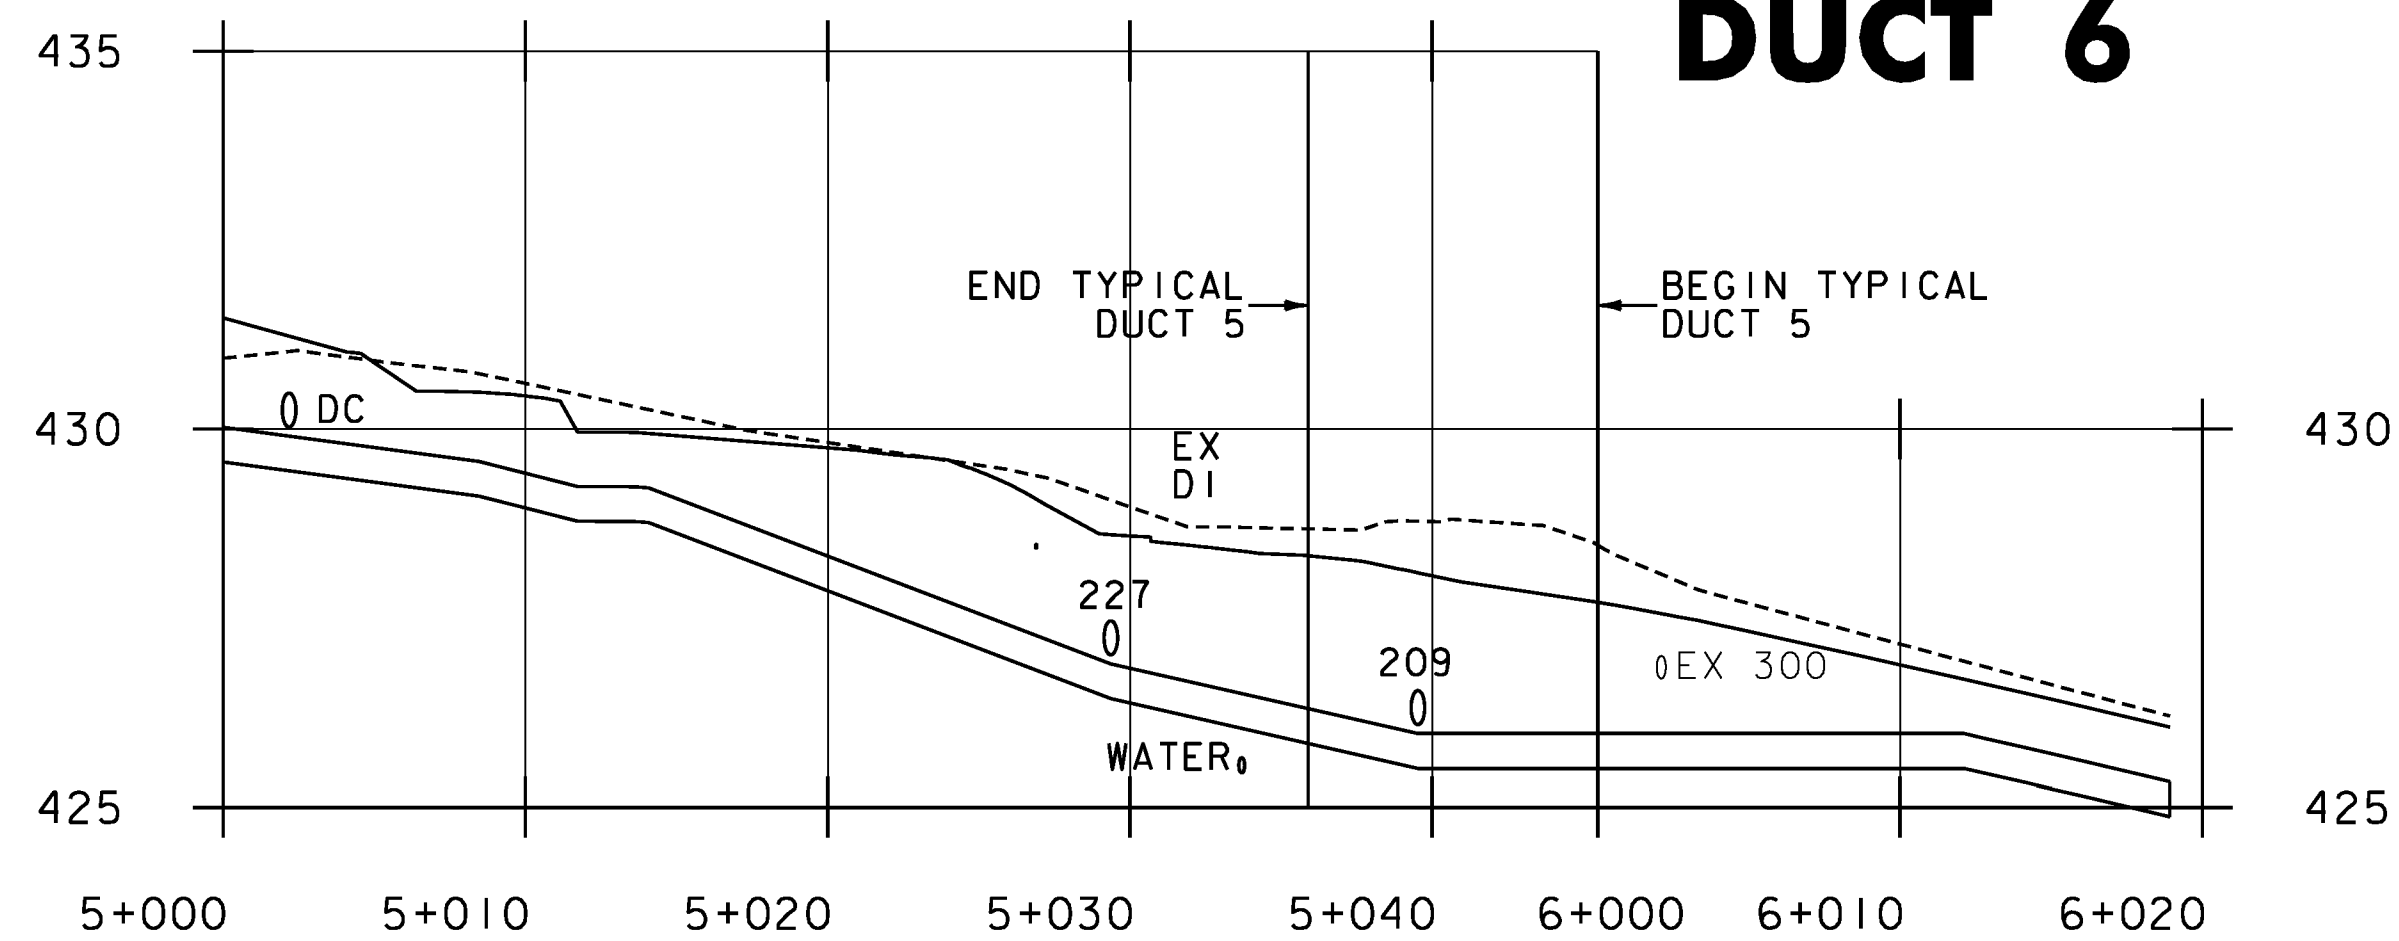

- EXISTING GRADE
- FINISH GRADE
- (T) CVPS 3-PHASE
- (S) CVPS SINGLE PHASE

NOTE:
BEGIN AND END OF DUCT SHALL CORRESPOND
TO DIRECTION OF ARROWHEAD ON UTILITY
PLANS.

**REPLACEMENT SHEETS
ISSUED 02/24/2012**



PROJECT NAME: DANVILLE
PROJECT NUMBER: F EGC 028-3(32)
FILE NAME: ...\\100 det_profiles.ptf
DESIGN SUPERVISOR: GARY SANTY
DESIGNED BY: STANTEC
DUCT BANK PROFILES DTP-01
PLOT DATE: 2/24/2012
DRAWN BY: STANTEC
CHECKED BY: STANTEC
SHEET 215 OF 306