




### CHARTER BETWEEN DUCTS TD4 & TD5

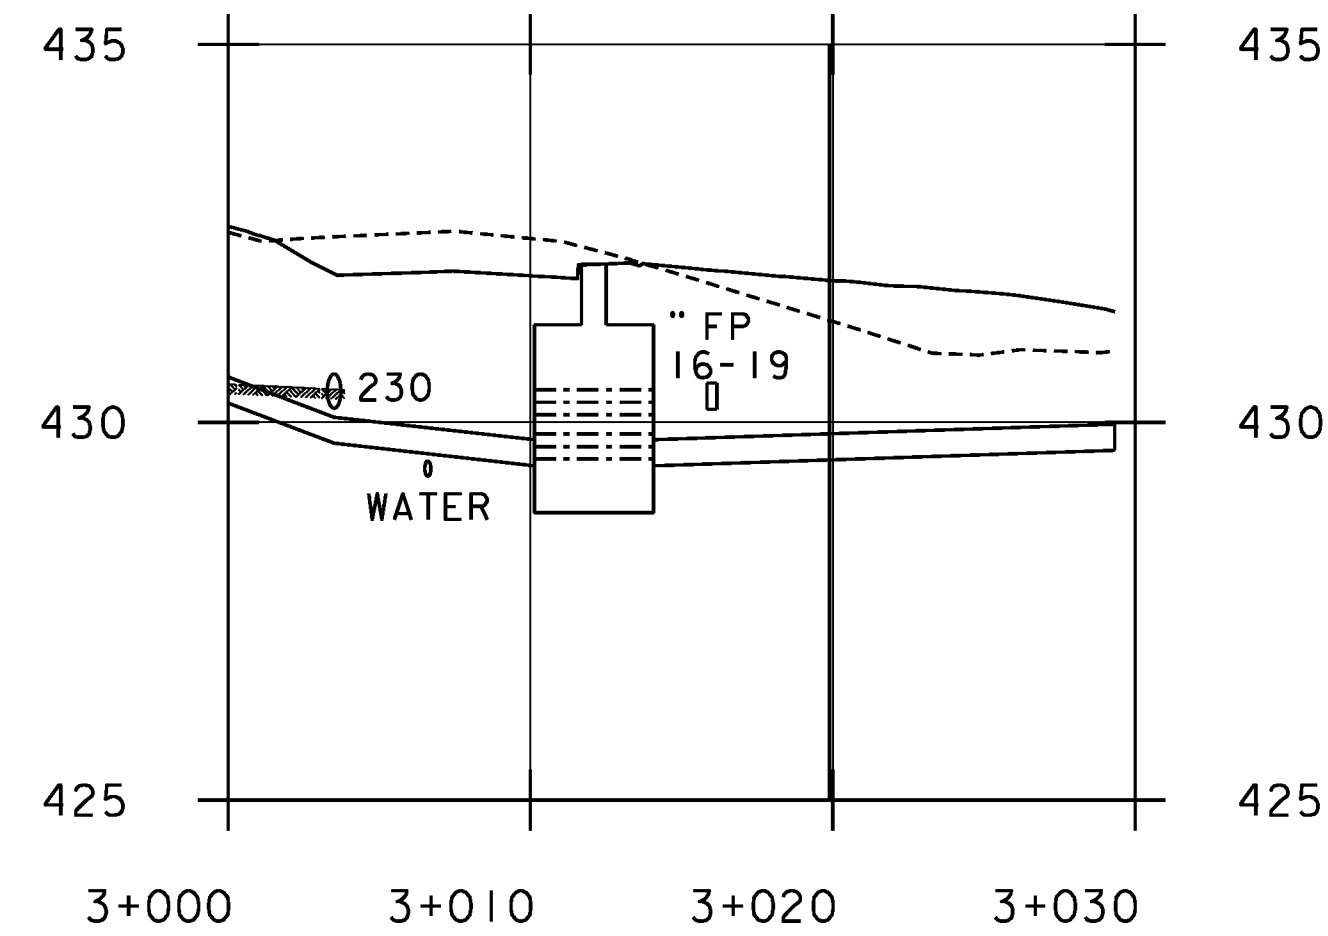


### CHARTER BETWEEN DUCTS TD8 & TD13

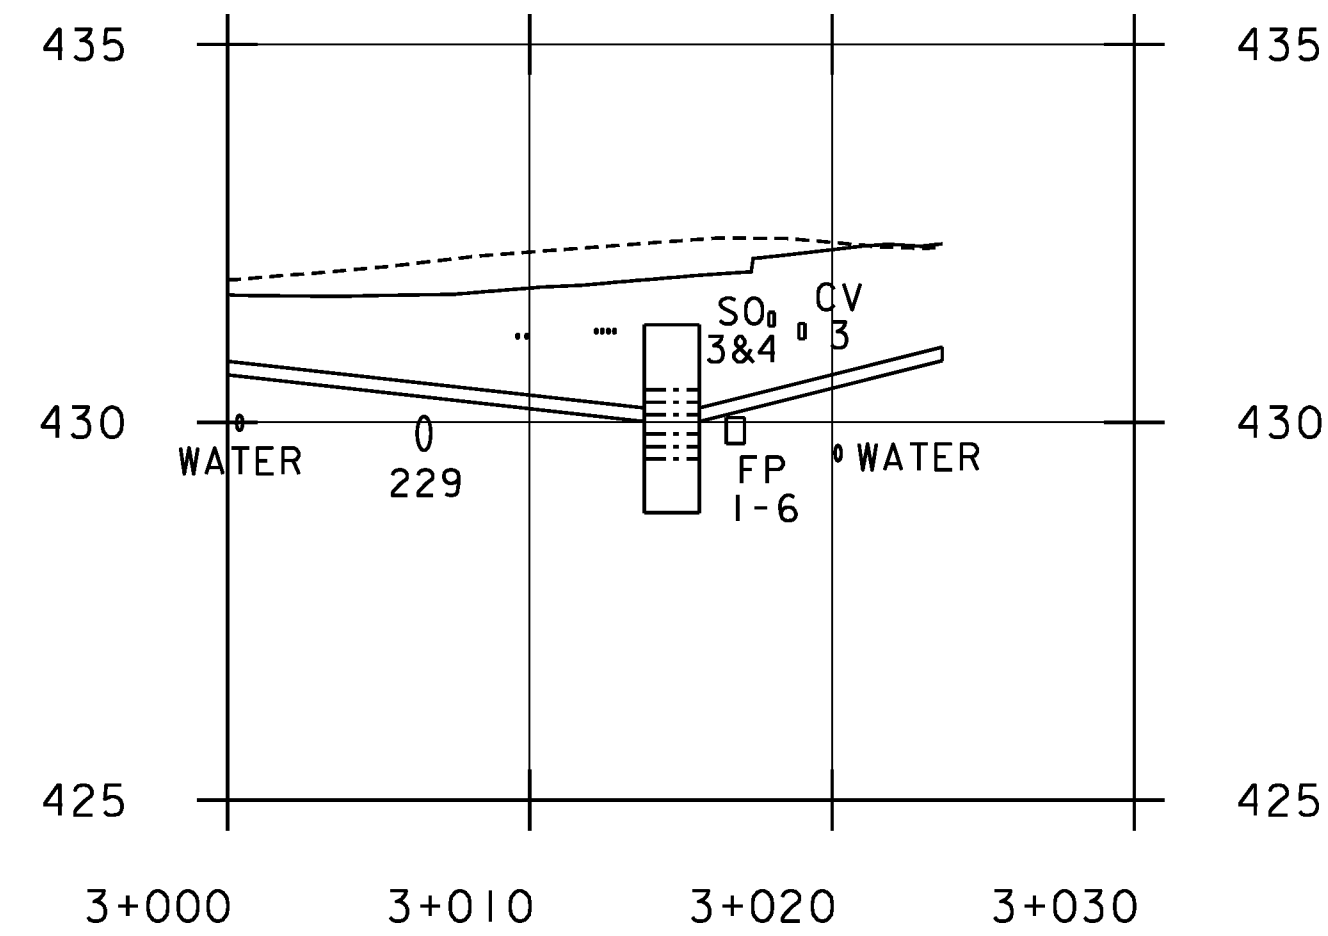


### FAIRPOINT BETWEEN DUCTS TD4 & TD5

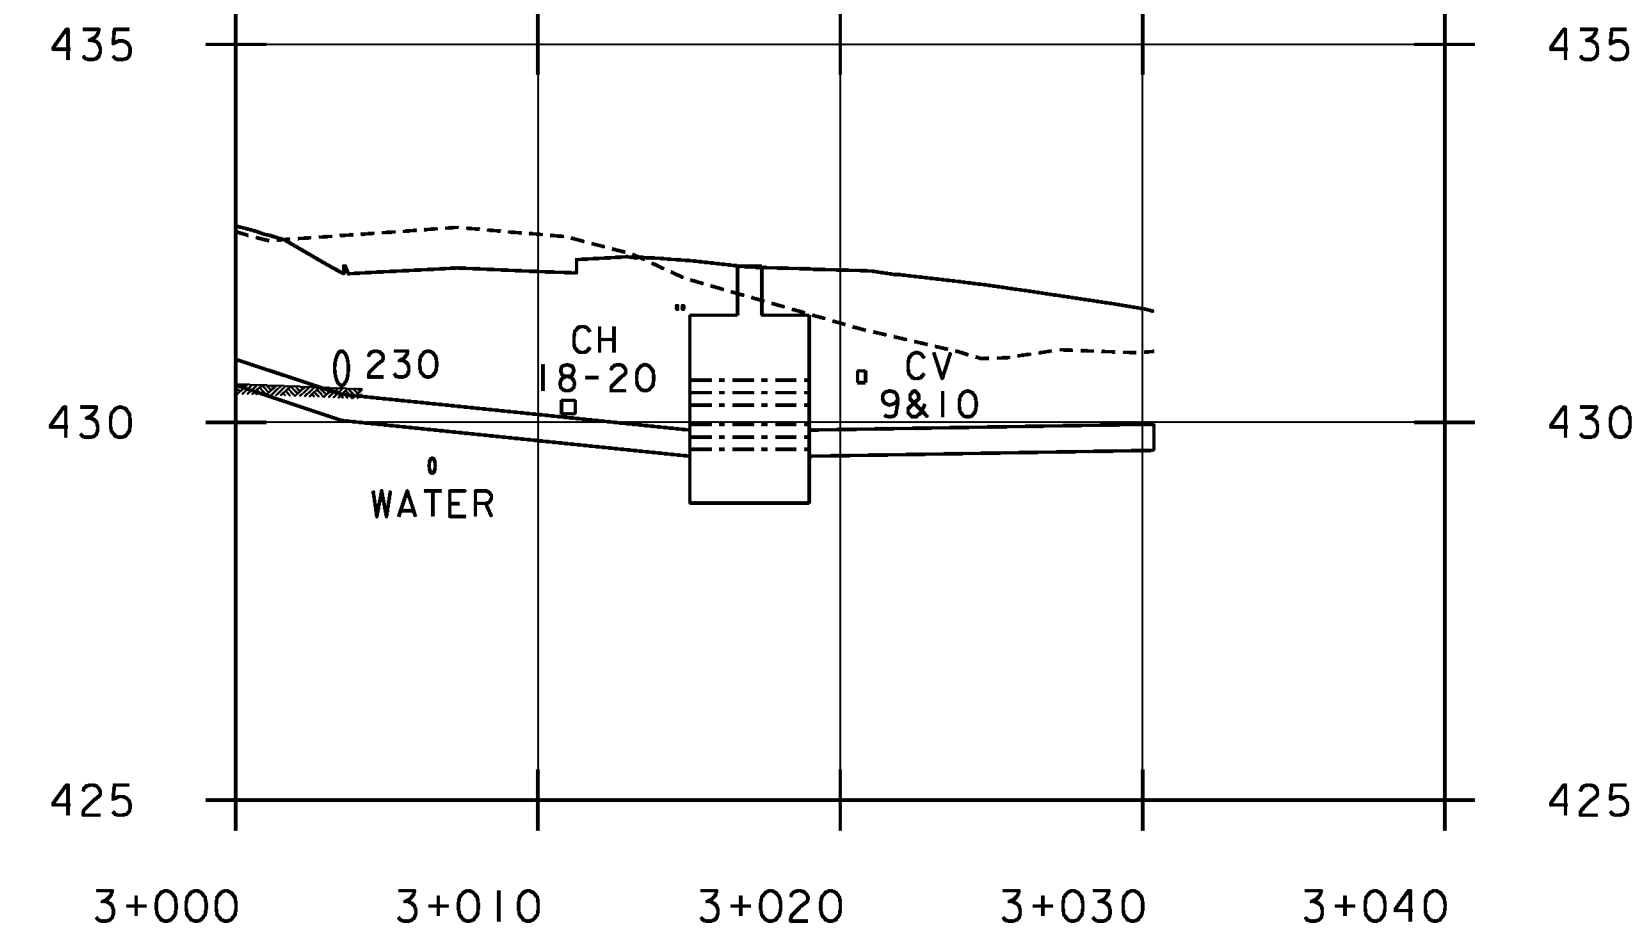



### FAIRPOINT BETWEEN DUCTS TD8 & TD13

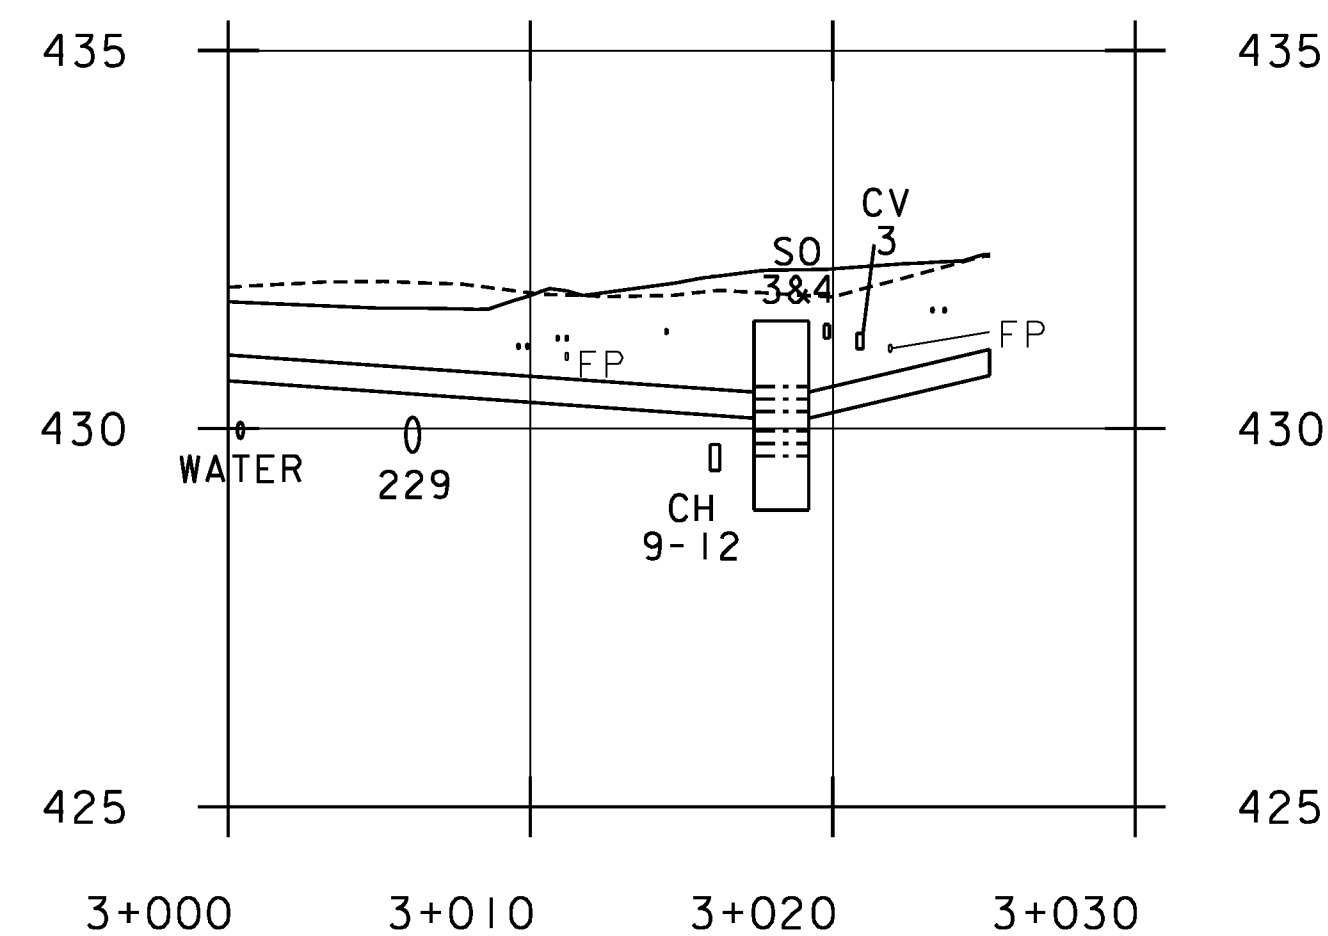

### CVPS (T) BETWEEN DUCTS TD4 & TD5

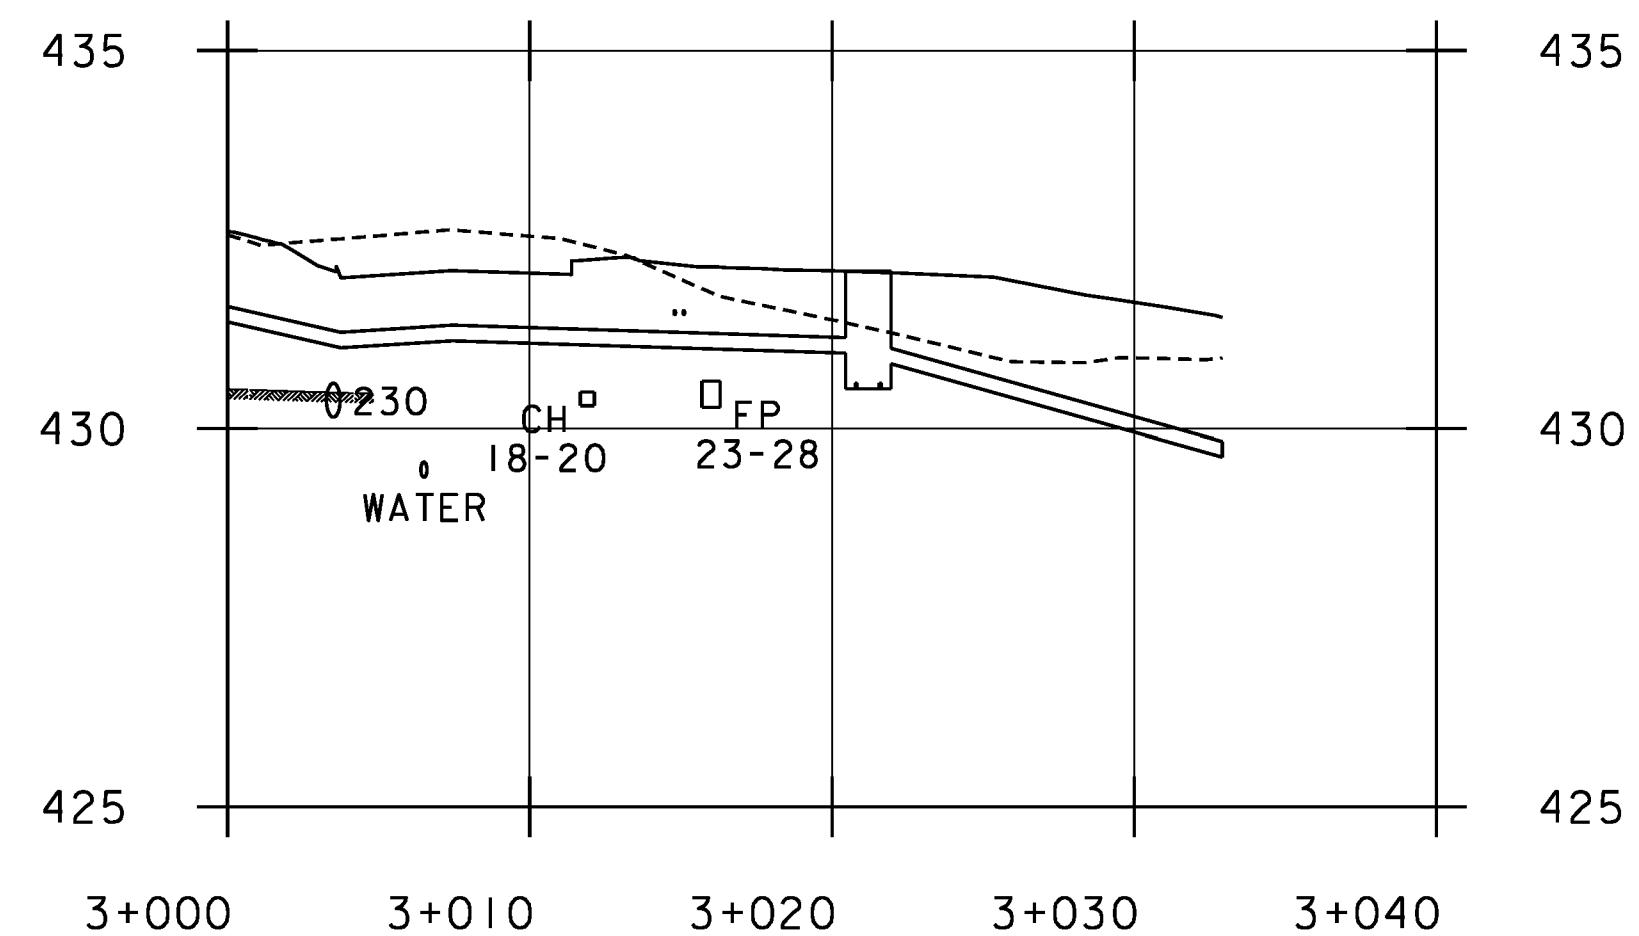

### CVPS (S) BETWEEN DUCTS TD8 & TC2

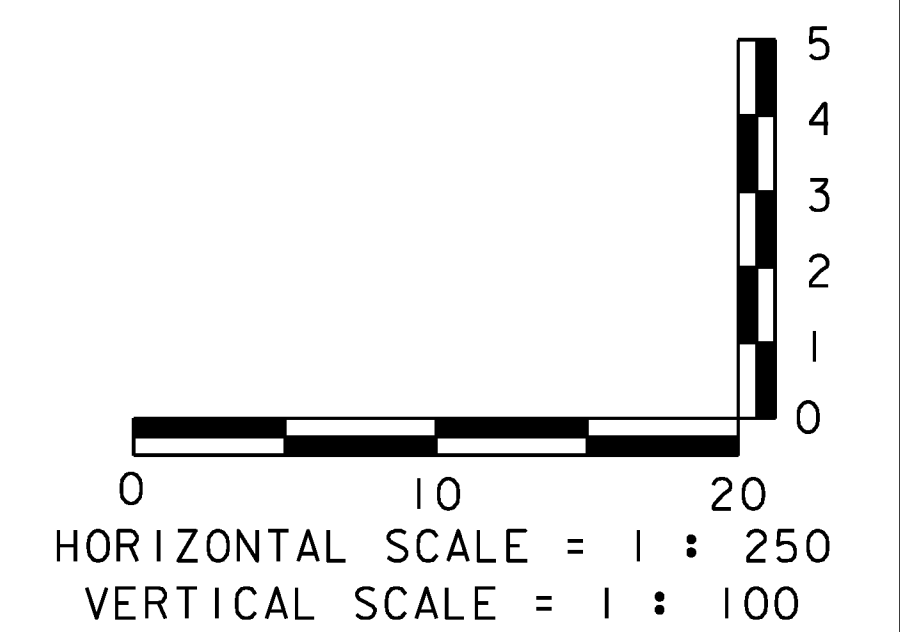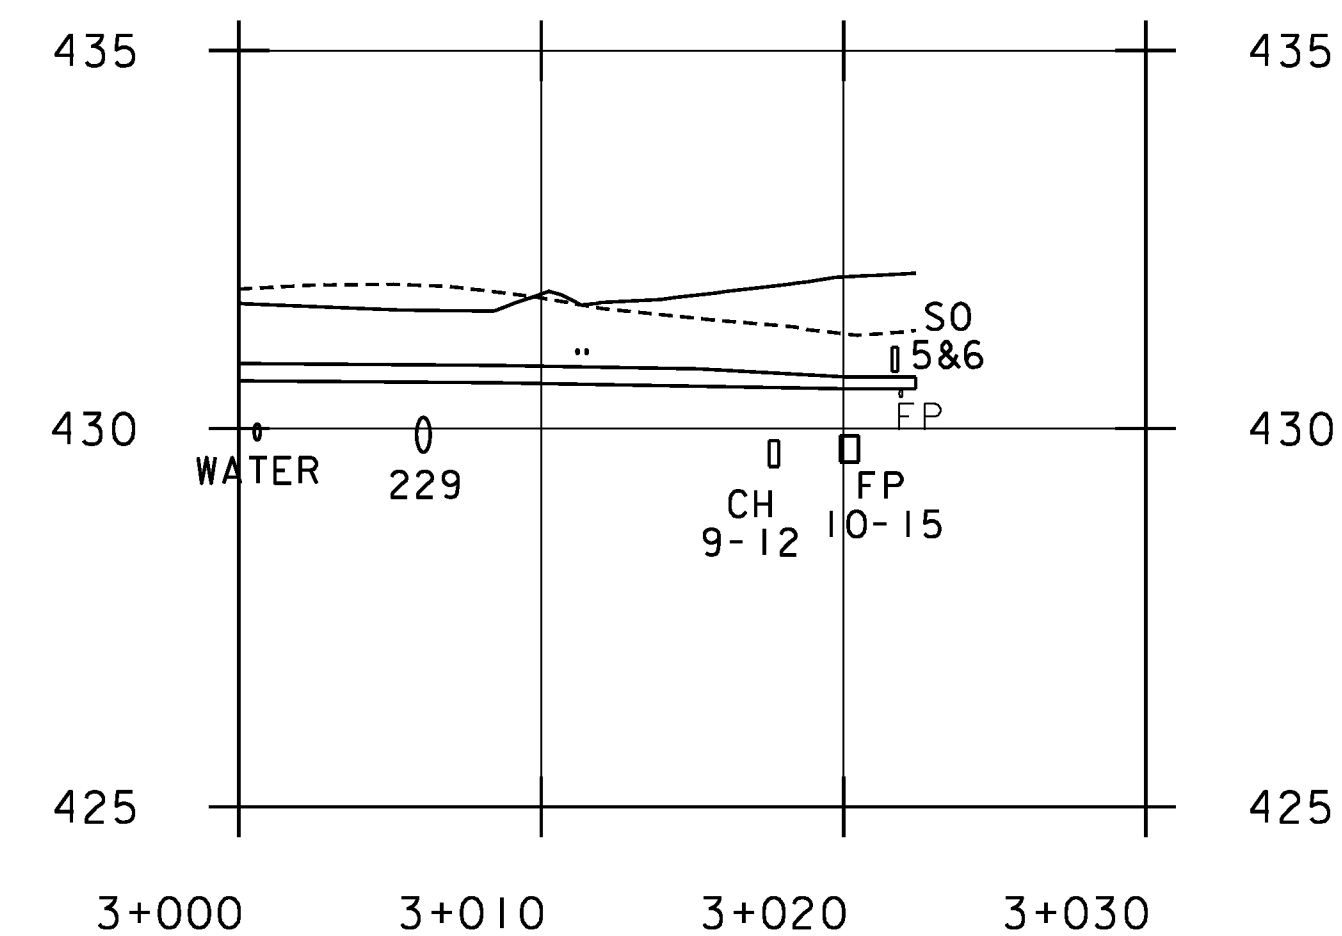

- EXISTING GRADE
- FINISH GRADE
- (T) CVPS 3-PHASE
- (S) CVPS SINGLE PHASE

**REPLACEMENT SHEETS  
ISSUED 02/24/2012**

## INTERSECTION 3 BETWEEN DUCTS 4&5,8&13



PROJECT NAME: DANVILLE  
PROJECT NUMBER: F EGC 028-3(32)

FILE NAME: ...\\100 det\_profiles.pff  
DESIGN SUPERVISOR: GARY SANTY  
DESIGNED BY: STANTEC  
DUCT BANK PROFILES DTP-06

PLOT DATE: 2/24/2012  
DRAWN BY: STANTEC  
CHECKED BY: STANTEC  
SHEET 215E OF 306