





SOVERNET BETWEEN DUCTS TD4 & TD5

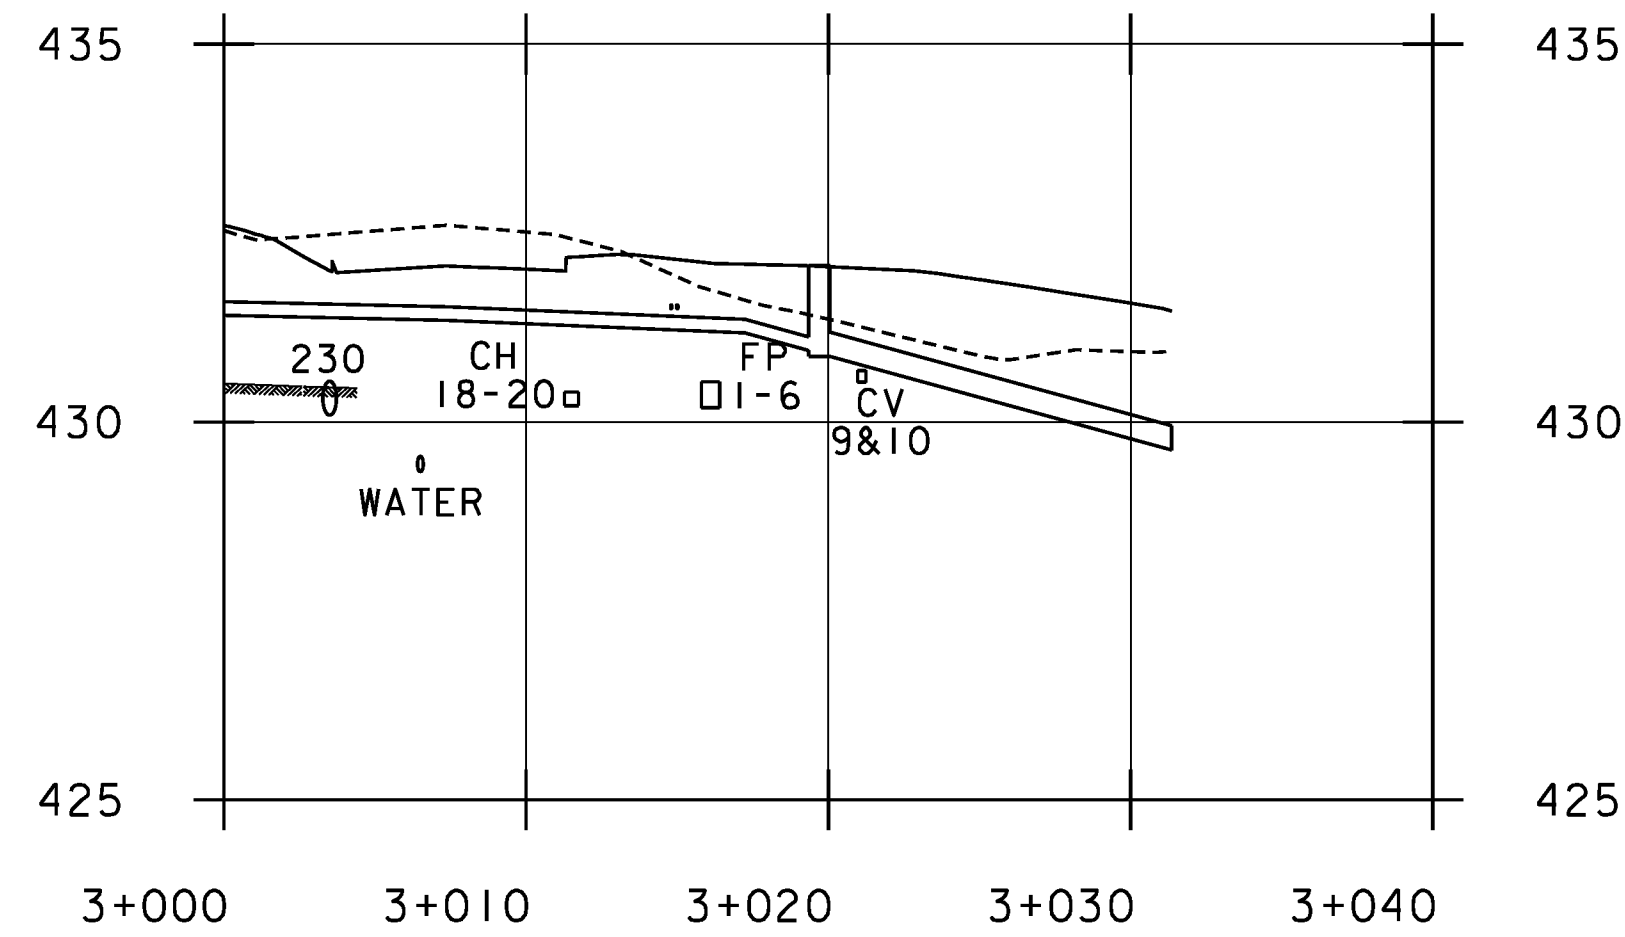

CHARTER BETWEEN DUCTS TD13 & TD14

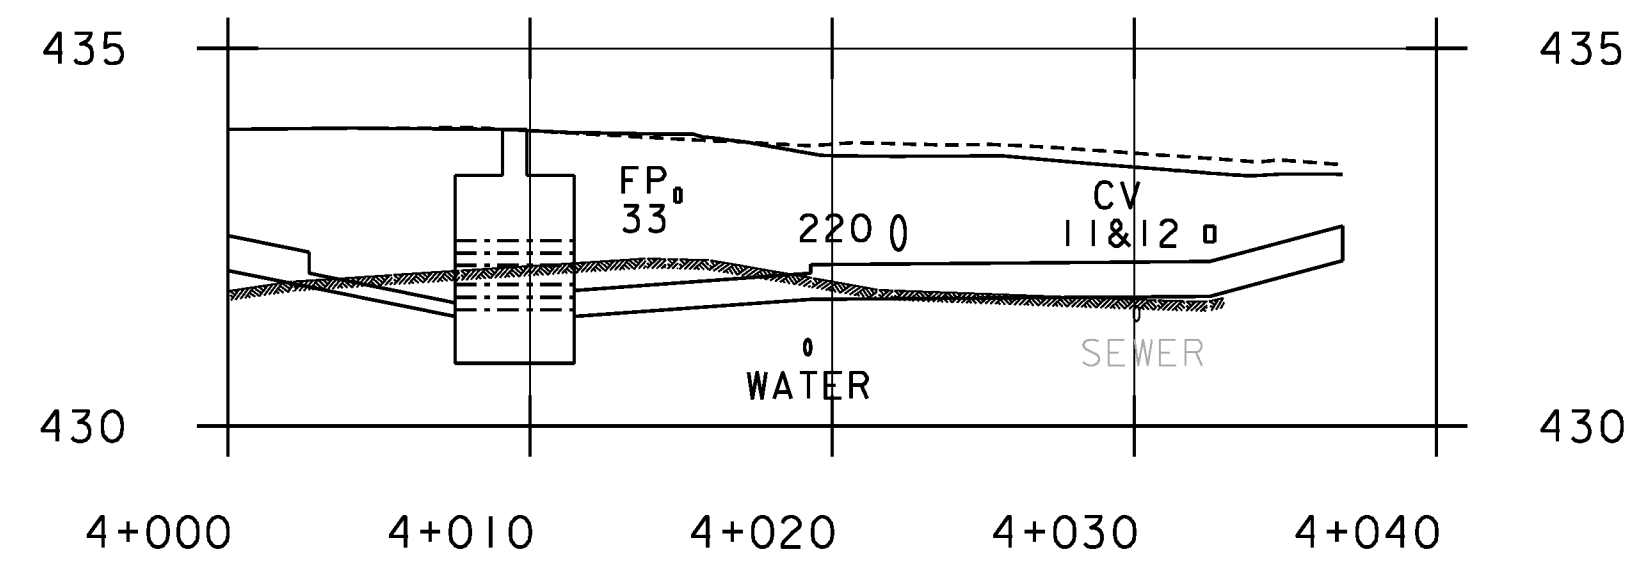

FAIRPOINT BETWEEN DUCTS TD13 & TD14

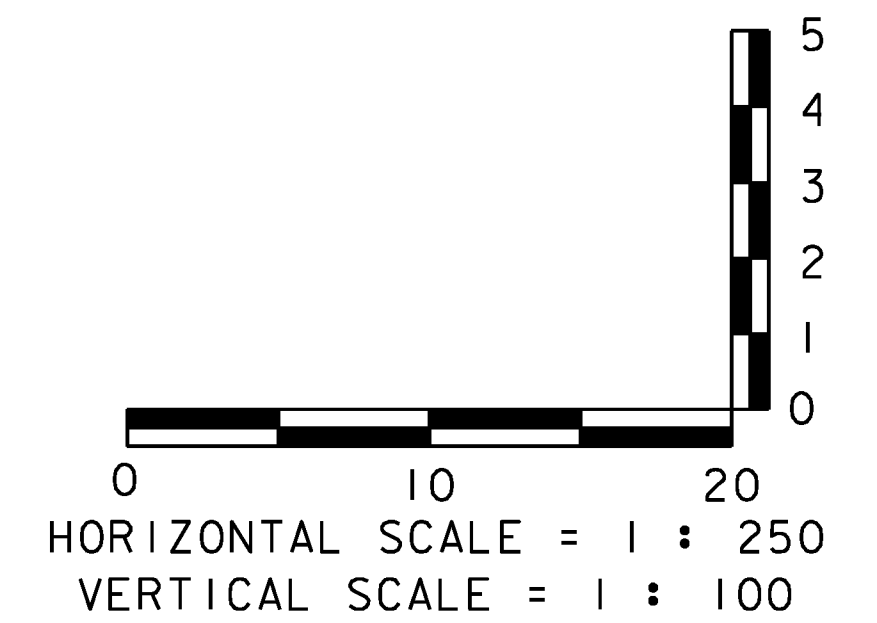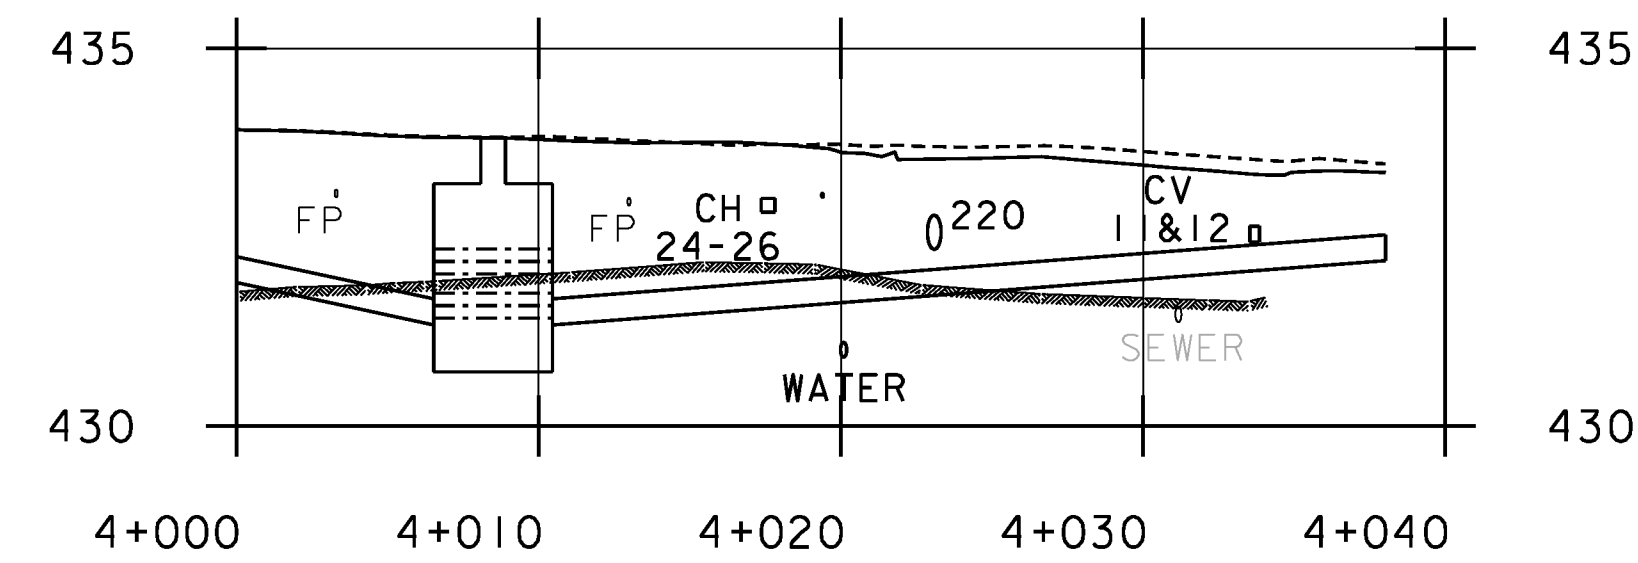

- EXISTING GRADE
- FINISH GRADE
- (T) CVPS 3-PHASE
- (S) CVPS SINGLE PHASE

**REPLACEMENT SHEETS
ISSUED 02/24/2012**

INTERSECTION 4 BETWEEN DUCTS 13&14



PROJECT NAME: DANVILLE
PROJECT NUMBER: F EGC 028-3(32)

FILE NAME: ...\\100 det_profiles.pff
DESIGN SUPERVISOR: GARY SANTY
DESIGNED BY: STANTEC
DUCT BANK PROFILES DTP-07

PLOT DATE: 2/24/2012
DRAWN BY: STANTEC
CHECKED BY: STANTEC
SHEET 215F OF 306